

FEE \$	10.00
TCP \$	500.00
SIF \$	292.00

PLANNING CLEARANCE
 (Single Family Residential and Accessory Structures)
Community Development Department

BLDG PERMIT NO. _____

Building Address 465 Dodge St. No. of Existing Bldgs 0 No. Proposed 1
 Parcel No. 2943-162-08-016 Sq. Ft. of Existing Bldgs _____ Sq. Ft. Proposed _____
 Subdivision Grand Meadows North Sq. Ft. of Lot / Parcel 8,247
 Filing 2 Block 2 Lot 14 Sq. Ft. Coverage of Lot by Structures & Impervious Surface
 (Total Existing & Proposed) 4,998

OWNER INFORMATION:

Name Grace Homes
 Address 784 Valley Ct.
 City / State / Zip Grand Jct. Co. 81505

DESCRIPTION OF WORK & INTENDED USE:

- New Single Family Home (*check type below)
 Interior Remodel Addition
 Other (please specify): _____

APPLICANT INFORMATION:

Name Grace Homes
 Address 784 Valley Ct.
 City / State / Zip G.J. Co. 81505
 Telephone 523-5555

***TYPE OF HOME PROPOSED:**

- Site Built Manufactured Home (UBC)
 Manufactured Home (HUD)
 Other (please specify): _____

NOTES: _____

REQUIRED: One plot plan, on 8 1/2" x 11" paper, showing all existing & proposed structure location(s), parking, setbacks to all property lines, ingress/egress to the property, driveway location & width & all easements & rights-of-way which abut the parcel.

THIS SECTION TO BE COMPLETED BY COMMUNITY DEVELOPMENT DEPARTMENT STAFF	
ZONE <u>RMF-5</u>	Maximum coverage of lot by structures <u>60%</u>
SETBACKS: Front <u>20'</u> from property line (PL)	Permanent Foundation Required: YES <u>X</u> NO _____
Side <u>5'</u> from PL Rear <u>25'</u> from PL	Parking Requirement <u>2</u>
Maximum Height of Structure(s) <u>35'</u>	Special Conditions _____
Voting District <u>C</u> Driveway _____	Location Approval <u>W</u> (Engineer's Initials)


Modifications to this Planning Clearance must be approved, in writing, by the Community Development Department. The structure authorized by this application cannot be occupied until a final inspection has been completed and a Certificate of Occupancy has been issued, if applicable, by the Building Department (Section 305, Uniform Building Code).

I hereby acknowledge that I have read this application and the information is correct; I agree to comply with any and all codes, ordinances, laws, regulations or restrictions which apply to the project. I understand that failure to comply shall result in legal action, which may include but not necessarily be limited to non-use of the building(s).

Applicant Signature Monica Kutas Agent Date 5/26/04
 Department Approval NAC Janye Hall Date 7/6/04

Additional water and/or sewer tap fee(s) are required:	YES <u>X</u>	NO _____	W/O No. <u>17432</u>
Utility Accounting <u>D Overholt</u>	Date _____		

VALID FOR SIX MONTHS FROM DATE OF ISSUANCE (Section 2.2.C.1 Grand Junction Zoning & Development Code)
 (White: Planning) (Yellow: Customer) (Pink: Building Department) (Goldenrod: Utility Accounting)

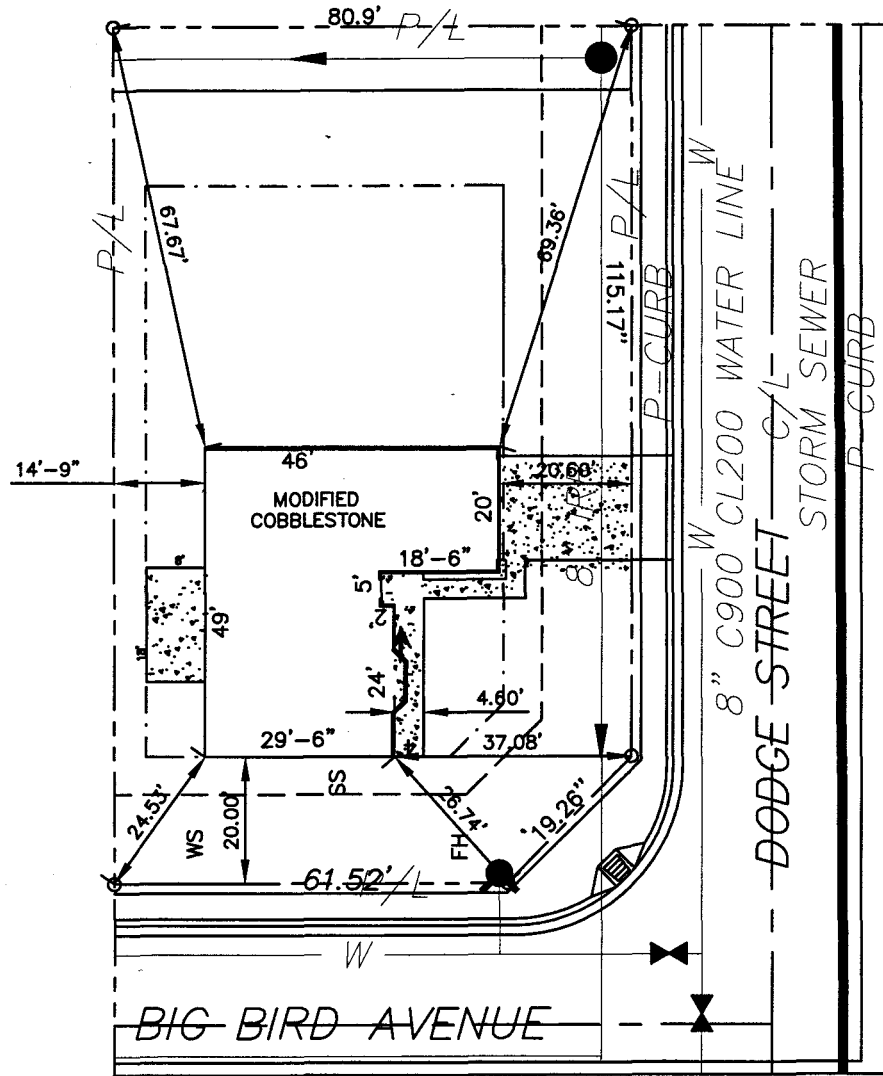

7/7/04
 ACCEPTED *C. J. Hall*
 ANY CHANGE OF SETBACKS MUST BE APPROVED BY THE CITY PLANNING DEPT. IT IS THE APPLICANT'S RESPONSIBILITY TO PROPERLY LOCATE AND IDENTIFY EASEMENTS AND PROPERTY LINES.

GROSS SQ FT = 1,342 SF
 IMPERVIOUS SQ FT = 4,998 SF
 LOT 16 BLK 2 PARCEL = 8,244 SF



drive on 7/7/04

Scale = 1' = 30'

GRAND MEADOWS-SO. SUBDIVISION
 465 Dodge St.
 Lot 16 Block 2 23-FEB-04
 24-JUNE-04
 6-JULY-04