| FEE\$ | 10 0 | 0 |
|--------|-------------|---------------|
| TCP\$ | <i>500.</i> | \mathcal{C} |
| SIF \$ | 292 | (Ŋ) |

(White: Planning)

(Yellow: Customer)

PLANNING CLEARANCE

(Single Family Residential and Accessory Structures)

Community Development Department

| 0 |
|---|
| |




Your Bridge to a Better Community

(Goldenrod: Utility Accounting)

| BLDG ADDRESS 1940 FLORA CT | SQ. FT. OF PROPOSED BLDGS/ADDITION 2,000 | | |
|---|--|--|--|
| TAX SCHEDULE NO. 2945-121-36-004 | SQ. FT. OF EXISTING BLDGS | | |
| SUBDIVISION FLORA | TOTAL SQ. FT. OF EXISTING & PROPOSED 2,000 | | |
| FILING BLK 2 LOT 4 (1) OWNER <u>JRJ BUILDERS FNC</u> (1) ADDRESS <u>680 SEQUEL</u> <u>eT</u> (1) TELEPHONE <u>434-5989</u> | NO. OF DWELLING UNITS: Before: After: this Construction NO. OF BUILDINGS ON PARCEL Before: After: this Construction USE OF EXISTING BUILDINGS | | |
| (2) APPLICANT OWNER | DESCRIPTION OF WORK & INTENDED USE STREET FAM. RE | | |
| (2) ADDRESS | TYPE OF HOME PROPOSED: Site Built Manufactured Home (UBC) Manufactured Home (HUD) Other (please specify) | | |
| | all existing & proposed structure location(s), parking, setbacks to all cation & width & all easements & rights-of-way which abut the parcel. | | |
| THIS SECTION TO BE COMPLETED BY CO ZONE from property line (PL) SETBACKS: Front from property line (PL) or from center of ROW, whichever is greater Side from PL, Rear from P Maximum Height 3.5 | Parking Req'mt 2 | | |
| structure authorized by this application cannot be occup. Occupancy has been issued, if applicable, by the Buildin I hereby acknowledge that I have read this application and | ved, in writing, by the Community Development Department. The ied until a final inspection has been completed and a Certificate of g Department (Section 305, Uniform Building Code). The information is correct; I agree to comply with any and all codes, to the project. I understand that failure to comply shall result in legal | | |
| action, which may include but not recessarily be limited | | | |
| Applicant Signature | Date 3-47-04 | | |
| Department Approval H. Baylon Head | erso Date 3-29-04 | | |
| Additional water and/or sewer tap fee(s) are required: | YES NO W/O NOM 15 | | |
| Utility Accounting (1544) | Date 329 0 | | |
| VALID FOR SIX MONTHS FROM DATE OF ISSUANCE (Section 9-3-2C Grand Junction Zoning & Development Code) | | | |

(Pink: Building Department)

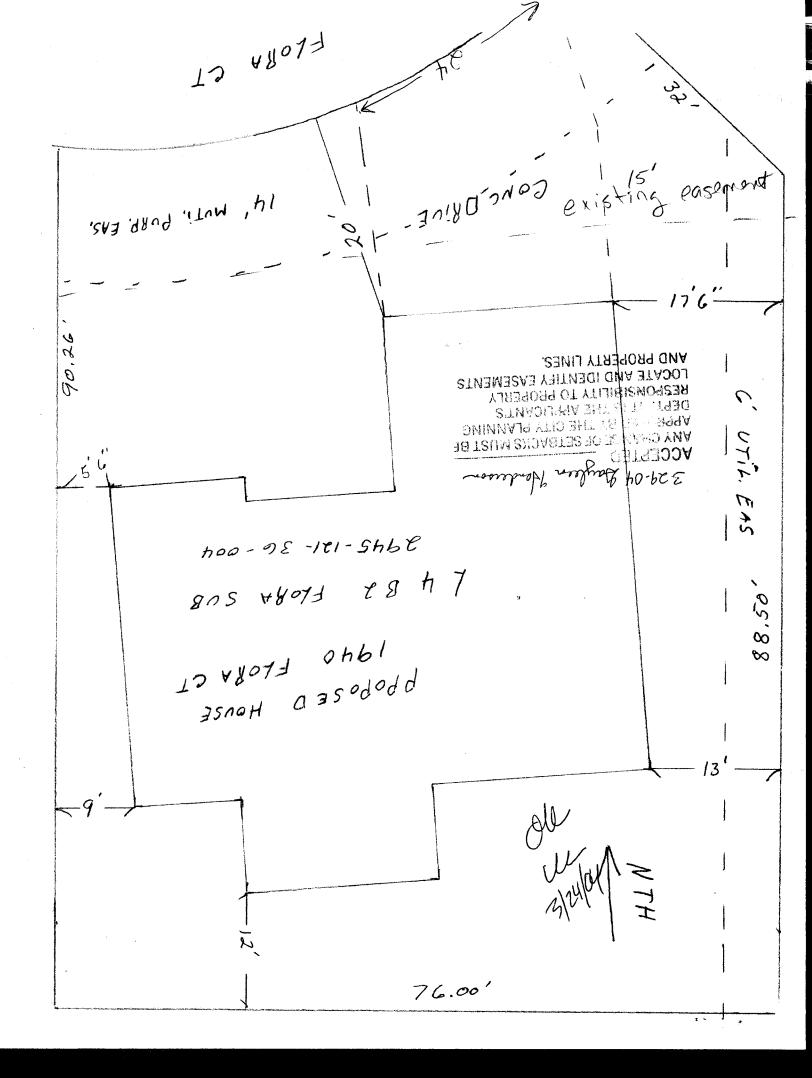

,00.96 PPOPOSED HOUSE 1940 FLORA CT 14 B2 FLORA SUB 2945-121-36-004 UTIL. EAS 329-04 Dayleen Henderson JE OF SETBACKS MUST BE BY THE CITY PLANNING DEPT. IT THE APPLICANT'S ĺ, RESPONSIBILITY TO PROPERLY LOCATE AND IDENTIFY EASEMENTS AND PROPERTY LINES. CONC. DRIVE - 18 14' MUTI. PURP. EAS. promosod fultdixa FLORA CT