FEE\$.10.00
TCP\$	1000.00
SIE ¢	292 00

(White: Planning)

(Yellow: Customer)

PLANNING CLEARANCE

\cap	
B	

BLDG PERMIT NO.


(Single Family Residential and Accessory Structures)


Community Development Department

Building Address 549 Hoover Ct	No. of Existing Bldgs No. Proposed
Parcel No. <u>2943-094-78-002</u>	Sq. Ft. of Existing Bldgs #### Sq. Ft. Proposed ###
Subdivision FRUIT VAILE ESTATES	Sq. Ft. of Lot / Parcel 1234 ACRE
Filling/ Block/ Lot2	Sq. Ft. Coverage of Lot by Structures & Impervious Surface (Total Existing & Proposed)/BOO
OWNER INFORMATION:	
Name DAUE WENS	DESCRIPTION OF WORK & INTENDED USE:
Address 694 2913 Kd	New Single Family Home (*check type below) Interior Remodel Addition Other (please specify):
City/State/Zip GNO VCT Co B1504	Unter (please specify).
APPLICANT INFORMATION:	*TYPE OF HOME PROPOSED:
Name	Site Built Manufactured Home (UBC) Manufactured Home (HUD)
Traine	Other (please specify):
Address	
City / State / Zip	NOTES:
Telephone	
REQUIRED: One plot plan, on 8 1/2" x 11" paper, showing all e.	xisting & proposed structure location(s), parking, setbacks to all
	on & width & all easements & rights-of-way which abut the parcel.
property lines, ingress/egress to the property, driveway location	
property lines, ingress/egress to the property, driveway location THIS SECTION TO BE COMPLETED BY COMI	MUNITY DEVELOPMENT DEPARTMENT STAFF
property lines, ingress/egress to the property, driveway location	on & width & all easements & rights-of-way which abut the parcel.
THIS SECTION TO BE COMPLETED BY COMP	MUNITY DEVELOPMENT DEPARTMENT STAFF Maximum coverage of lot by structures
THIS SECTION TO BE COMPLETED BY	MUNITY DEVELOPMENT DEPARTMENT STAFF Maximum coverage of lot by structures
THIS SECTION TO BE COMPLETED BY	MUNITY DEVELOPMENT DEPARTMENT STAFF Maximum coverage of lot by structures
THIS SECTION TO BE COMPLETED BY	MUNITY DEVELOPMENT DEPARTMENT STAFF Maximum coverage of lot by structures 500 Permanent Foundation Required: YES NO Parking Requirement Special Conditions Engineered Foundation Required
THIS SECTION TO BE COMPLETED BY	MUNITY DEVELOPMENT DEPARTMENT STAFF Maximum coverage of lot by structures
THIS SECTION TO BE COMPLETED BY	MUNITY DEVELOPMENT DEPARTMENT STAFF Maximum coverage of lot by structures 500 Permanent Foundation Required: YES NO Parking Requirement Required: YES NO Parking Requirement Required Required Required Required Required In writing, by the Community Development Department. The Intil a final inspection has been completed and a Certificate of Partment (Section 305, Uniform Building Code). Information is correct; I agree to comply with any and all codes, a project. I understand that failure to comply shall result in legal
THIS SECTION TO BE COMPLETED BY	MUNITY DEVELOPMENT DEPARTMENT STAFF Maximum coverage of lot by structures 500 Permanent Foundation Required: YES NO Parking Requirement Required: YES NO Parking Requirement Required Required Required Required Required Required Required Required Required In writing, by the Community Development Department. The Intil a final inspection has been completed and a Certificate of Partment (Section 305, Uniform Building Code). Information is correct; I agree to comply with any and all codes, Project. I understand that failure to comply shall result in legal
THIS SECTION TO BE COMPLETED BY	MUNITY DEVELOPMENT DEPARTMENT STAFF Maximum coverage of lot by structures Permanent Foundation Required: YES NO Parking Requirement Special Conditions Engineered in writing, by the Community Development Department. The antil a final inspection has been completed and a Certificate of a partment (Section 305, Uniform Building Code). information is correct; I agree to comply with any and all codes, a project. I understand that failure to comply shall result in legal in-use of the building(s).
THIS SECTION TO BE COMPLETED BY	MUNITY DEVELOPMENT DEPARTMENT STAFF Maximum coverage of lot by structures
THIS SECTION TO BE COMPLETED BY	MUNITY DEVELOPMENT DEPARTMENT STAFF Maximum coverage of lot by structures 500 Permanent Foundation Required: YES NO Parking Requirement Special Conditions Engineered Required in writing, by the Community Development Department. The Intil a final inspection has been completed and a Certificate of Information is correct; I agree to comply with any and all codes, information is correct; I agree to comply shall result in legal in-use of the building(s). Date 10-26-04 Date 10-26-04

(Pink: Building Department)

(Goldenrod: Utility Accounting)

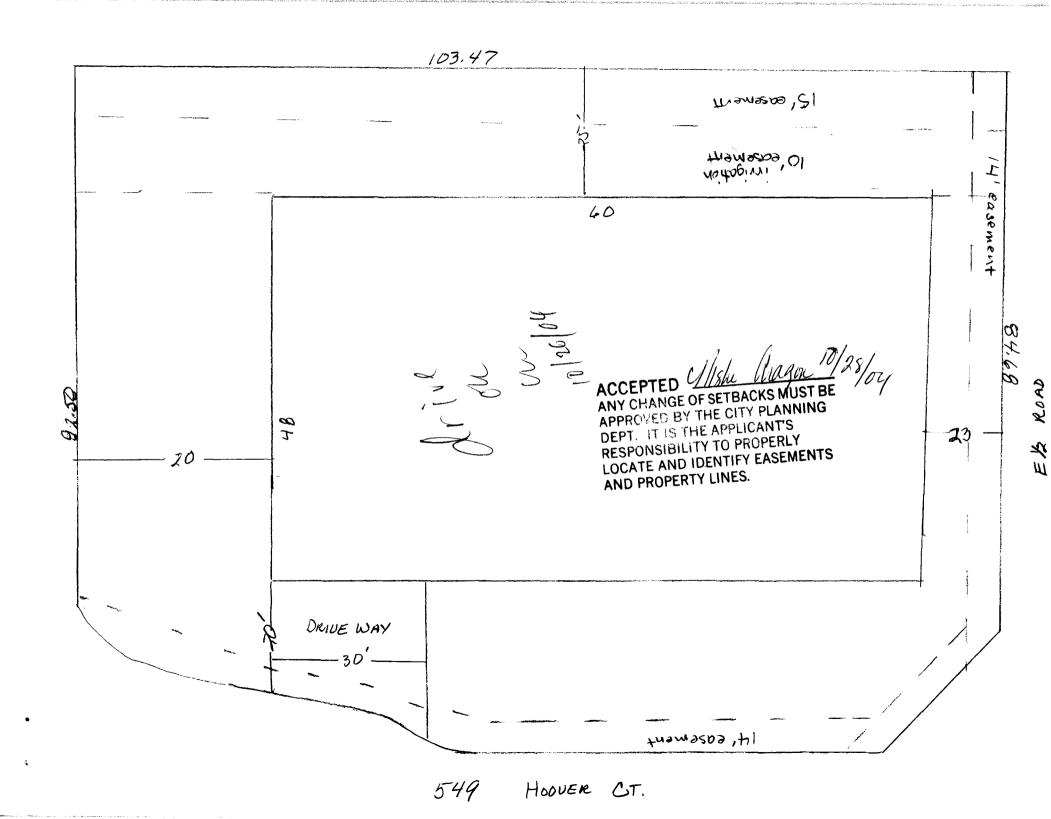

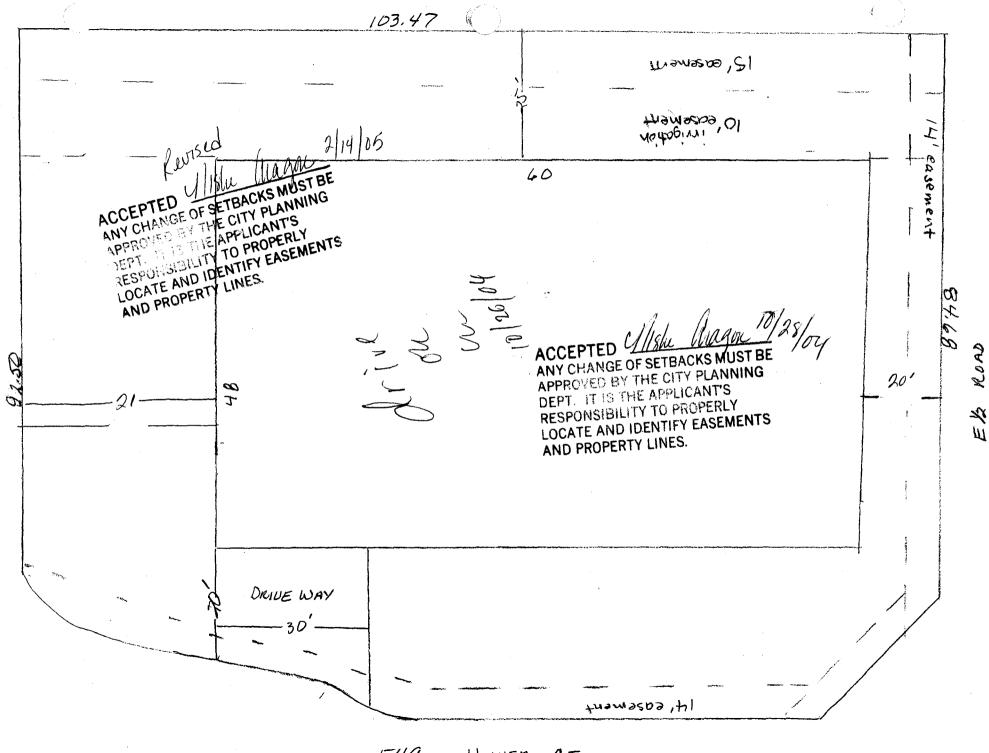

549 HOOVER CT.