

FEE \$ <u>10.00</u>
TCP \$ <u>0</u>
SIF \$ <u>292.00</u>

**PLANNING CLEARANCE**  
 (Single Family Residential and Accessory Structures)  
Community Development Department

BLDG PERMIT NO. \_\_\_\_\_



Your Bridge to a Better Community

BLDG ADDRESS 465 ~~462~~ Jo Alan Ct. SQ. FT. OF PROPOSED BLDGS/ADDITION 1656

TAX SCHEDULE NO. 2943-161-46-015 SQ. FT. OF EXISTING BLDGS N/A

SUBDIVISION Iles TOTAL SQ. FT. OF EXISTING & PROPOSED 1656

FILING \_\_\_\_\_ BLK 15 LOT 2 NO. OF DWELLING UNITS:  
 Before: 0 After: 1 this Construction

(1) OWNER Macy Mckim NO. OF BUILDINGS ON PARCEL  
 Before: 0 After: 1 this Construction

(1) ADDRESS 497 Meadowlark Way USE OF EXISTING BUILDINGS N/A

(1) TELEPHONE 241-2871 x 106 mes/rsc DESCRIPTION OF WORK & INTENDED USE New Single Family

(2) APPLICANT SAME TYPE OF HOME PROPOSED:  
 Site Built \_\_\_\_\_ Manufactured Home (UBC)  
 \_\_\_\_\_ Manufactured Home (HUD)  
 \_\_\_\_\_ Other (please specify) \_\_\_\_\_

(2) ADDRESS \_\_\_\_\_

(2) TELEPHONE \_\_\_\_\_

**REQUIRED: One plot plan, on 8 1/2" x 11" paper, showing all existing & proposed structure location(s), parking, setbacks to all property lines, ingress/egress to the property, driveway location & width & all easements & rights-of-way which abut the parcel.**

**THIS SECTION TO BE COMPLETED BY COMMUNITY DEVELOPMENT DEPARTMENT STAFF**

ZONE Rmf-5 Maximum coverage of lot by structures 60%

SETBACKS: Front 20' from property line (PL) Permanent Foundation Required: YES  NO \_\_\_\_\_  
 or \_\_\_\_\_ from center of ROW, whichever is greater

Side 5' from PL, Rear 25' from PL Parking Req'mt 2

Maximum Height 35' Special Conditions \_\_\_\_\_

CENSUS 0 TRAFFIC \_\_\_\_\_ ANN# \_\_\_\_\_

Modifications to this Planning Clearance must be approved, in writing, by the Community Development Department. The structure authorized by this application cannot be occupied until a final inspection has been completed and a Certificate of Occupancy has been issued, if applicable, by the Building Department (Section 305, Uniform Building Code).

I hereby acknowledge that I have read this application and the information is correct; I agree to comply with any and all codes, ordinances, laws, regulations or restrictions which apply to the project. I understand that failure to comply shall result in legal action, which may include but not necessarily be limited to non-use of the building(s).

Applicant Signature [Signature] Date 6/29/04

Department Approval [Signature] Date 7/1/04


Additional water and/or sewer tap fee(s) are required:	YES <input checked="" type="checkbox"/>	NO	W/O No. <u>17407</u>
Utility Accounting	<u>[Signature]</u>	Date	<u>7/1/04</u>

VALID FOR SIX MONTHS FROM DATE OF ISSUANCE (Section 9-3-2C Grand Junction Zoning & Development Code)

(White: Planning) (Yellow: Customer) (Pink: Building Department) (Goldenrod: Utility Accounting)

DATE

APPROVED

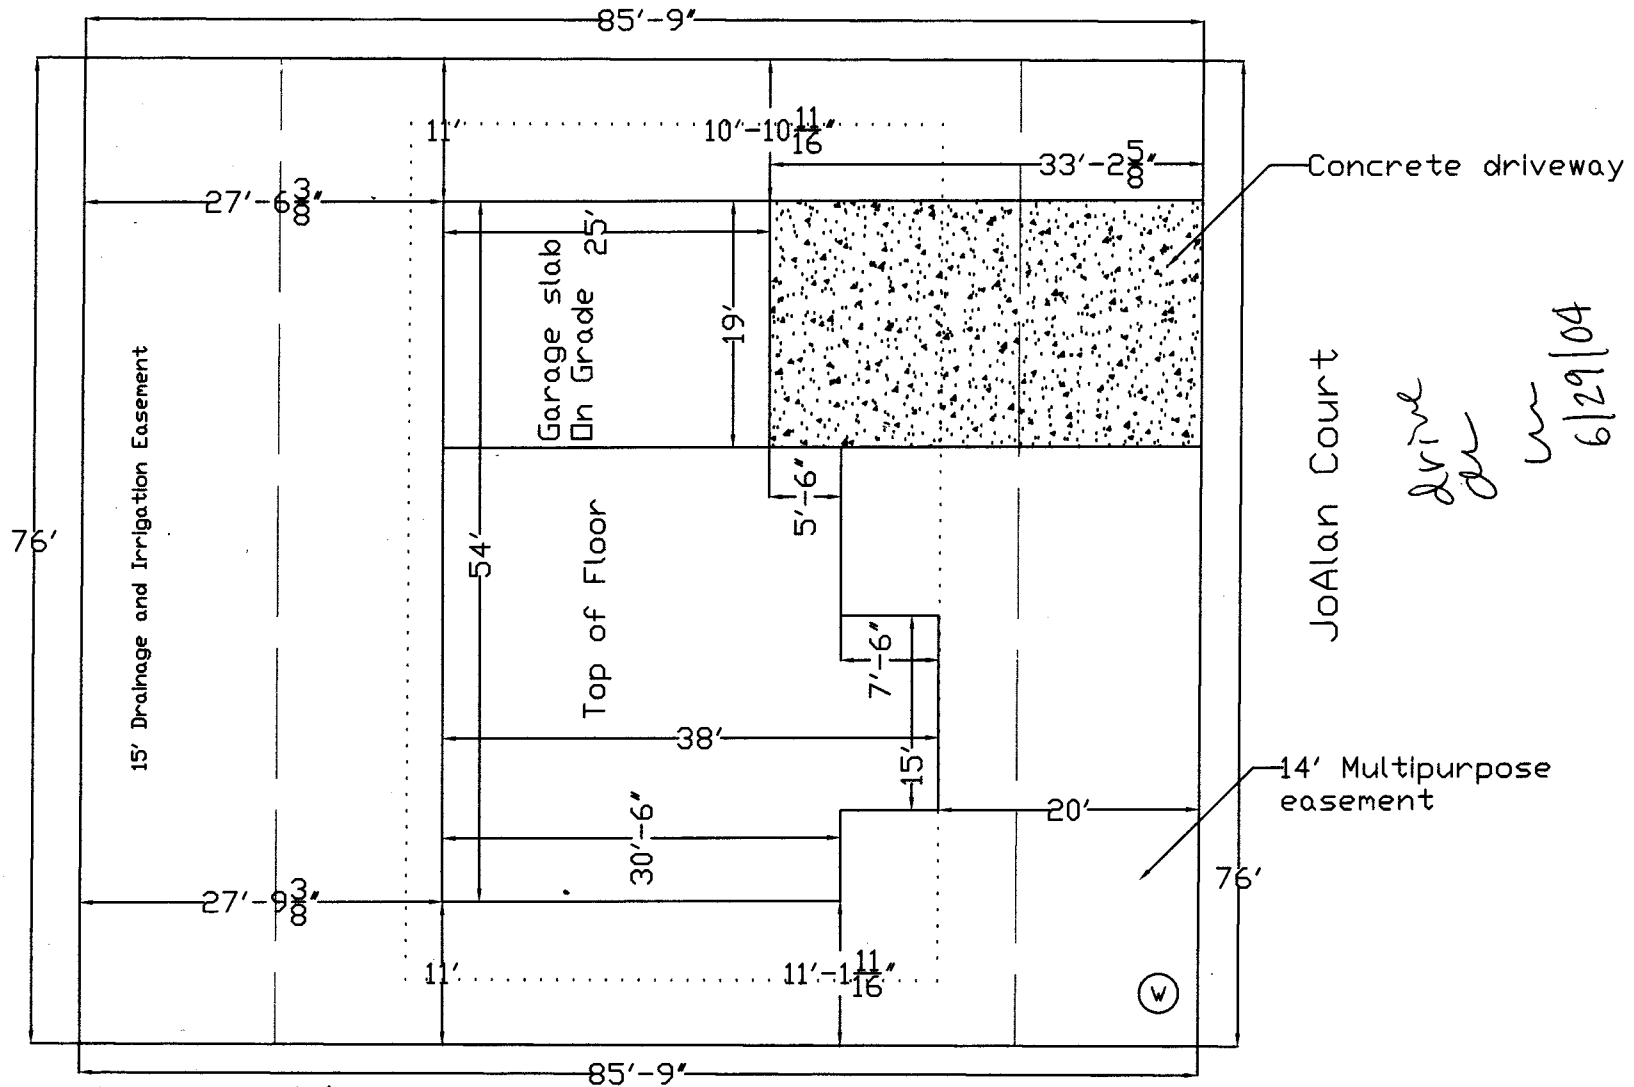

JoAlan Court

*drive  
du  
w  
6/29/04*

ACCEPTED *C. Taylor*  
 ANY CHANGE OF SETBACKS MUST BE APPROVED BY THE CITY PLANNING DEPT. IT IS THE APPLICANT'S RESPONSIBILITY TO PROPERLY LOCATE AND IDENTIFY EASEMENTS AND PROPERTY LINES.

	McKim Residence	
	465 JoAlan	
Lot 6 Block 2	Iles Subdivision	SQ.FT. 6517
	SCALE	Housing Resources