
FEE \$ 10 00 PLANNING CLEAR	BLDG PERMIT NO.
TCP \$Non e(Single Family Residential and AccessSIF \$292.00Community Development	
BLDG ADDRESS 453 Larry's Meadow SQ. F	T. OF PROPOSED BLDGS/ADDITION 1702
TAX SCHEDULE NO. 2943-152-94-0030. F	T. OF EXISTING BLDGS
SUBDIVISION Summit Meadows WestTOTAL	SQ. FT. OF EXISTING & PROPOSED 1702
(1) OWNER <u>Zeck + Associates, LLC</u> (1) ADDRESS <u>P.O. Box 550</u> (1) TELEPHONE (970) 858-0178 (2) APPLICANT <u>Zeck + Associates, LLC</u> TYPE	F DWELLING UNITS: After:
THIS SECTION TO BE COMPLETED BY COMMUN ZONE \underline{M} \underline{M} \underline{J} \underline{J} from property line (PL) orfrom center of ROW, whichever is greater Side $\underline{5'}$ from PL, Rear \underline{J} $\underline{5'}$ from PL Maximum Height $\underline{35'}$	ITY DEVELOPMENT DEPARTMENT STAFF ** Maximum coverage of lot by structures <u>(l0 ?0</u>) Permanent Foundation Required: YES X_NO NO Parking Req'mt <u>2</u> Special Conditions <u>Engineered</u> <u>foon chaftern</u> CENSUS TRAFFICANNX#

Modifications to this Planning Clearance must be approved, in writing, by the Community Development Department. The structure authorized by this application cannot be occupied until a final inspection has been completed and a Certificate of Occupancy has been issued, if applicable, by the Building Department (Section 305, Uniform Building Code).

I hereby acknowledge that I have read this application and the information is correct; I agree to comply with any and all codes, ordinances, laws, regulations or restrictions which apply to the project. I understand that failure to comply shall result in legal action, which may include but not necessarily be limited to non-use of the building(s).

(White: Planning) (Yellow: Customer) (Pink: Building D	epartment)	(Goldenrod: Utility Accounting)	
VALID FOR SIX MONTHS FROM DATE OF ISSUANCE (Section 9-3-2	2C Grand Junc	tion Zoning & Development Code)	
Utility Accounting attaches	Date	4/22/04	
Additional water and/or sewer tap fee(s) are required: YES	NO	WO MOLLID COUSI	KD:
Department Approval NAU/Khi (Magaci	Date	4/22/04	
		1/0-1-1	
Applicant Signature	Date	4-12-04	

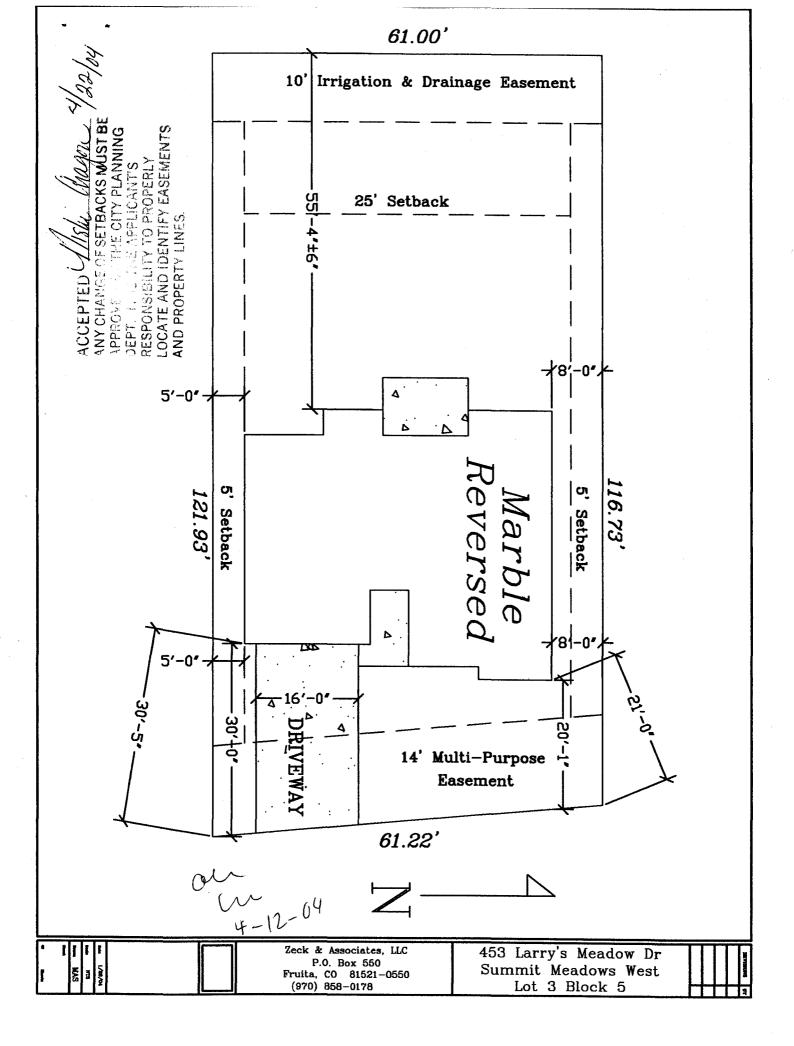

. . .