
| 9 1 A AA | | |
|---|--|---|
| FEE\$ /0 00 | PLANNING CLEA | RANCE BLDG PERMIT NO. |
| TCP\$ NONE | (Single Family Residential and A | ccessory Structures) |
| SIF\$ 292 00 | Community Developme | nt Department (_Q) |
| | and the second sec | Your Bridge to a Better Community |
| Building Address | Hol Larry's Meadow Dr. | No. of Existing Bldgs Proposed/ |
| Parcel No. <u>2943-152-94-008</u> Sq. Ft. of Existing Bldgs <u>Proposed</u> <u>1765</u> | | |
| Subdivision <u>Sun</u> | mit Meadouss West | Sq. Ft. of Lot / Parcel |
| | | Sq. Ft. Coverage of Lot by Structures & Impervious Surface (Total Existing & Proposed) |
| OWNER INFORMATION: | | DESCRIPTION OF WORK & INTENDED USE: |
| Name <u>click + Associates, LLC</u> | | New Single Family Home (*check type below) |
| Address <u>P.O.</u> | Box 550 | Interior Remodel Addition |
| City / State / Zip 🛛 🗜 | ruita, CO 81521 | Other (please specify): *TYPE OF HOME PROPOSED: |
| APPLICANT INFORMATION: | | |
| Name Zeck | + Associates, LLC | Site Built Manufactured Home (UBC) Manufactured Home (HUD) Other (please specify): |
| Address <u>P.O. Box 550</u> | | |
| City/State/Zip Fruita, CO 81521 NOTES: | | |
| Telephone (970) 858-0178 | | |
| REQUIRED: One plot plan, on 8 ½" x 11" paper, showing all existing & proposed structure location(s), parking, setbacks to all property lines, ingress/egress to the property, driveway location & width & all easements & rights-of-way which abut the parcel. | | |
| | | |
| property lines, ingress | /egress to the property, driveway location | |
| property lines, ingress | /egress to the property, driveway location TO BE COMPLETED BY COM | on & width & all easements & rights-of-way which abut the parcel. MUNITY DEVELOPMENT DEPARTMENT STAFF 599 イェム グレ |
| property lines, ingress THIS SEC ZONE | Vegress to the property, driveway location CTION TO BE COMPLETED BY COM 5 | on & width & all easements & rights-of-way which abut the parcel. MUNITY DEVELOPMENT DEPARTMENT STAFF Maximum coverage of lot by structures |
| property lines, ingress | Area from property, driveway location CTION TO BE COMPLETED BY COM 5 201 from property line (PL) | on & width & all easements & rights-of-way which abut the parcel. MUNITY DEVELOPMENT DEPARTMENT STAFF 599 イェム グレ |
| property lines, ingress THIS SEC ZONE \mathcal{EMF}^{-1} SETBACKS: Front Side5' | Vegress to the property, driveway location CTION TO BE COMPLETED BY COM 5 20' from property line (PL) PL Rear <u>25'</u> from PL | Image: Second Structures Image: Second S |
| property lines, ingress THIS SEC ZONE \mathcal{EMF}^{-1} SETBACKS: Front Side5' | Arrow the property, driveway location CTION TO BE COMPLETED BY COM 5 20^{\prime} from property line (PL) 10° PL Rear 25^{\prime} from PL tructure(s) 35^{\prime} | Image: Special Conditions Englishing Englishis Englishing <td< th=""></td<> |
| property lines, ingress THIS SEC ZONE \mathcal{EMF}^{-1} SETBACKS: Front Side5' | Vegress to the property, driveway location CTION TO BE COMPLETED BY COM 5 20' from property line (PL) PL Rear <u>25'</u> from PL | A width & all easements & rights-of-way which abut the parcel. MUNITY DEVELOPMENT DEPARTMENT STAFF Maximum coverage of lot by structures Maximum coverage of lot by structures Permanent Foundation Required: YES NO Parking Requirement Special Conditions Engineered Foundation VLQUIREd |
| property lines, ingress FILS SEC ZONE | /egress to the property, driveway location CTION TO BE COMPLETED BY COM 6 20' from property line (PL) n PL Rear 25' from PL tructure(s) 35' Driveway Location Approval (Engineer's Initials) Planning Clearance must be approved by this application cannot be occupied | A width & all easements & rights-of-way which abut the parcel. MUNITY DEVELOPMENT DEPARTMENT STAFF Maximum coverage of lot by structures Maximum coverage of lot by structures Permanent Foundation Required: YES NO Parking Requirement Special Conditions Engineered Foundation VLQUIREd |
| property lines, ingress Image: THIS SEC ZONE <i>RMF</i> SETBACKS: Front Side from Maximum Height of S Voting District Modifications to this F structure authorized to Occupancy has been I hereby acknowledge ordinances, laws, regular | /egress to the property, driveway location CTION TO BE COMPLETED BY COM 6 20' from property line (PL) PL Rear 25' Driveway Location Approval (Engineer's Initials) Planning Clearance must be approved y this application cannot be occupied issued, if applicable, by the Building D that I have read this application and the | Image: Second Structures State Stat |
| property lines, ingress Image: THIS SEC ZONE <i>RMF</i> SETBACKS: Front Side from Maximum Height of S Voting District Modifications to this F structure authorized to Occupancy has been I hereby acknowledge ordinances, laws, regular | /egress to the property, driveway location CTION TO BE COMPLETED BY COM | Image: Second Structures State Stat |
| property lines, ingress Image: THIS SEC ZONE <i>RMF</i> SETBACKS: Front Side Side from Maximum Height of S Voting District Modifications to this F structure authorized to Occupancy has been I hereby acknowledge ordinances, laws, regraction, which may inc | Arrow of the property, driveway location CTION TO BE COMPLETED BY COM <u>5</u> <u>20'</u> from property line (PL) PL Rear <u>25'</u> from PL tructure(s) <u>35'</u> Driveway Location Approval (Engineer's Initials Planning Clearance must be approved by this application cannot be occupied issued, if applicable, by the Building D that I have read this application and the ulations or restrictions which apply to the lude but not necessarily be limited to not Common States of the state | An & width & all easements & rights-of-way which abut the parcel. MUNITY DEVELOPMENT DEPARTMENT STAFF Maximum coverage of lot by structures <u><u>UO</u><u>70</u> Permanent Foundation Required: YES <u>NO</u><u></u> Parking Requirement <u>2</u> Special Conditions <u>Engineered</u> <u>foundation</u> <u>VLQUIRED</u> in writing, by the Community Development Department. The until a final inspection has been completed and a Certificate of epartment (Section 305, Uniform Building Code). in information is correct; I agree to comply with any and all codes, e project. I understand that failure to comply shall result in legal on-use of the building(s).</u> |
| property lines, ingress Image: THIS SEC ZONE <i>RMF</i> SETBACKS: Front Side Side from Maximum Height of S Voting District Modifications to this F structure authorized to Occupancy has been I hereby acknowledge ordinances, laws, regulaction, which may inc Applicant Signature Department Approval | Arrow of the property, driveway location CTION TO BE COMPLETED BY COM <u>5</u> <u>20'</u> from property line (PL) PL Rear <u>25'</u> from PL tructure(s) <u>35'</u> Driveway Location Approval (Engineer's Initials Planning Clearance must be approved by this application cannot be occupied issued, if applicable, by the Building D that I have read this application and the ulations or restrictions which apply to the lude but not necessarily be limited to not Common States of the state | Image: Second Structures Image: Second S |
| property lines, ingress Image: THIS SEC ZONE <i>RMF</i> SETBACKS: Front Side Side from Maximum Height of S Voting District Modifications to this F structure authorized to Occupancy has been I hereby acknowledge ordinances, laws, regulaction, which may inc Applicant Signature Department Approval | /egress to the property, driveway location CTION TO BE COMPLETED BY COM 5 20'from property line (PL) PL Rear 25'from PL tructure(s) 35' Driveway Location Approval (Engineer's Initials Planning Clearance must be approved y this application cannot be occupied issued, if applicable, by the Building D that I have read this application and the ulations or restrictions which apply to the Jude but not pecessarily be limited to not peceessarily be limited to not pecessarily be limited to not peceessarily be be performed to not peceessarily beconot peceessarily be pecees to not peceessar | Image: Second Structures Image: Second S |

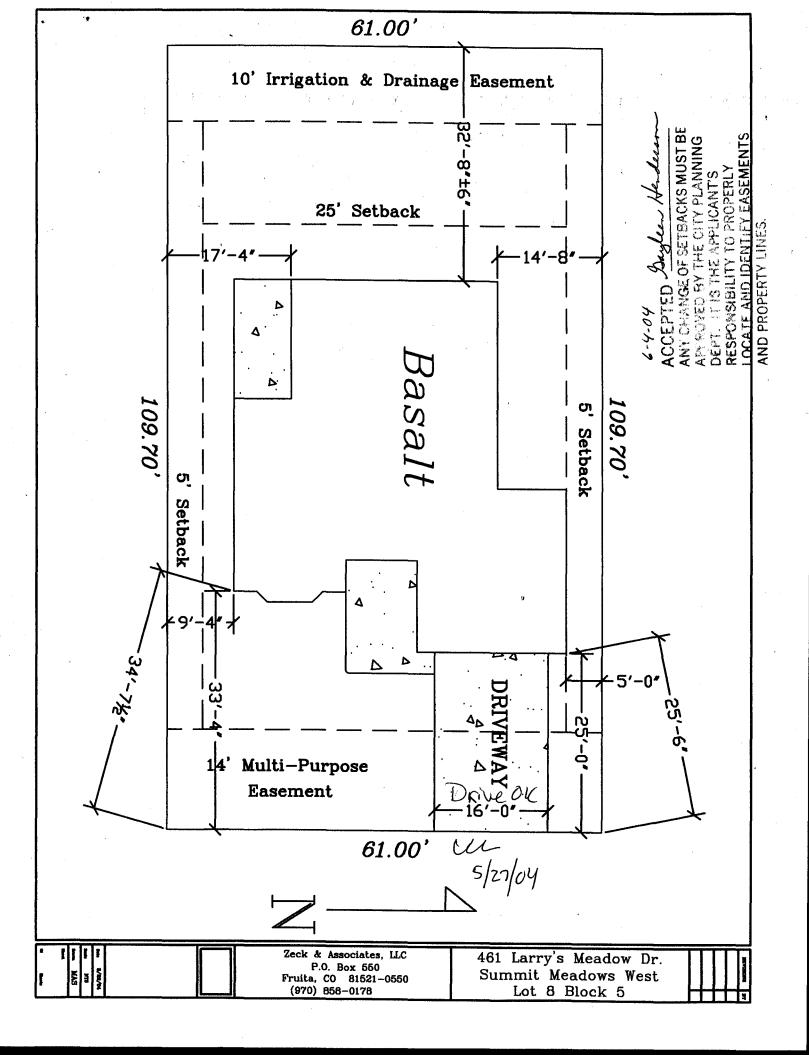

·