FEE\$	10.00
TCP\$	Ø
SIF \$	292 00

BLDG PERMIT N	О.
	S AND

Your Bridge to a Better Community

I LAMMING CLLANAMOL
(Single Family Residential and Accessory Structures
<b>Community Development Department</b>
(2)

BLDG ADDRESS 2500 MADISON AVE	SQ. FT. OF PROPOSED BLDGS/ADDITION #8+3 2317
TAX SCHEDULE NO. 2945-032-90-010	SQ. FT. OF EXISTING BLDGS
SUBDIVISION Colonail Heights	TOTAL SQ. FT. OF EXISTING & PROPOSED #8+3 23
FILINGBLK4LOT1D  (1) OWNER Date Cole  (1) ADDRESS 225 N. 7Th  (1) TELEPHONE 243 7711  (2) APPLICANT COLEY Company Bulus (2) ADDRESS 235 N. 7Th  (2) TELEPHONE 243 7111	NO. OF DWELLING UNITS:  Before: After: this Construction  NO. OF BUILDINGS ON PARCEL  Before: After: this Construction  USE OF EXISTING BUILDINGS A
	all existing & proposed structure location(s), parking, setbacks to all cation & width & all easements & rights-of-way which abut the parcel.
138 THIS SECTION TO BE COMPLETED BY C	OMMUNITY DEVELOPMENT DEPARTMENT STAFF ***
ZONE RMF-5	Maximum coverage of lot by structures
SETBACKS: Front from property line (PL) or from center of ROW, whichever is greater	Parking Regimt 7
Side 5 from PL, Rear 35 from F	
Maximum Height 35'	Special Conditions Otto Arm Engene  CENSUS TRAFFIC ANNX#
structure authorized by this application cannot be occup Occupancy has been issued, if applicable, by the Buildin I hereby acknowledge that I have read this application and	d the information is correct; I agree to comply with any and all codes, to the project. I understand that failure to comply shall result in legal to non-use of the building(s).
Department Approval . Baylee Hender	Date 6-30-04  Date 8-11-04
Additional water anglor sewer tap fee(s) are required:	YAS NO W/O No. 7531
Utility Accounting ( ) lee to t	Date & 11/04
VALID FOR SIX MONTHS FROM DATE OF ISSUANCE	


(White: Planning)

(Yellow: Customer)

(Pink: Building Department)

(Goldenrod: Utility Accounting)



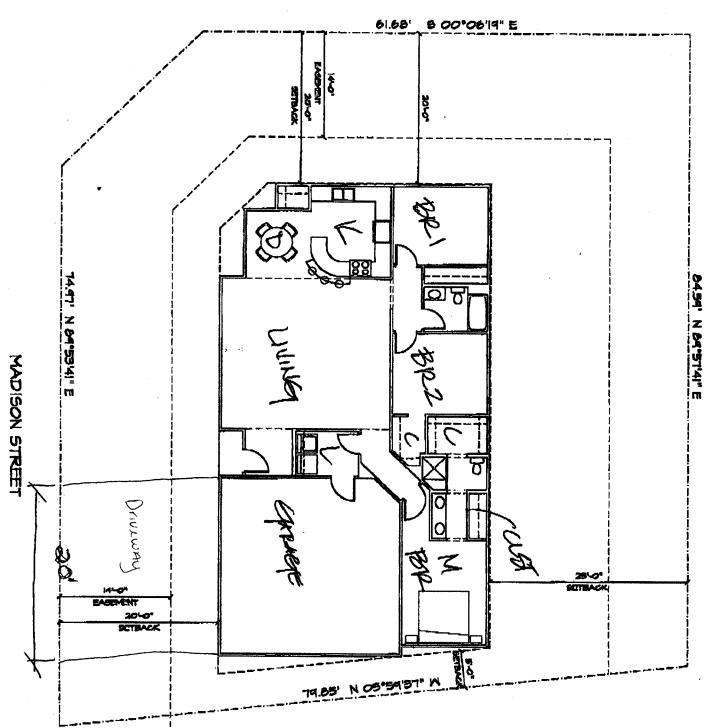

8-10-04

ACCEPTED Haylen Herderson
ANY CHARGE OF SETBACKS MUST BE
APPROASED BY THE CITY PLANNING
DEPT. IT IS THE APPLICANT'S
RESPONSIBILITY TO PROPERLY
LOCATE AND IDENTIFY EASEMENTS
AND PROPERTY LINES.

ac 1/28/04