

FEE \$ 10.00  
 TCP \$ 500.00  
 SIF \$ 292.00

**PLANNING CLEARANCE**  
 (Single Family Residential and Accessory Structures)  
**Community Development Department**

BLDG PERMIT NO. \_\_\_\_\_



Building Address 2820 Meade Ct  
 Parcel No. 2943-063-45-007  
 Subdivision Village Park  
 Filing 2 Block 1 Lot 7

No. of Existing Bldgs 0 Proposed 1  
 Sq. Ft. of Existing Bldgs 0 Proposed 2123A  
 Sq. Ft. of Lot / Parcel \_\_\_\_\_  
 Sq. Ft. Coverage of Lot by Structures & Impervious Surface (Total Existing & Proposed) \_\_\_\_\_

**OWNER INFORMATION:**

Name Sonshine II  
 Address 2350 G ROAD  
 City / State / Zip GJ, CO 81505

**DESCRIPTION OF WORK & INTENDED USE:**

- New Single Family Home (\*check type below)  
 Interior Remodel  Addition  
 Other (please specify): \_\_\_\_\_

**APPLICANT INFORMATION:**

Name Sonshine II  
 Address 2350 G ROAD  
 City / State / Zip GJ CO 81505  
 Telephone 255-8853

**\*TYPE OF HOME PROPOSED:**

- Site Built  Manufactured Home (UBC)  
 Manufactured Home (HUD)  
 Other (please specify): \_\_\_\_\_

NOTES: \_\_\_\_\_

**REQUIRED: One plot plan, on 8 1/2" x 11" paper, showing all existing & proposed structure location(s), parking, setbacks to all property lines, ingress/egress to the property, driveway location & width & all easements & rights-of-way which abut the parcel.**

**THIS SECTION TO BE COMPLETED BY COMMUNITY DEVELOPMENT DEPARTMENT STAFF**

ZONE PD Maximum coverage of lot by structures 50%  
 SETBACKS: Front 15' 20' from property line (PL) Permanent Foundation Required: YES X NO \_\_\_\_\_  
 Side 5' from PL Rear 10' from PL Parking Requirement 2  
 Maximum Height of Structure(s) 32' Special Conditions Engineered Foundations Required  
 Voting District D Driveway Location Approval \_\_\_\_\_ (Engineer's Initials)

Modifications to this Planning Clearance must be approved, in writing, by the Community Development Department. The structure authorized by this application cannot be occupied until a final inspection has been completed and a Certificate of Occupancy has been issued, if applicable, by the Building Department (Section 305, Uniform Building Code).

I hereby acknowledge that I have read this application and the information is correct; I agree to comply with any and all codes, ordinances, laws, regulations or restrictions which apply to the project. I understand that failure to comply shall result in legal action, which may include but not necessarily be limited to non-use of the building(s).

Applicant Signature [Signature] Date 3-11-04  
 Department Approval M.C. Faye Hall Date 4/5/04


Additional water and/or sewer tap fee(s) are required: YES  NO  W/O No. 17135  
 Utility Accounting Vatelsberg Date 4/5/04

VALID FOR SIX MONTHS FROM DATE OF ISSUANCE (Section 2.2.C.1 Grand Junction Zoning & Development Code)  
 (White: Planning) (Yellow: Customer) (Pink: Building Department) (Goldenrod: Utility Accounting)

NOTICE:

1. IT IS THE RESPONSIBILITY OF THE BUILDER OR OWNER TO VERIFY ALL DETAILS AND DIMENSIONS PRIOR TO CONSTRUCTION.
2. USE OF THIS PLAN CONSTITUTES BUILDER AND OR HOME OWNERS ACCEPTANCE OF THESE TERMS.
3. ALL DIMENSIONS ARE TO FACE OF STUD UNLESS OTHERWISE NOTED.
4. WALLS ARE DRAWN AS 3-1/2" THICK FOR 2x4 WALLS AND 5-1/2" FOR 2x6 WALLS.
5. THIS PLAN HAS NOT BEEN ENGINEERED BY AUTODRAFT. SEE SEPARATE DRAWINGS BY OTHERS FOR ENGINEERING DATA.

BLOCK 1  
LOT 7  
4187 sf

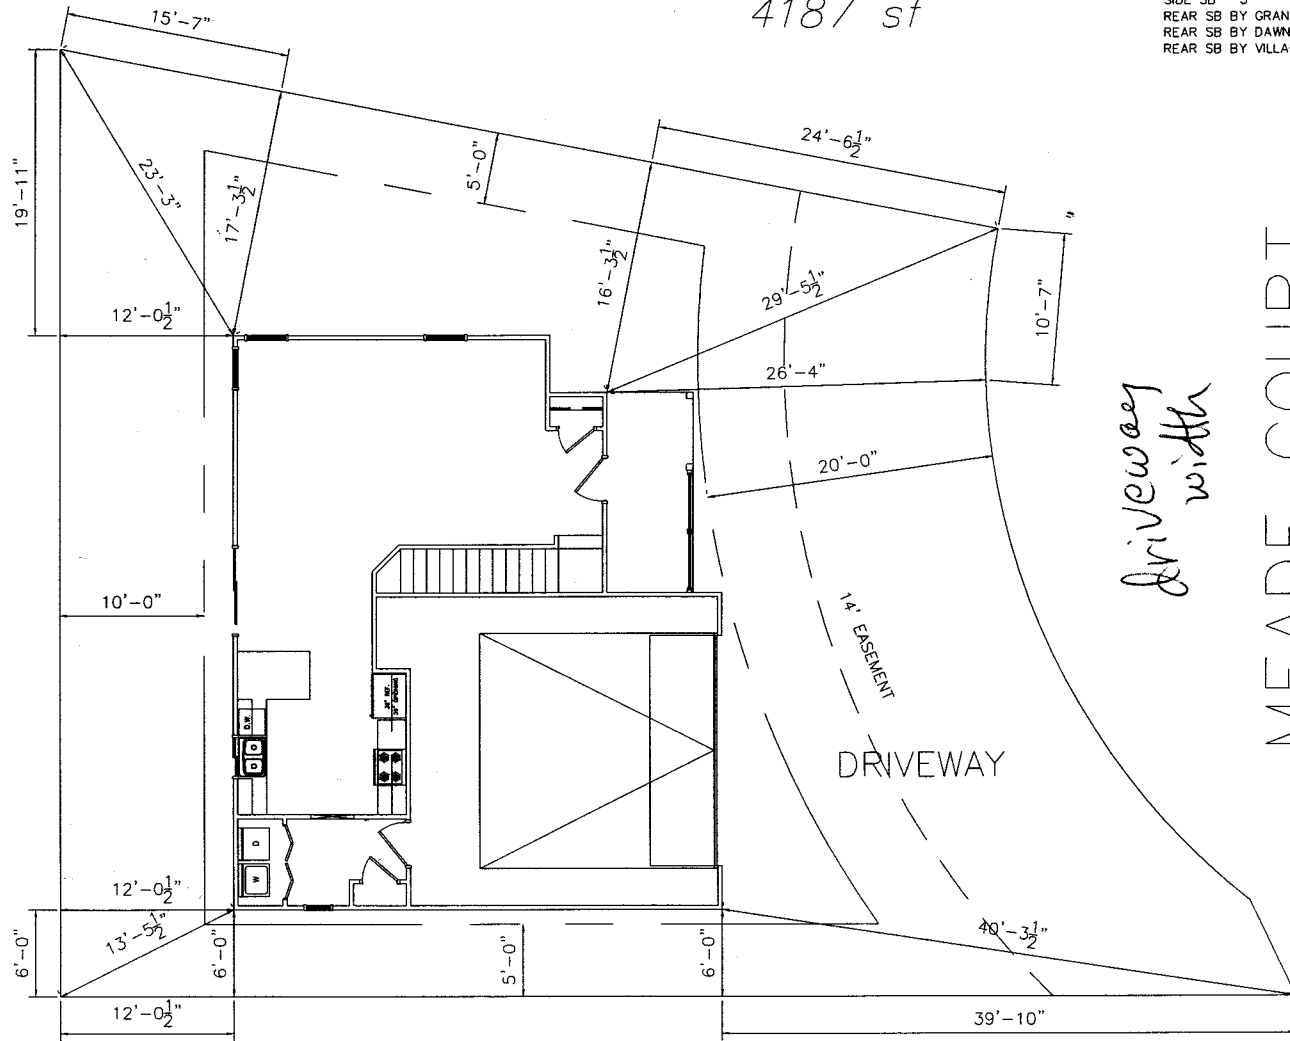

SETBACKS:  
FRONT SB TO GARAGE 20' (15' TO HOUSE)  
SIDE SB 5'  
REAR SB BY GRAND VIEW 25'  
REAR SB BY DAWN 20'  
REAR SB BY VILLAGE PARK 10'

*driveway with*

MEADE COURT

2820

*4/15/04  
C. J. Hall*  
**ACCEPTED**  
**ANY CHANGE OF SETBACKS MUST BE APPROVED BY THE CITY PLANNING DEPT. IT IS THE APPLICANT'S RESPONSIBILITY TO PROPERLY LOCATE AND IDENTIFY EASEMENTS AND PROPERTY LINES.**


**NOTE:**  
BUILDER TO VERIFY ALL SETBACK AND EASEMENT ENCROACHMENTS PRIOR TO CONSTRUCTION

**NOTE:**  
DIMENSIONS MAY BE PULLED TO BRICK LEDGE  
VERIFY WITH FLOORPLAN

THE CAMERON (NARROW OF CARLETON)

REVISIONS	
A	
B	
C	
D	
E	
F	
G	
H	

**AUTO DRAFT**  
COMPUTER AIDED DRAFTING  
GRAND JUNCTION, CO (970) 241-6762

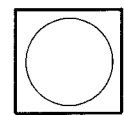

VILLAGE PARK  
THE MESA

DRAWN BY	AUTODRAFT
FILE NAME	
CAD FILE	
DATE	9-16-03
SCALE	1/4" = 1'-0"
SHEET	
<b>SITE</b>	