
TCP \$ 500.00 (Single Family Residential and J SIF \$ 292.00 Community Developm	
Building Address J&JY Meade Ct	Your Bridge to a Better Community No. of Existing Bldgs Proposed
Parcel No. <u>2943-063-45-009</u>	Sq. Ft. of Existing Bldgs Proposed 2123
Subdivision Village Pa-K	Sq. Ft. of Lot / Parcel
Filing Block/ Lot	Sq. Ft. Coverage of Lot by Structures & Impervious Surfa (Total Existing & Proposed)
OWNER INFORMATION:	DESCRIPTION OF WORK & INTENDED USE:
Name <u>Sonshine II</u> Address <u>350 G Ruan</u>	New Single Family Home (*check type below)
City / State / Zip GJ CO 11505	Other (please specify):
APPLICANT INFORMATION:	*TYPE OF HOME PROPOSED:
Name Sonshine IT	Site Built Manufactured Home (U Manufactured Home (HUD) Other (please specify):
Address <u>2350 C ROAD</u>	_
City / State / Zip <u>GJ</u> CU 8/505 Telephone <u>255-8853</u>	NOTES:
property lines, ingress/egress to the property, driveway loca ■ THIS SECTION TO BE COMPLETED BY CO ∩ ∩	existing & proposed structure location(s), parking, setbacks to tion & width & all easements & rights-of-way which abut the par MMUNITY DEVELOPMENT DEPARTMENT STAFF Pa らん り
ZONE PD	_ Maximum coverage of lot by structures <u>50 76</u>
SETBACKS: Front <u>15'1/00SC</u> from property line (PL) Side <u>5'</u> from PL Rear 15' from PL	Permanent Foundation Required: YES_X_NO
201	
Maximum Height of Structure(s)	Special Conditions_ <u>Enafoun_Cation_Requir</u>
_ .	
Voting District Driveway Location Approval(Engineer's Initia	als)
Voting District Location Approval	d, in writing, by the Community Development Department. d until a final inspection has been completed and a Certificat
Voting District Location Approval (Engineer's Initial Modifications to this Planning Clearance must be approve structure authorized by this application cannot be occupier Occupancy has been issued, if applicable, by the Building I hereby acknowledge that I have read this application and t	ed, in writing, by the Community Development Department. d until a final inspection has been completed and a Certificate Department (Section 305, Uniform Building Code). he information is correct; I agree to comply with any and all coo the project. I understand that failure to comply shall result in le
Voting District Location Approval (Engineer's Initial Modifications to this Planning Clearance must be approve structure authorized by this application cannot be occupied Occupancy has been issued, if applicable, by the Building I hereby acknowledge that I have read this application and to ordinances, laws, regulations or restrictions which apply to	ed, in writing, by the Community Development Department. d until a final inspection has been completed and a Certificat Department (Section 305, Uniform Building Code). he information is correct; I agree to comply with any and all coo the project. I understand that failure to comply shall result in le
Voting District Location Approval (Engineer's Initial Modifications to this Planning Clearance must be approve structure authorized by this application cannot be occupier Occupancy has been issued, if applicable, by the Building I hereby acknowledge that I have read this application and to ordinances, laws, regulations or restrictions which apply to action, which may include but not necessarily be limited to Applicant Signature	ed, in writing, by the Community Development Department. d until a final inspection has been completed and a Certificate Department (Section 305, Uniform Building Code). he information is correct; I agree to comply with any and all coor the project. I understand that failure to comply shall result in le non-use of the building(s).

2824 Mearle

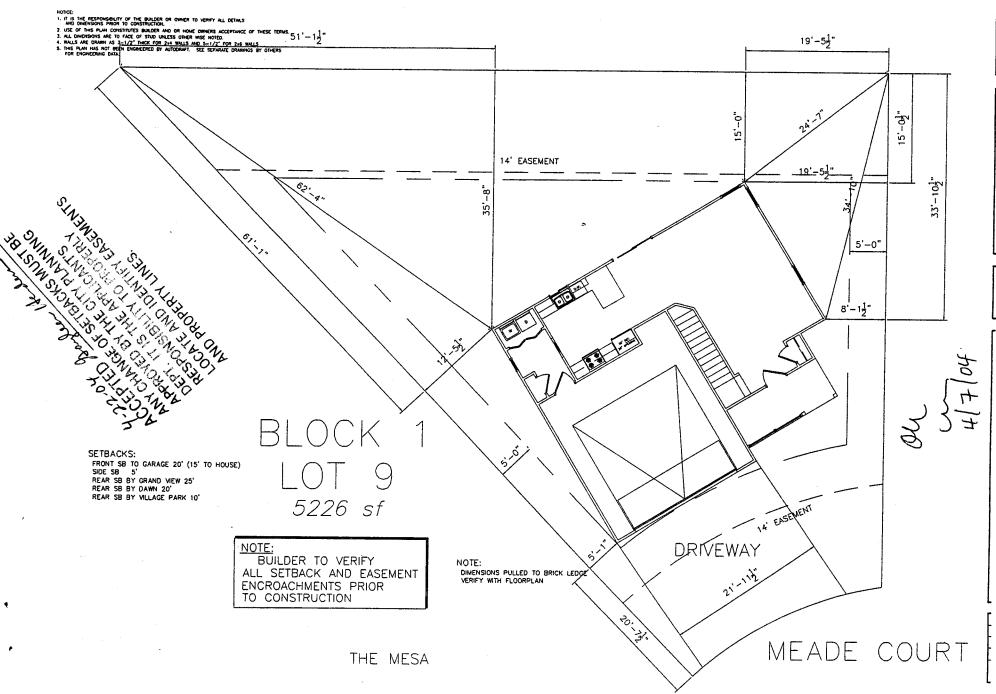

Construction and product and products
