

FEE \$	10.00
TCP \$	500.00
SIF \$	292.00

PLANNING CLEARANCE
 (Single Family Residential and Accessory Structures)
Community Development Department

BLDG PERMIT NO. _____



Your Bridge to a Better Community

BLDG ADDRESS 446 MEDITERRANEAN WAY SQ. FT. OF PROPOSED BLDGS/ADDITION 3500
 TAX SCHEDULE NO. 2945-183-11-004 SQ. FT. OF EXISTING BLDGS _____
 SUBDIVISION RENAISSANCE II TOTAL SQ. FT. OF EXISTING & PROPOSED _____
 FILING 2 BLK 3 LOT 4 NO. OF DWELLING UNITS:
 Before: 0 After: 1 this Construction
 (1) OWNER BRENT PRUETT NO. OF BUILDINGS ON PARCEL
 Before: 0 After: 1 this Construction
 (1) ADDRESS ~~446~~ 3310 C RD USE OF EXISTING BUILDINGS NA
PALISADE, CO 81526
 (1) TELEPHONE 434-1862 DESCRIPTION OF WORK & INTENDED USE NEW SINGLE FAMILY
 (2) APPLICANT SAME TYPE OF HOME PROPOSED:
 (2) ADDRESS _____ Site Built _____ Manufactured Home (UBC)
 _____ Manufactured Home (HUD)
 (2) TELEPHONE _____ Other (please specify) _____

REQUIRED: One plot plan, on 8 1/2" x 11" paper, showing all existing & proposed structure location(s), parking, setbacks to all property lines, ingress/egress to the property, driveway location & width & all easements & rights-of-way which abut the parcel.

THIS SECTION TO BE COMPLETED BY COMMUNITY DEVELOPMENT DEPARTMENT STAFF

ZONE RSF-4 Maximum coverage of lot by structures 50%
 SETBACKS: Front 20' from property line (PL) Permanent Foundation Required: YES NO _____
 or _____ from center of ROW, whichever is greater
 Side 7' from PL, Rear 25' from PL Parking Req'mt 2
 Maximum Height 35' Special Conditions Engineered Foundations
 CENSUS A Required TRAFFIC _____ ANN# _____

Modifications to this Planning Clearance must be approved, in writing, by the Community Development Department. The structure authorized by this application cannot be occupied until a final inspection has been completed and a Certificate of Occupancy has been issued, if applicable, by the Building Department (Section 305, Uniform Building Code).

I hereby acknowledge that I have read this application and the information is correct; I agree to comply with any and all codes, ordinances, laws, regulations or restrictions which apply to the project. I understand that failure to comply shall result in legal action, which may include but not necessarily be limited to non-use of the building(s).


Applicant Signature Brent Pruett Date _____
 Department Approval H. C. Jare Hall Date 3/23/04

Additional water and/or sewer tap fee(s) are required:	YES <input checked="" type="checkbox"/>	NO	W/O No. <u>17103</u>
Utility Accounting	<u>C. Miller</u>	Date	<u>3/23/04</u>

VALID FOR SIX MONTHS FROM DATE OF ISSUANCE (Section 9-3-2C Grand Junction Zoning & Development Code)

(White: Planning) (Yellow: Customer) (Pink: Building Department) (Goldenrod: Utility Accounting)

446
Mediterranean Way

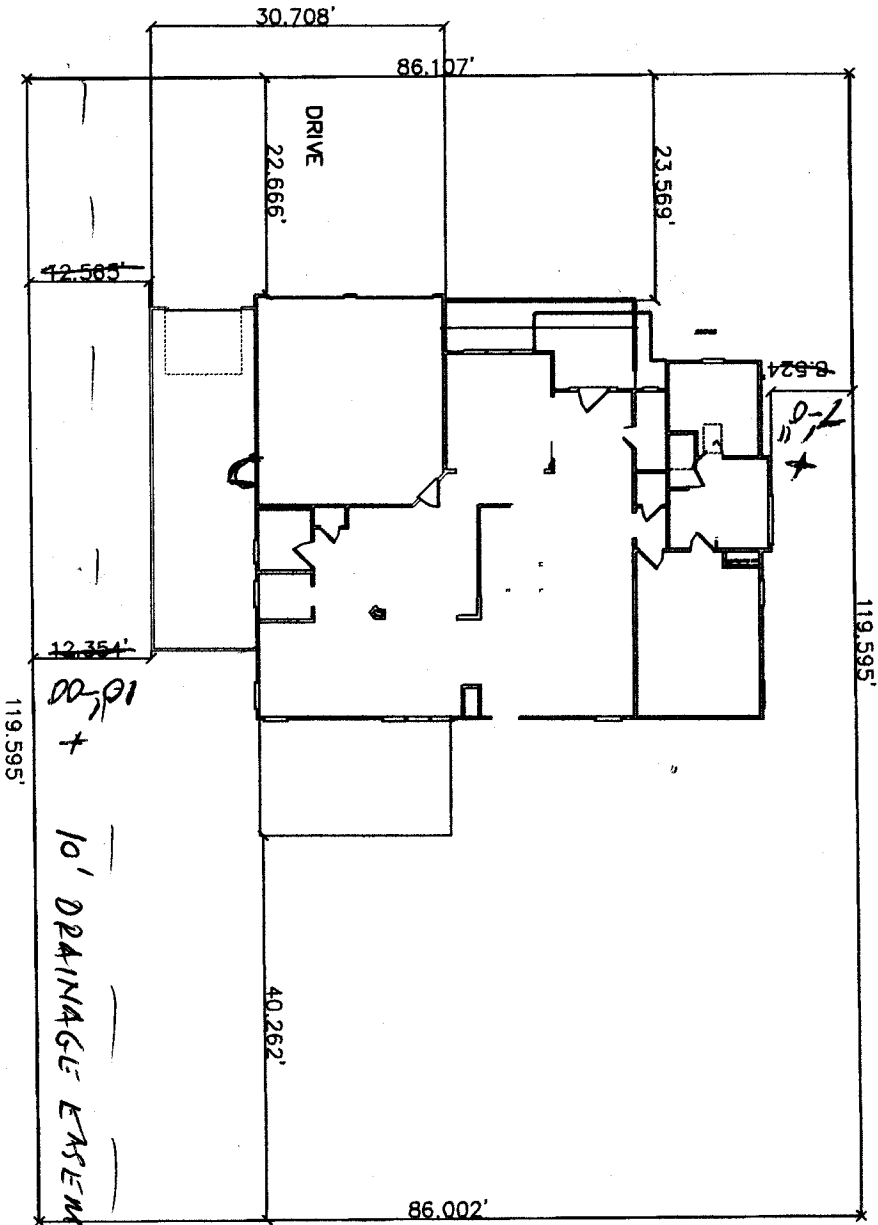

ACCEPTED
ANY CHANGE OF SETBACKS MUST BE
APPROVED BY THE CITY PLANNING
DEPT. IT IS THE APPLICANTS
RESPONSIBILITY TO PROPERLY
LOCATE AND IDENTIFY EASEMENTS
AND PROPERTY LINES.

By [Signature]
3/23/04

OK
3/10/04