

FEE \$	10.00
TCP \$	
SIF \$	

PLANNING CLEARANCE
 (Single Family Residential and Accessory Structures)
Community Development Department

BLDG PERMIT NO. _____



Your Bridge to a Better Community

BLDG ADDRESS 299 S. MOUNTAIN VIEW SQ. FT. OF PROPOSED BLDGS/ADDITION 440 SF
 TAX SCHEDULE NO. 2945-251-01-004 SQ. FT. OF EXISTING BLDGS 3345 SF
 SUBDIVISION _____ TOTAL SQ. FT. OF EXISTING & PROPOSED 3785 SF
 FILING _____ BLK _____ LOT _____
 NO. OF DWELLING UNITS:
 Before: 1 After: 1 this Construction
 NO. OF BUILDINGS ON PARCEL
 Before: 1 After: 2 this Construction
 (1) OWNER ALLEN LOOSE
 (1) ADDRESS 299 S. MOUNTAIN VIEW
 (1) TELEPHONE 241-4903
 (2) APPLICANT MOR STORAGE CHAD
 (2) ADDRESS 3010 I70 B. WOOD
 (2) TELEPHONE 254-0460
 USE OF EXISTING BUILDINGS _____
 DESCRIPTION OF WORK & INTENDED USE 20X22 SHOP
 TYPE OF HOME PROPOSED:
 _____ Site Built _____ Manufactured Home (UBC)
 _____ Manufactured Home (HUD)
 _____ Other (please specify) _____

REQUIRED: One plot plan, on 8 1/2" x 11" paper, showing all existing & proposed structure location(s), parking, setbacks to all property lines, ingress/egress to the property, driveway location & width & all easements & rights-of-way which abut the parcel.

THIS SECTION TO BE COMPLETED BY COMMUNITY DEVELOPMENT DEPARTMENT STAFF

ZONE RMF-8 Maximum coverage of lot by structures 70%
 SETBACKS: Front 20' from property line (PL) Permanent Foundation Required: YES NO
 or _____ from center of ROW, whichever is greater
 Side 5' from PL, Rear 10' from PL Parking Req'mt 2
 Maximum Height 35' Special Conditions _____
 CENSUS _____ TRAFFIC _____ ANNEX# _____

Modifications to this Planning Clearance must be approved, in writing, by the Community Development Department. The structure authorized by this application cannot be occupied until a final inspection has been completed and a Certificate of Occupancy has been issued, if applicable, by the Building Department (Section 305, Uniform Building Code).

I hereby acknowledge that I have read this application and the information is correct; I agree to comply with any and all codes, ordinances, laws, regulations or restrictions which apply to the project. I understand that failure to comply shall result in legal action, which may include but not necessarily be limited to non-use of the building(s).

Applicant Signature [Signature] Date 1/14/04
 Department Approval [Signature] Date 1/14/04


Additional water and/or sewer tap fee(s) are required:	YES	NO <input checked="" type="checkbox"/>	W/O No. <u>no dog use</u>
Utility Accounting	<u>[Signature]</u>	Date	<u>1/14/04</u>

VALID FOR SIX MONTHS FROM DATE OF ISSUANCE (Section 9-3-2C Grand Junction Zoning & Development Code)

(White: Planning) (Yellow: Customer) (Pink: Building Department) (Goldenrod: Utility Accounting)

ACCEPTED [Signature]
ANY CHANGE OF SETBACKS MUST BE
APPROVED BY THE CITY PLANNING
DEPT. CITY OF PORTLAND
LOCATE AND IDENTIFY EASEMENTS
AND PROPERTY LINES

1-14-00

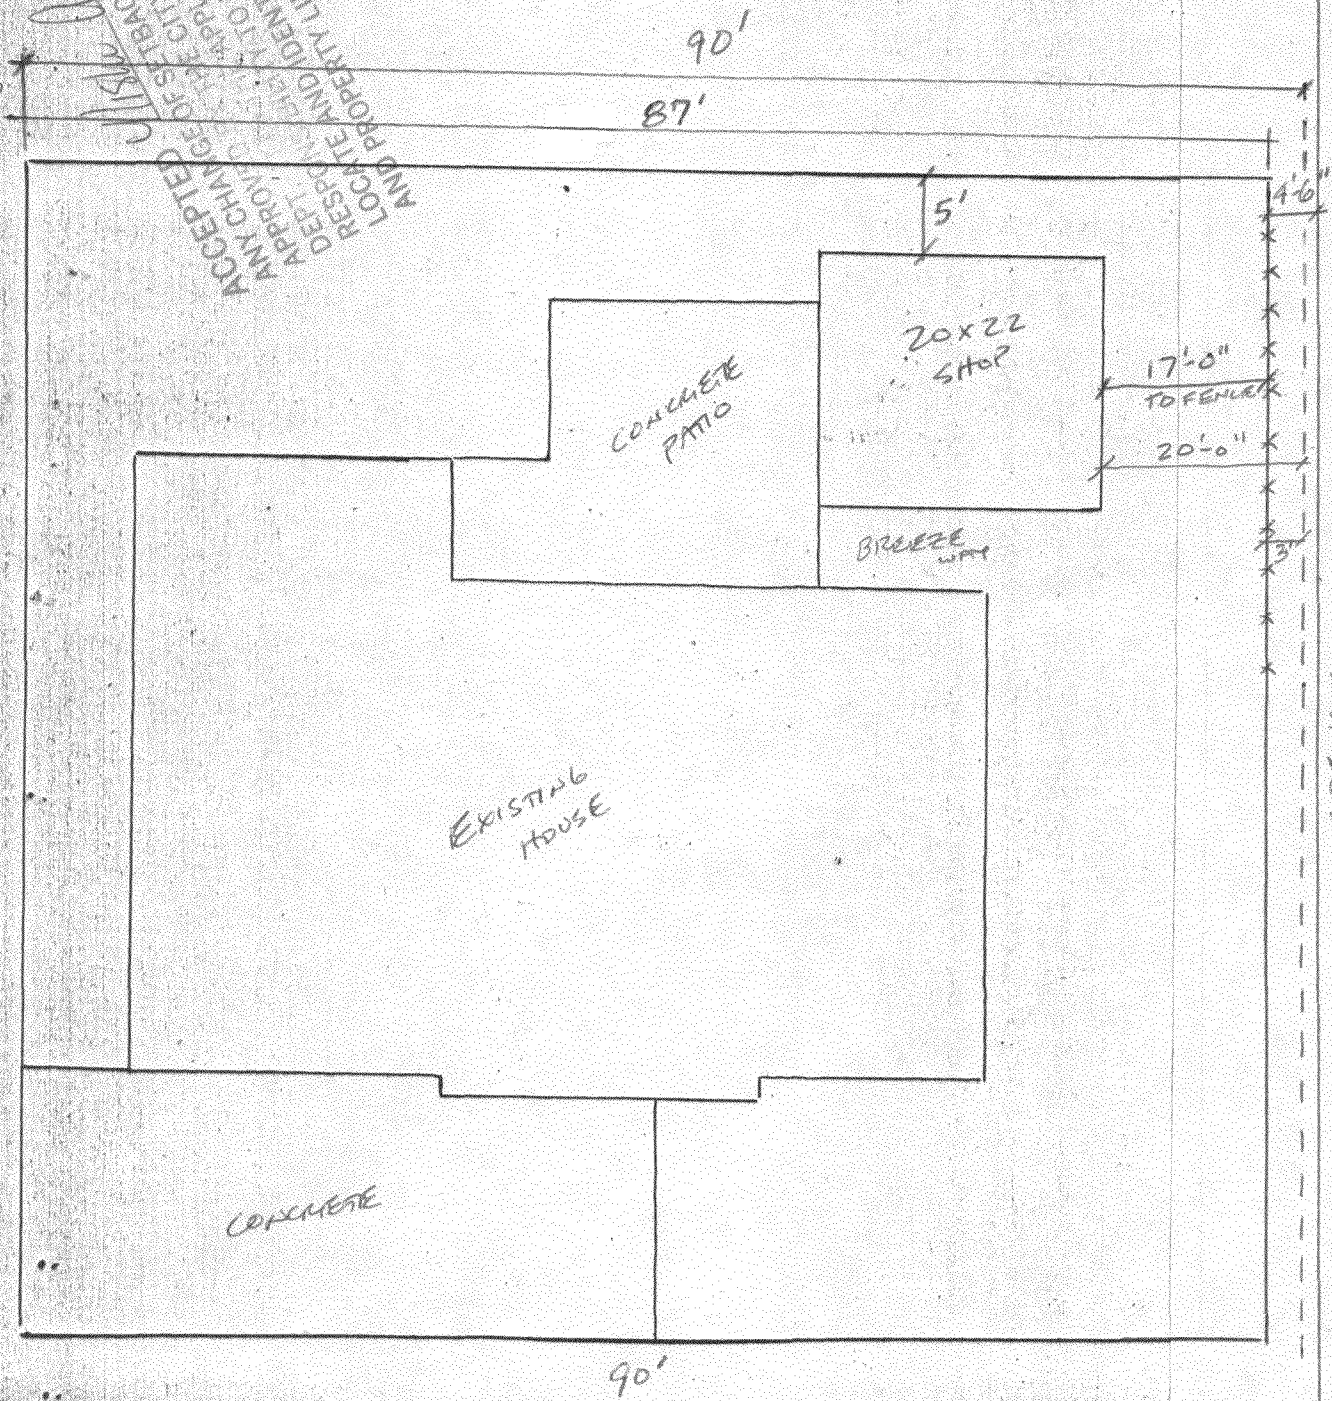

S. MOUNTAIN VIEW