

FEE \$ 10.00
 TCP \$ 500.00
 SIF \$ 292.00

PLANNING CLEARANCE
 (Single Family Residential and Accessory Structures)
 Community Development Department

BLDG PERMIT NO. _____

Building Address 385 MYRRH ST
 Parcel No. 2943-191-21-011
 Subdivision White Willow
 Filing 1 Block 1 Lot 11

No. of Existing Bldgs 6 No. Proposed 1
 Sq. Ft. of Existing Bldgs _____ Sq. Ft. Proposed 1508
 Sq. Ft. of Lot / Parcel 13,000
 Sq. Ft. Coverage of Lot by Structures & Impervious Surface (Total Existing & Proposed) 2,206

OWNER INFORMATION:

Name Dexter Morse
 Address _____
 City / State / Zip _____

DESCRIPTION OF WORK & INTENDED USE:

New Single Family Home (*check type below)
 Interior Remodel Addition
 Other (please specify): _____

APPLICANT INFORMATION:

Name Custom Quality Homes Inc
 Address 237 W. 1ST ST.
 City / State / Zip PALISADE CO. 81526
 Telephone 201-2371

***TYPE OF HOME PROPOSED:**

Site Built Manufactured Home (UBC)
 Manufactured Home (HUD)
 Other (please specify): _____

NOTES: _____

REQUIRED: One plot plan, on 8 1/2" x 11" paper, showing all existing & proposed structure location(s), parking, setbacks to all property lines, ingress/egress to the property, driveway location & width & all easements & rights-of-way which abut the parcel.

THIS SECTION TO BE COMPLETED BY COMMUNITY DEVELOPMENT DEPARTMENT STAFF

ZONE RSF-4 Maximum coverage of lot by structures 50%
 SETBACKS: Front 20' from property line (PL) Permanent Foundation Required: YES NO _____
 Side 7' from PL Rear 25' from PL Parking Requirement 2
 Maximum Height of Structure(s) 35' Special Conditions Engineered Foundation Required
 Voting District E Driveway Location Approval U (Engineer's Initials)

Modifications to this Planning Clearance must be approved, in writing, by the Community Development Department. The structure authorized by this application cannot be occupied until a final inspection has been completed and a Certificate of Occupancy has been issued, if applicable, by the Building Department (Section 305, Uniform Building Code).

I hereby acknowledge that I have read this application and the information is correct; I agree to comply with any and all codes, ordinances, laws, regulations or restrictions which apply to the project. I understand that failure to comply shall result in legal action, which may include but not necessarily be limited to non-use of the building(s).


Applicant Signature Thomas S. Hely Date 6/29/04
 Department Approval M. W. H. Hagan Date 6/30/04

Additional water and/or sewer tap fee(s) are required: YES NO W/O No. 17395
 Utility Accounting 0 Date 6-30-04

VALID FOR SIX MONTHS FROM DATE OF ISSUANCE (Section 2.2.C.1 Grand Junction Zoning & Development Code)
 (White: Planning) (Yellow: Customer) (Pink: Building Department) (Goldenrod: Utility Accounting)

385 MYRRH ST.
 LOT 11 BLOCK 1
 White Willow Sub

ACCEPTED *Alisa Wagner* 6/29/04
 ANY CHANGE OF SETBACKS MUST BE
 APPROVED BY THE CITY PLANNING
 DEPT. IT IS THE APPLICANT'S
 RESPONSIBILITY TO PROPERLY
 LOCATE AND IDENTIFY EASEMENTS
 AND PROPERTY LINES

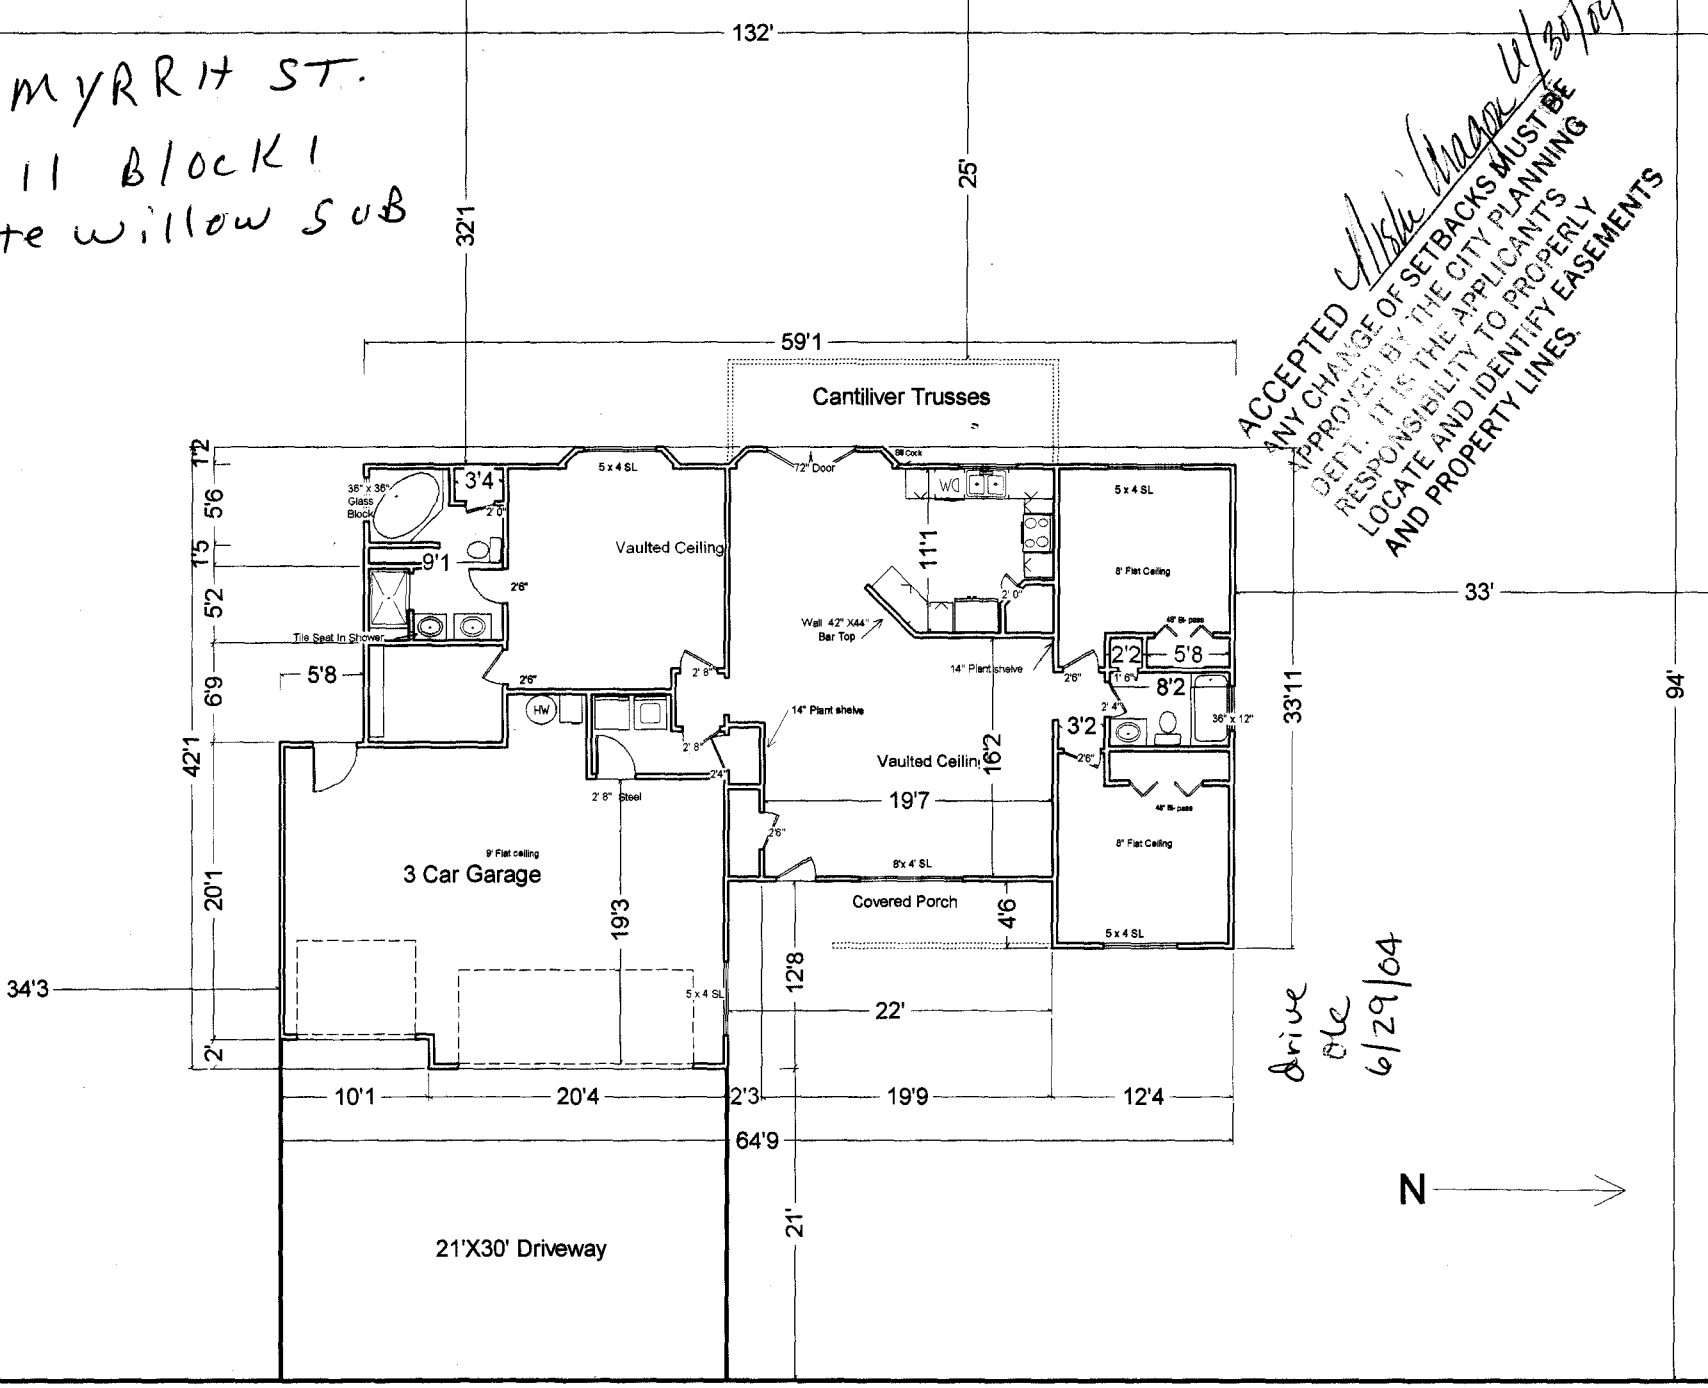

drive
 etc
 6/29/04