| FEE\$ | 10.00    |
|-------|----------|
| TCP\$ | 1,500.00 |
| CIE ¢ | 292.00   |

## **PLANNING CLEARANCE**

**BLDG PERMIT NO.** 

(Single Family Residential and Accessory Structures) **Community Development Department** 



|   | •   |
|---|---|
| BLDG ADDRESS 2606 Partidge Ct.  | SQ. FT. OF PROPOSED BLDGS/ADDITION 5795   |
| TAX SCHEDULE NO. 2701 - 352 - (21 - 006)  | SQ. FT. OF EXISTING BLDGS   |
| SUBDIVISION Hartings form   | TOTAL SQ. FT. OF EXISTING & PROPOSED 5795   |
| FILINGBLKLOT  | NO. OF DWELLING UNITS:  |
| (1) OWNER Jon Perers  | Before: After: this Construction  NO. OF BUILDINGS ON PARCEL  Before: After: this Construction  |
| (1) ADDRESS 398 1600 RD Dita  | Before: After: this Construction  |
| (1) TELEPHONE 261-4303  | USE OF EXISTING BUILDINGS SFIC  |
| (2) APPLICANT   | DESCRIPTION OF WORK & INTENDED USE  |
| <sup>(2)</sup> ADDRESS  | TYPE OF HOME PROPOSED:  Site Built Manufactured Home (UBC)  Manufactured Home (HUD)   |
| (2) TELEPHONE   | Other (please specify)  |
| property lines, ingress/egress to the property, driveway loc  | Il existing & proposed structure location(s), parking, setbacks to all sation & width & all easements & rights-of-way which abut the parcel.  OMMUNITY DEVELOPMENT DEPARTMENT STAFF   |
| ZONE  | Maximum coverage of lot by structures   |
| SETBACKS: Front from property line (PL) or from center of ROW, whichever is greater   | Permanent Foundation Required: YES_XNO  |
| Side 25' from PL, Rear 35' from PL  | Parking Req'mt  |
|   | A 1.1A  |
| Maximum Height  | Special Conditions  |
| Maximum Height  | Special Conditions ANNX#  |
| Modifications to this Planning Clearance must be approved structure authorized by this application cannot be occupied Occupancy has been issued, if applicable, by the Building I hereby acknowledge that I have read this application and ordinances, laws, regulations or restrictions which apply to action, which may include but not necessarily be limited to                       | ced, in writing, by the Community Development Department. The ed until a final inspection has been completed and a Certificate of Department (Section 305, Uniform Building Code).  The information is correct; I agree to comply with any and all codes, the project. I understand that failure to comply shall result in legal or non-use of the building(s).                             |
| Modifications to this Planning Clearance must be approved structure authorized by this application cannot be occupied. Occupancy has been issued, if applicable, by the Building I hereby acknowledge that I have read this application and ordinances, laws, regulations or restrictions which apply to action, which may include but not necessarily be limited to Applicant Signature  | ced, in writing, by the Community Development Department. The ed until a final inspection has been completed and a Certificate of Department (Section 305, Uniform Building Code).  the information is correct; I agree to comply with any and all codes, the project. I understand that failure to comply shall result in legal on non-use of the building(s).                             |
| Modifications to this Planning Clearance must be approved structure authorized by this application cannot be occupied Occupancy has been issued, if applicable, by the Building I hereby acknowledge that I have read this application and coordinances, laws, regulations or restrictions which apply to action, which may include but not necessarily be limited to Applicant Signature | ced, in writing, by the Community Development Department. The ed until a final inspection has been completed and a Certificate of Department (Section 305, Uniform Building Code).  The information is correct; I agree to comply with any and all codes, the project. I understand that failure to comply shall result in legal on non-use of the building(s).  Date 9/24/04  Date 9/24/04 |
| Modifications to this Planning Clearance must be approved structure authorized by this application cannot be occupied Occupancy has been issued, if applicable, by the Building I hereby acknowledge that I have read this application and coordinances, laws, regulations or restrictions which apply to action, which may include but not necessarily be limited to Applicant Signature | ced, in writing, by the Community Development Department. The ed until a final inspection has been completed and a Certificate of Department (Section 305, Uniform Building Code).  the information is correct; I agree to comply with any and all codes, the project. I understand that failure to comply shall result in legal on non-use of the building(s).                             |


VALID FOR SIX MONTHS FROM DATE OF ISSUANCE (Section 9-3-2C Grand Junction Zoning & Development Code)

(White: Planning)

(Yellow: Customer)

(Pink: Building Department)

(Goldenrod: Utility Accounting)

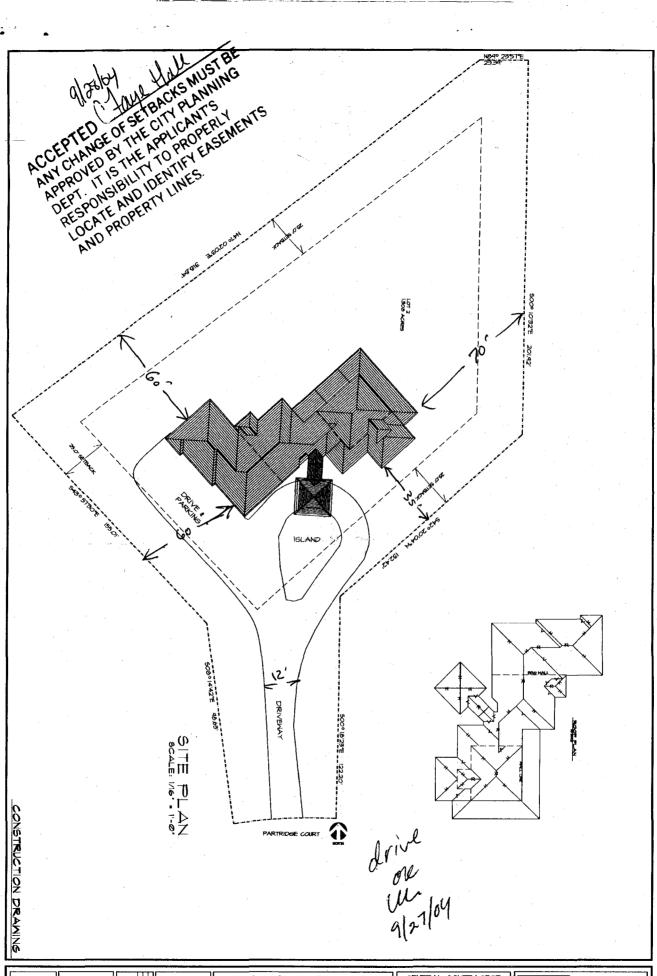

SHEET NUMBER 0



## PETERS RESIDENCE 2606 PARTRIDGE COURT,

PARTRIDGE FARMS SUBDIVISION GRAND JCTN., COLORADO

GENERAL CONTRACTOR: THOMAS PETERS 398 1600 ROAD,

(970) 261-4090 4303



HRISTOPHE RABACHER