

FEE \$	10.00
TCP \$	1,500
SIF \$	292.00

# PLANNING CLEARANCE

(Single Family Residential and Accessory Structures)  
**Community Development Department**

BLDG PERMIT NO. \_\_\_\_\_

Building Address 2070 RAINDANCE CT. No. of Existing Bldgs 0 No. Proposed 1  
 Parcel No. PARENT PARCEL 2097-354-12-009 Sq. Ft. of Existing Bldgs \_\_\_\_\_ Sq. Ft. Proposed 4312  
 Subdivision INDEPENDANCE RANCH Sq. Ft. of Lot / Parcel \_\_\_\_\_  
 Filing 11 Block 1 Lot 9 Sq. Ft. Coverage of Lot by Structures & Impervious Surface (Total Existing & Proposed) \_\_\_\_\_

**OWNER INFORMATION:**

Name BRIAN FISHER  
 Address 413 SMALLWOOD LN.  
 City / State / Zip CLIFTON CO 81520

**DESCRIPTION OF WORK & INTENDED USE:**

- New Single Family Home (\*check type below)
- Interior Remodel  Addition
- Other (please specify): \_\_\_\_\_

**APPLICANT INFORMATION:**

Name FISHER COAST.  
 Address 413 SMALLWOOD LN.  
 City / State / Zip CLIFTON, CO 81520  
 Telephone 216-7851

**\*TYPE OF HOME PROPOSED:**

- Site Built  Manufactured Home (UBC)
- Manufactured Home (HUD)
- Other (please specify): \_\_\_\_\_

NOTES: \_\_\_\_\_

**REQUIRED: One plot plan, on 8 1/2" x 11" paper, showing all existing & proposed structure location(s), parking, setbacks to all property lines, ingress/egress to the property, driveway location & width & all easements & rights-of-way which abut the parcel.**

**THIS SECTION TO BE COMPLETED BY COMMUNITY DEVELOPMENT DEPARTMENT STAFF**

ZONE PD Maximum coverage of lot by structures 35%  
 SETBACKS: Front 25' from property line (PL) Permanent Foundation Required: YES X NO \_\_\_\_\_  
 Side 10' from PL Rear 25' from PL Parking Requirement 2  
 Maximum Height of Structure(s) 32' Special Conditions Slope Stability analysis  
 Voting District A Driveway Location Approval UU required to be approved by  
 (Engineer's Initials) CO Geological Survey.

Modifications to this Planning Clearance must be approved, in writing, by the Community Development Department. The structure authorized by this application cannot be occupied until a final inspection has been completed and a Certificate of Occupancy has been issued, if applicable, by the Building Department (Section 305, Uniform Building Code).

I hereby acknowledge that I have read this application and the information is correct; I agree to comply with any and all codes, ordinances, laws, regulations or restrictions which apply to the project. I understand that failure to comply shall result in legal action, which may include but not necessarily be limited to non-use of the building(s).

Applicant Signature [Signature] Date 7/28/04  
 Department Approval H. C. [Signature] Date 8/18/04

Additional water and/or sewer tap fee(s) are required:	YES <input checked="" type="checkbox"/>	NO <input type="checkbox"/>	W/O No. <u>17557</u>
Utility Accounting <u>[Signature]</u>	Date <u>8/18/04</u>		

VALID FOR SIX MONTHS FROM DATE OF ISSUANCE (Section 2.2.C.1 Grand Junction Zoning & Development Code)  
 (White: Planning) (Yellow: Customer) (Pink: Building Department) (Goldenrod: Utility Accounting)



RAINDANCE CT.

DRIVE  
24'-0 1/2"

83.68'

25'

34'-7 1/4"  
"FEET 07.65"

34'-7 1/4"  
"1.75"

34'-7 1/4"  
"1.75"

31'-0"

158.05'

SCALE 1/8" = 1'  
0.370 ACRES

138.33'

BLOCK 1  
LOT 9

2070 RAINDANCE CT.

lot 9 BLK. 1  
Filing # 11

7/28/04  
33  
300

1'-0"  
35'-2 5/8"

91' 3/4"

158

110.66'

ACCEPTED *sk by Jay Hall*  
ANY CHANGE OF SETBACKS MUST BE APPROVED BY THE CITY PLANNING DEPT. IT IS THE APPLICANT'S RESPONSIBILITY TO PROPERLY LOCATE AND IDENTIFY EASEMENTS AND PROPERTY LINES.

# STATE OF COLORADO

**COLORADO GEOLOGICAL SURVEY**  
Department of Natural Resources  
1313 Sherman Street, Room 715  
Denver, Colorado 80203  
Phone (303) 866-2611  
FAX (303) 866-2461



DEPARTMENT OF  
**NATURAL  
RESOURCES**

Bill Owens  
Governor

Russell George  
Executive Director

Ronald W. Cattary  
Division Director

Vincent Matthews  
State Geologist

August 18, 2004

Ms Faye Hall  
Grand Junction Community Development  
250 N. 5<sup>th</sup> St  
Grand Junction, CO 81501

Re: **Lot 9, Independence Ranch**  
**CGS Review No. MA-03-0038**


Dear Ms Hall:

I have reviewed the letter on Slope Stability, 2070 Raindance Court prepared by Grand Junction Lincoln-DeVore (August 5, 2004). The lot, which did have a deep gully extending into the northeast corner, has been filled with up to 8 ft of controlled fill sloped to a very gentle grade. The outlets for storm water are located in the utility and drainage easement and should not affect lot 9 unless headward erosion becomes active.

I find the grading mitigation to be adequate for the site and have no objections to the proposed construction.

Yours truly,

Celia Greenman  
Geologist

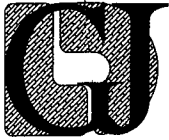

GRAND JUNCTION  
LINCOLN DeVORE, Inc.  
GEOTECHNICAL ENGINEERS - GEOLOGISTS

ERIC HAUN

1441 Motor St.  
Grand Junction, CO 81505

TEL: (970) 242-8968  
FAX: (970) 242-1561

August 5, 2004

Mr. Brian Fisher  
FISHER CONSTRUCTION  
413 Smallwood Lane  
Clifton, Colorado 81520

Re: Slope Stability, 2070 Raindance Court, Grand Junction, Colorado

Gentlemen:

I have reviewed our records regarding the above referenced site (Lot 9, Block 1, Filing 10, Independence Ranch) and have visited the site to observe the final site grading and the actual foundation excavation. Our records include the GJLD Report of Slope Stability Study, Independence Ranch Subdivision, Filing 10 & 11, February 25, 2003 and Fill Density Test Daily Reports for the Structural Fill and Overlot Grading for this subdivision.

**The site grading has resulted in this lot being removed from the Area of Special Slope Stability Concern.** The subdivision site grading on and adjacent to 2070 Raindance Court has included up to eight feet (8') of controlled fill placed within the old gully. Copies of our Fill Density Test Daily Reports are included with this letter. The controlled fill was placed in conjunction with the storm drainage piping and outlets. The controlled fill was extended over fifty feet (50') to the northeast, with the new gully head at the storm drainage outlets.

The original lot topography included an eight (8') foot deep gully in the north portion of the building area, which drained to the north, northeast, into the gully dissected Bluff Line. The main Bluff Line is over 300' northeast of this building lot. The new site grading has a very gentle slope (1:18, vertical:horizontal) to the northeast, for about 21' feet beyond the building lot. At the upper Slope Break, the slope slightly steepens (1:10, vertical:horizontal) for over 40 feet. At the lower slope break, The final slope into the gully steepens (1:3, vertical:horizontal) for a final slope height of about 8' to 10'. The final structural and controlled fills are mostly founded on the lower sandy Gravel and Cobble.

We hope this letter has provided you with the information required. If questions arise or further information is needed, please feel free to contact Grand Junction Lincoln-DeVore at any time.


Respectfully submitted,

GRAND JUNCTION  
LINCOLN-DeVORE, INC.



by: Edward M. Morris PE  
Principal Engineer

GJLD Job # 91208-GJ

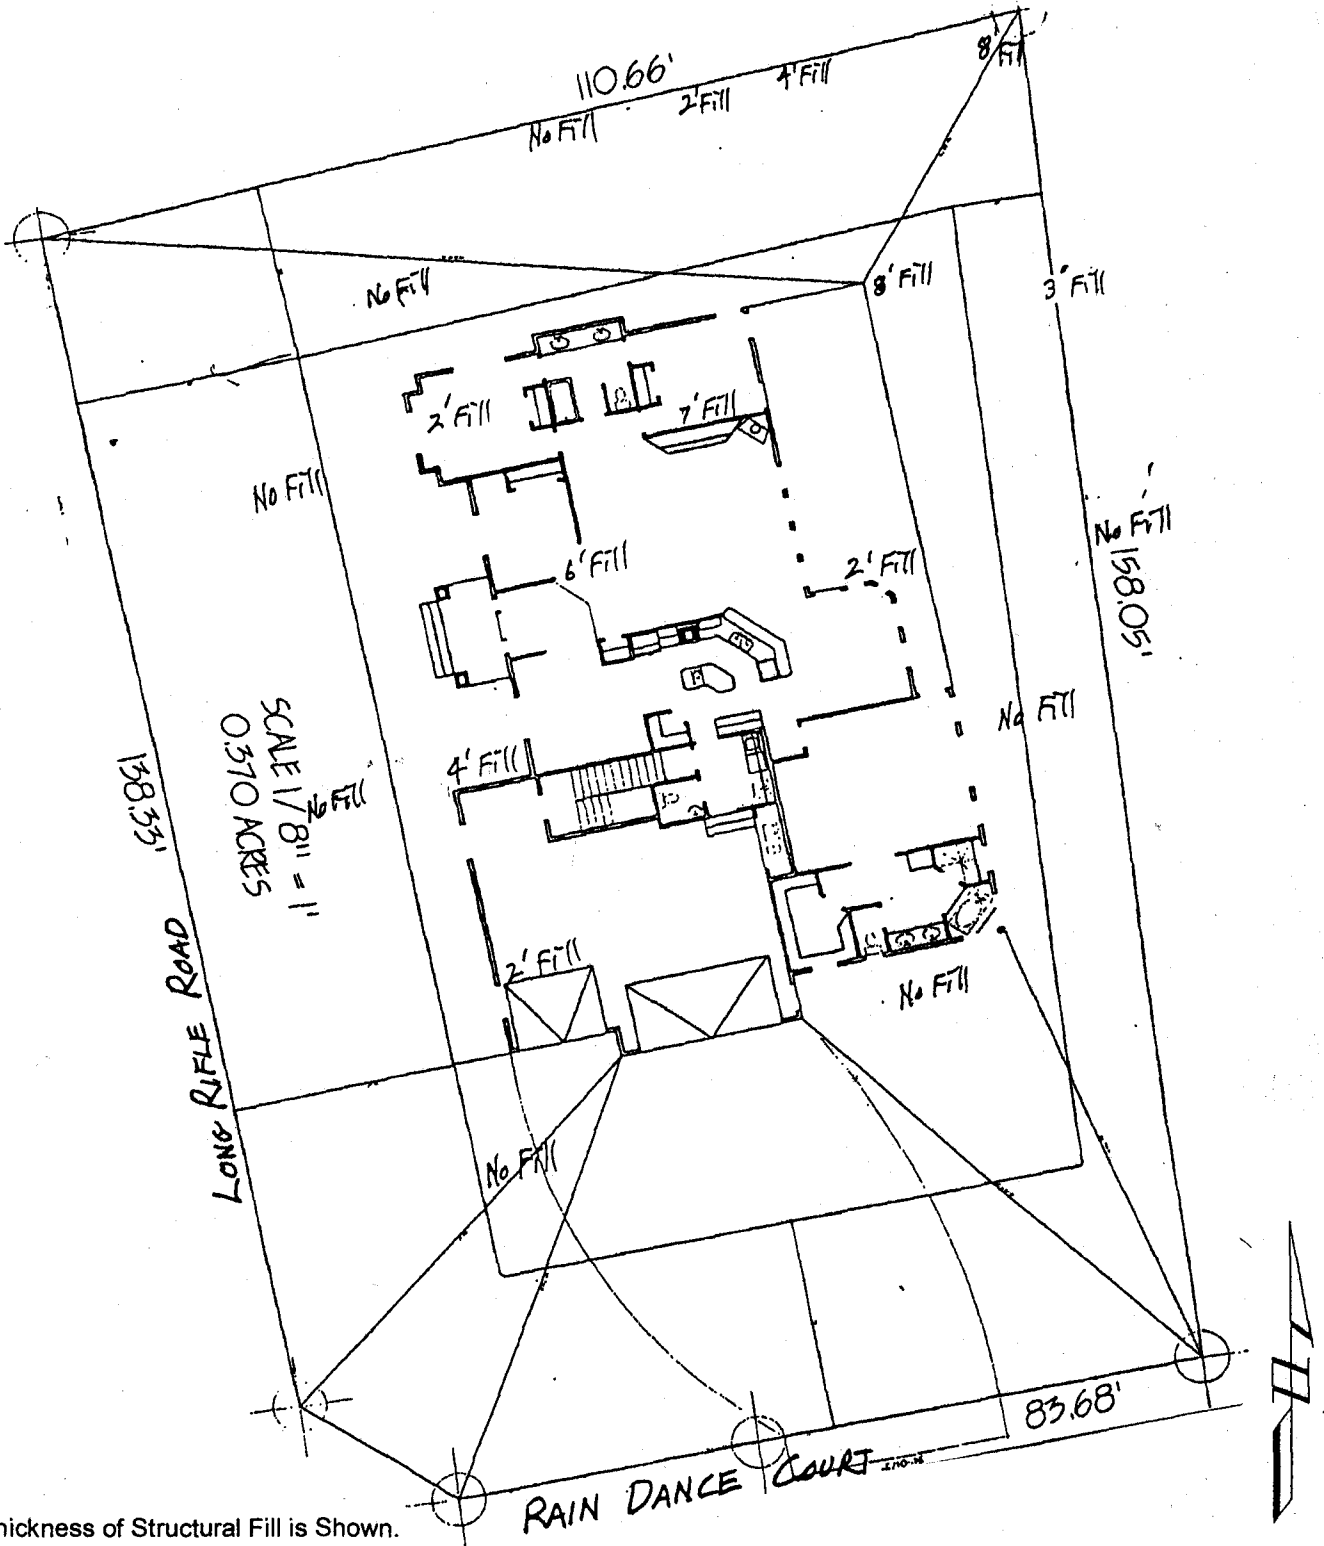


Thickness of Structural Fill is Shown.

Based Upon GJLD Records and Cut/Fill Mapping.

SKETCH From FISHER CONSTRUCTION Site Plan

### SITE LOCATION DIAGRAM

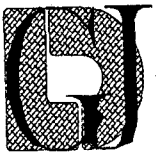

**GRAND JUNCTION  
LINCOLN - DeVORE, Inc.**

Geotechnical Consultants  
Grand Junction, Colorado


**SLOPE STABILITY REVIEW**  
2070 Raindance Court, Grand Junction, CO.

**FISHER CONSTRUCTION**  
Clifton, Colorado

Date  
8-5-2004

Job No.  
91208-GJ

Drawn  
EMM

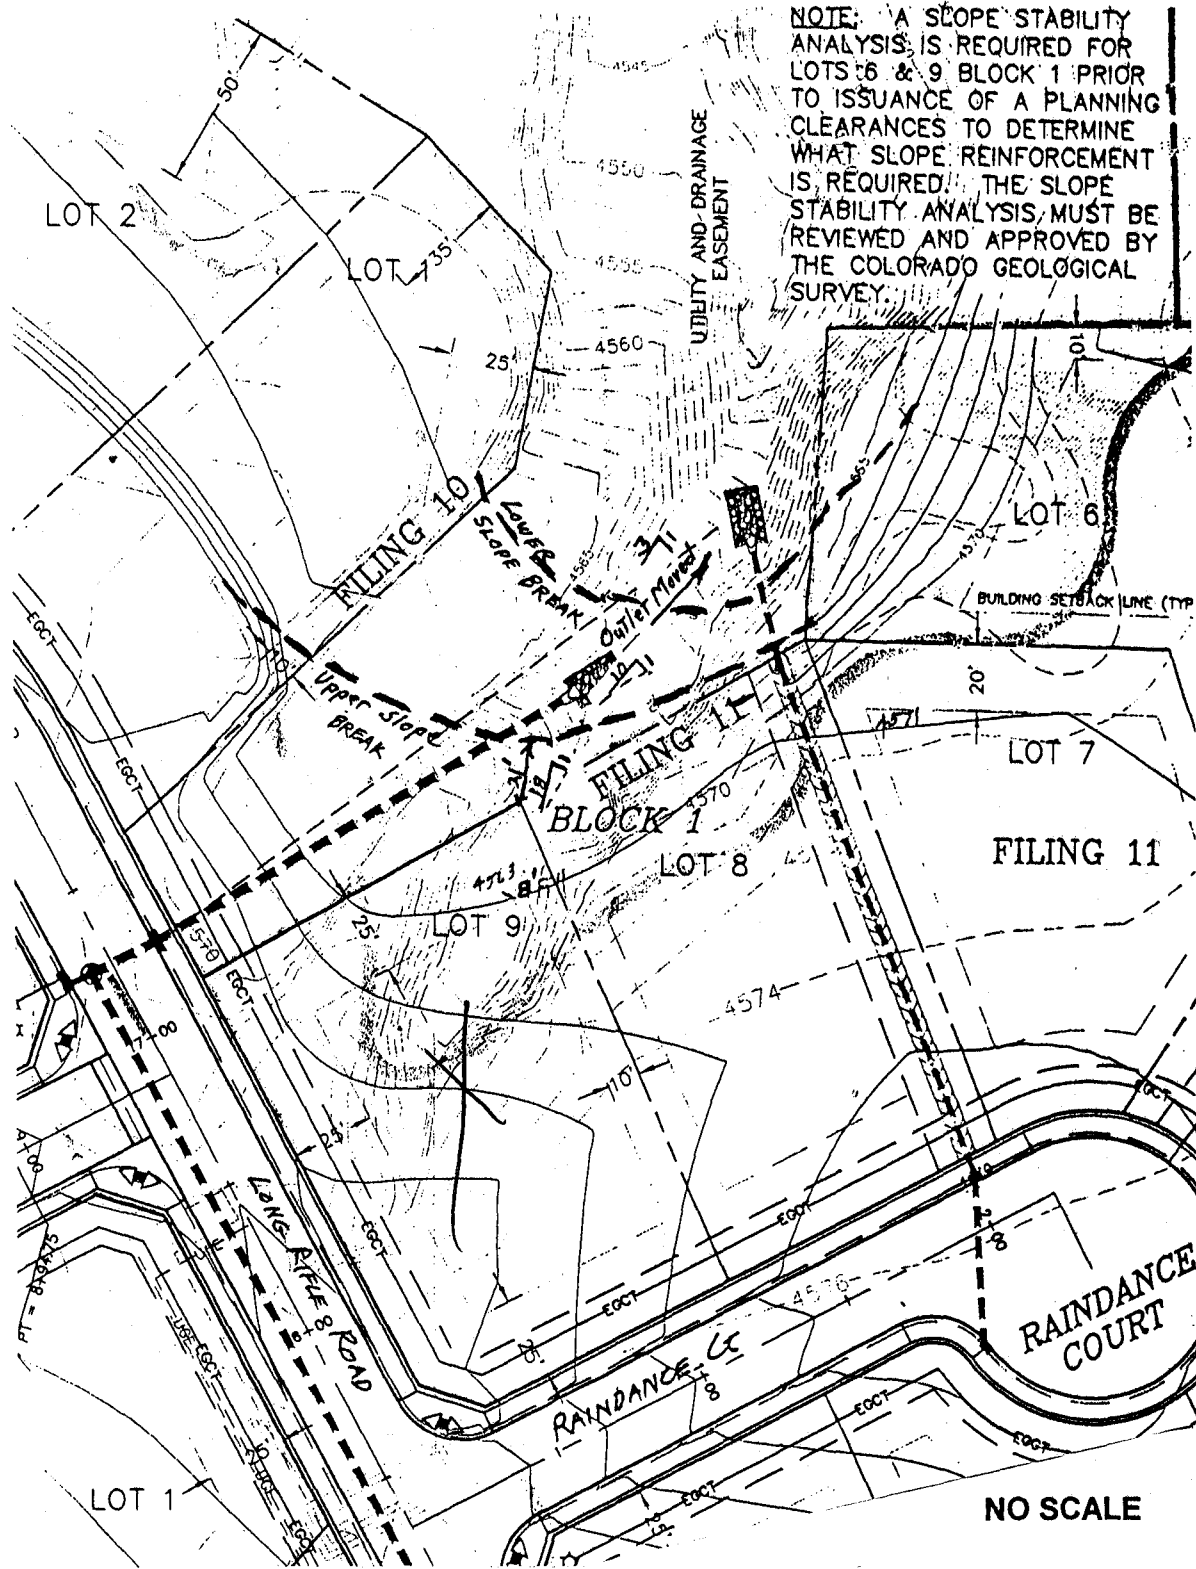

PLAN Adapted From THOMPSON-LANGFORD Drawing

**GENERAL SITE DIAGRAM**

**SLOPE STABILITY REVIEW**

2070 Raindance Court, Grand Junction, CO.

FISHER CONSTRUCTION

Date

Clifton, Colorado

8-5-2004

Job No.

Drawn

91208-GJ

EMM



**GRAND JUNCTION  
LINCOLN - DeVORE, Inc.**


Geotechnical Consultants  
Grand Junction, Colorado

Client: Laughing Waters, LLP	Report No: 12
Project: Independence Ranch Subdivision, Fil. 10/11	Date of Test: 6-10-03
Location:	Test By: RL
Rock correction applied to proctor, as needed.	GJLD Job No: 90235-GJ

TEST TYPE: Nuclear (ASTM 2922) Backscatter	Nuclear (ASTM 2922) Direct Trans. X	(ASTM D-1556) Sand Cone	SPECIFICATIONS: Project:	City: X	County:	State:
--	-------------------------------------	-------------------------	--------------------------	---------	---------	--------

Test No.	Location of Test	COMPACTION %	COMPAC. SPEC. %	MOISTURE CONT. %	MOISTURE SPEC. %	PROCTOR VALUE	SOIL TYPE
80	Controlled fill, Lot 3, Blk 1, Fil. 10 @ FSG	91	90	9.5	+2	129.0@9.5	NC
81	Controlled fill, Lot 2, Blk 1, Fil. 10 @ FSG	91	90	10.0	+2	129.0@9.5	NC
82	Controlled fill, Lot 1, Blk 1, Fil. 10 @ FSG	91	90	9.9	+2	129.0@9.5	NC
83	Controlled fill, Lot 9, Blk 1, Fil. 11 @ 2' fill hgt ←	92	90	9.5	+2	129.0@9.5	NC
84	Controlled fill, Lot 9, Blk 1, Fil. 11 @ 4' fill hgt ←	92	90	9.4	+2	129.0@9.5	NC
85	West edge Raindance Ct & Lot 8, Blk 1, Fil. 11 @ subgrade prep	93	90	9.2	+2	129.0@9.5	NC

DISTRIBUTION: 1-Client 1-TLC	KEY: * Fails Compaction Spec. C = Cohesive ** Fails Moisture Spec. NC = NonCohesive S Standard Proctor ABC = Aggregate Base M Modified Proctor PR = Pit Run	GRAND JUNCTION LINCOLN DeVORE, INC. BY: <i>RL</i>
		FILL DENSITY TEST DAILY REPORT


NOTE: Results indicate in-place soil densities at the locations and depths identified above. Grand Junction Lincoln DeVore has relied on the contractor to provide uniform mix placement and compactive effort throughout the fill area.	Nuclear Density Testing of 'pit run' or other coarse grained soils may require correction of Unit Weight And Water Content, ASTM D-4718. If soils contain oversize particles in excess of the limits of ASTM D-4718	Nuclear Density Testing is performed for acceptance control and is combined with visual and penetration methods.	 <b>GRAND JUNCTION LINCOLN DeVORE</b> Geotechnical Engineers-Geologists
--	---	--	---

Client: Laughing Waters, LLP	Report No: 13
Project: Independence Ranch Subdivision, Fil. 10/11	Date of Test: 6-11-03
Location:	Test By: RL, BK, DA
Rock correction applied to proctor, as needed.	GJLD Job No: 90235-GJ

TEST TYPE:	Nuclear (ASTM 2922) Backscatter	Nuclear (ASTM 2922) Direct Trans. X	(ASTM D-1556) Sand Cone	SPECIFICATIONS:	Project:	City: X	County:	State:
------------	---------------------------------	-------------------------------------	-------------------------	-----------------	----------	---------	---------	--------

Test No.	Location of Test	COMPACTION %	COMPAC. SPEC. %	MOISTURE CONT. %	MOISTURE SPEC. %	PROCTOR VALUE	SOIL TYPE
86	Controlled fill, Lot 8, Blk 1, Fil. 11 @ 2' fill hgt	92	90	9.5	+2	129.0@9.5	NC
87	Controlled fill, Lot 8, Blk 1, Fil. 11 @ 4' fill hgt	92	90	9.4	+2	129.0@9.5	NC
88	Controlled fill, Lot 9, Blk 1, Fil. 11 @ 6' fill hgt	94	90	9.4	+2	129.0@9.5	NC
89	Controlled fill, Lot 10, Blk 2, Fil. 10 @ 5' fill hgt	93	90	11.8	+2	123.0@11.0	NC
90	Controlled fill, Lot 9, Blk 2, Fil. 10 @ 5' fill hgt	94	90	10.6	+2	123.0@11.0	NC
91	Controlled fill, Lot 9, Blk 1, Fil 10 @ 2' fill hgt	90	90	8.6	+2	129.0@9.5	NC
92	Controlled fill, Lot 7, Blk 1, Fil. 10 @ 2' fill hgt	93	90	7.5	+2	129.0@9.5	NC
93	Controlled fill, Lot 6, Blk 2, Fil. 10 @ 2' fill hgt	96	90	8.7	+2	129.0@9.5	NC
94	Controlled fill, Lot 6, Blk 2, Fil. 10 @ FSG	90	90	7.8	+2	129.0@9.5	NC

DISTRIBUTION: 1-Client 1-TLC	KEY: * Fails Compaction Spec. C = Cohesive ** Fails Moisture Spec. NC = NonCohesive S Standard Proctor ABC = Aggregate Base M Modified Proctor PR = Pit Run	GRAND JUNCTION LINCOLN DeVORE, INC BY: <i>RL</i>
		FILL DENSITY TEST DAILY REPORT

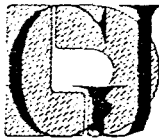NOTE: Results indicate in-place soil densities at the locations and depths identified above. Grand Junction Lincoln DeVore has relied on the contractor to provide uniform mix placement and compactive effort throughout the fill area.	Nuclear Density Testing of 'pit run' or other coarse grained soils may require correction of Unit Weight And Water Content, ASTM D-4718. If soils contain oversize particles in excess of the limits of ASTM D-4718	Nuclear Density Testing is performed for acceptance control and is combined with visual and penetration methods.	 <b>GRAND JUNCTION LINCOLN DeVORE</b> Geotechnical Engineers-Geologists
--	---	--	---