

FEE \$ 40.00
 TCP \$ 1500.00
 SIF \$ 292.00

PLANNING CLEARANCE
 (Single Family Residential and Accessory Structures)
Community Development Department

BLDG PERMIT NO. _____

Building Address 383 Rosemary
 Parcel No. 2943-191-36-005
 Subdivision White Willows
 Filing 2 Block 2 Lot 5

No. of Existing Bldgs 0 No. Proposed 1
 Sq. Ft. of Existing Bldgs _____ Sq. Ft. Proposed 1709
 Sq. Ft. of Lot / Parcel 8400
 Sq. Ft. Coverage of Lot by Structures & Impervious Surface
 (Total Existing & Proposed) 2490
 Height of Proposed Structure 22'

OWNER INFORMATION:

Name Don Broyles
 Address 181 Little Park Rd.
 City / State / Zip Grand Junction Co 81503

DESCRIPTION OF WORK & INTENDED USE:

New Single Family Home (*check type below)
 Interior Remodel Addition
 Other (please specify): _____

APPLICANT INFORMATION:

Name Same as Above
 Address _____
 City / State / Zip _____
 Telephone _____

***TYPE OF HOME PROPOSED:**

Site Built Manufactured Home (UBC)
 Manufactured Home (HUD)
 Other (please specify): _____

NOTES: _____

REQUIRED: One plot plan, on 8 1/2" x 11" paper, showing all existing & proposed structure location(s), parking, setbacks to all property lines, ingress/egress to the property, driveway location & width & all easements & rights-of-way which abut the parcel.

THIS SECTION TO BE COMPLETED BY COMMUNITY DEVELOPMENT DEPARTMENT STAFF			
ZONE <u>RSF-4</u>	Maximum coverage of lot by structures <u>50%</u>		
SETBACKS: Front <u>20'</u> from property line (PL)	Permanent Foundation Required: YES <input checked="" type="checkbox"/> NO <input type="checkbox"/>		
Side <u>7'</u> from PL Rear <u>25'</u> from PL	Parking Requirement <u>2</u>		
Maximum Height of Structure(s) <u>35'</u>	Special Conditions _____		
Voting District <u>"E"</u>	Driveway Location Approval <u>RAD</u> (Engineer's Initials)	<u>Eng Foundation Req'd</u>	

Modifications to this Planning Clearance must be approved, in writing, by the Community Development Department. The structure authorized by this application cannot be occupied until a final inspection has been completed and a Certificate of Occupancy has been issued, if applicable, by the Building Department (Section 305, Uniform Building Code).

I hereby acknowledge that I have read this application and the information is correct; I agree to comply with any and all codes, ordinances, laws, regulations or restrictions which apply to the project. I understand that failure to comply shall result in legal action, which may include but not necessarily be limited to non-use of the building(s).

Applicant Signature Don Broyles Date 9-24-05
 Department Approval St Clair Hall Date 10/12/05

Additional water and/or sewer tap fee(s) are required: YES <input checked="" type="checkbox"/> NO <input type="checkbox"/>	W/O No. <u>18478</u>
Utility Accounting <u>CM Marshall Co</u>	Date <u>11/12/05</u>

VALID FOR SIX MONTHS FROM DATE OF ISSUANCE (Section 2.2.C.1 Grand Junction Zoning & Development Code)
 (White: Planning) (Yellow: Customer) (Pink: Building Department) (Goldenrod: Utility Accounting)


383 ROSEMARY WAY

WHITE WILLOWS

FILING 2

LOT 5 BLK. 2

ACCEPTED *C. Jay Hall* 10/12/05
ANY CHANGE OF SETBACKS MUST BE APPROVED BY THE CITY PLANNING DEPT. IT IS THE APPLICANT'S RESPONSIBILITY TO PROPERLY LOCATE AND IDENTIFY EASEMENTS AND PROPERTY LINES.

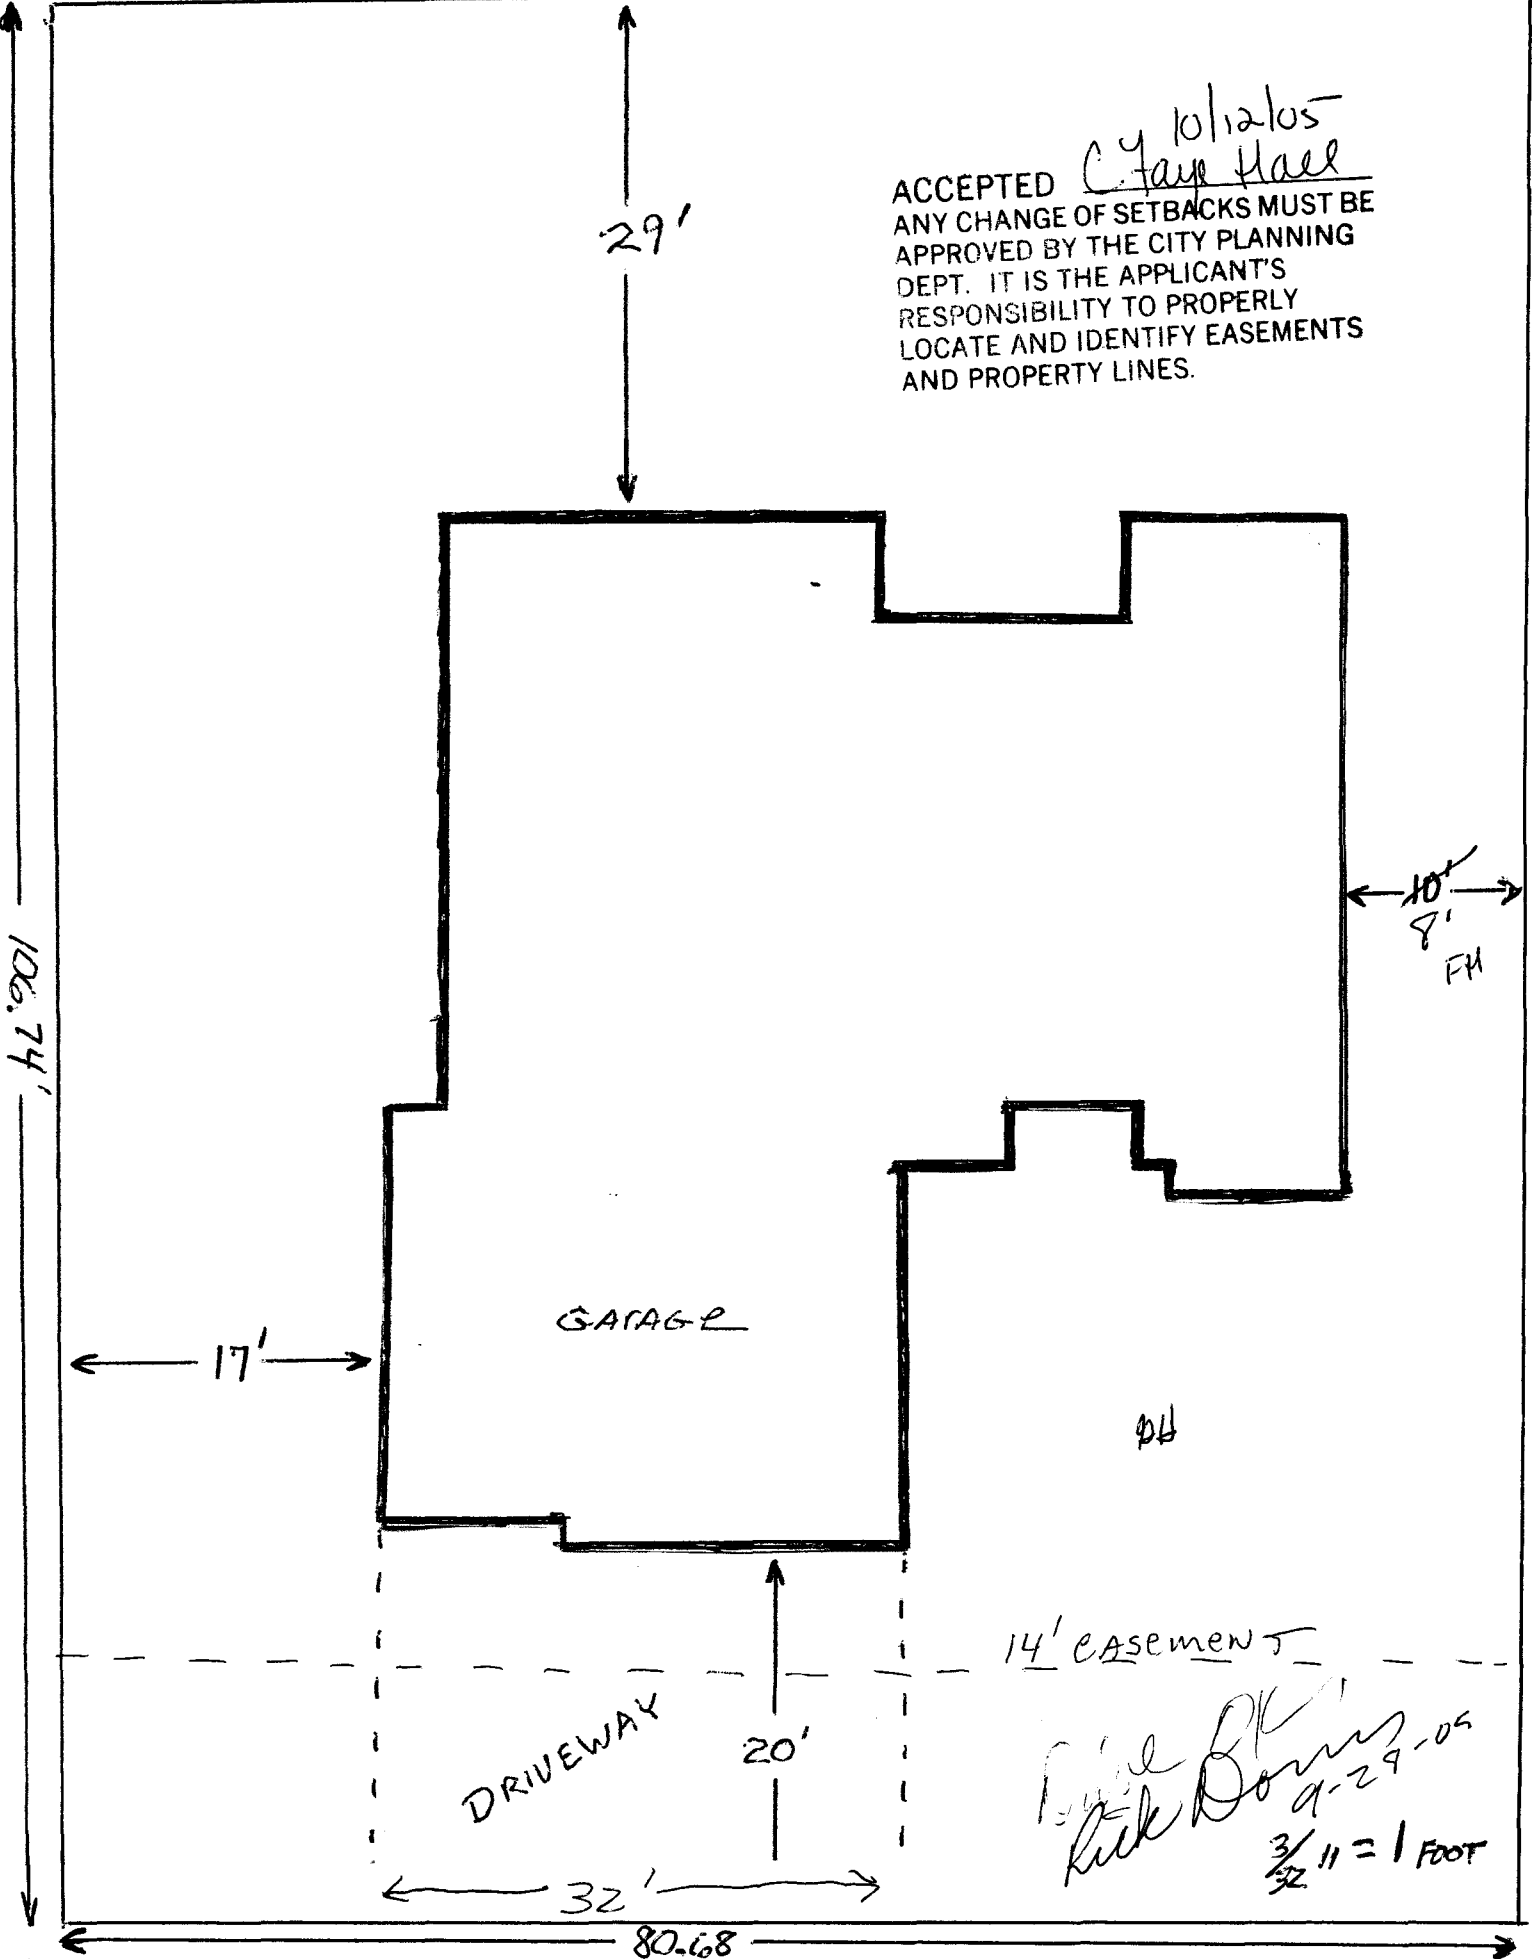

Final OK
Kirk Down 9-29-05
 $\frac{3}{32} = 1 \text{ FOOT}$