

FEE \$	10.00
TCP \$	0
SIF \$	292.00

PLANNING CLEARANCE
 (Single Family Residential and Accessory Structures)
Community Development Department

BLDG PERMIT NO. _____



Your Bridge to a Better Community

BLDG ADDRESS 715 Willow Creek RD SQ. FT. OF PROPOSED BLDGS/ADDITION 1529

TAX SCHEDULE NO. 2701-333-38-001 SQ. FT. OF EXISTING BLDGS 0

SUBDIVISION SPANISH TRAILS TOTAL SQ. FT. OF EXISTING & PROPOSED 1529

FILING 3 BLK 8 LOT 1 NO. OF DWELLING UNITS:
 Before: 0 After: 1 this Construction

(1) OWNER Custom Quality Homes NO. OF BUILDINGS ON PARCEL
 Before: 0 After: 1 this Construction

(1) ADDRESS 237 W 1st St. USE OF EXISTING BUILDINGS _____

(1) TELEPHONE 201 2371 DESCRIPTION OF WORK & INTENDED USE SFR.

(2) APPLICANT Tom Heilig TYPE OF HOME PROPOSED:
 Site Built _____ Manufactured Home (UBC)
 _____ Manufactured Home (HUD)
 _____ Other (please specify) _____

(2) ADDRESS 237 W 1st St.

(2) TELEPHONE 464 9345

REQUIRED: One plot plan, on 8 1/2" x 11" paper, showing all existing & proposed structure location(s), parking, setbacks to all property lines, ingress/egress to the property, driveway location & width & all easements & rights-of-way which abut the parcel.

THIS SECTION TO BE COMPLETED BY COMMUNITY DEVELOPMENT DEPARTMENT STAFF

ZONE PD Maximum coverage of lot by structures 6090

SETBACKS: Front 20' from property line (PL) Permanent Foundation Required: YES NO _____
 or _____ from center of ROW, whichever is greater

Side 5' from PL, Rear 20' from PL Parking Req'mt 2 *Note Drainage Requirements*

Maximum Height 32' Special Conditions Letter from Engineer Required

CENSUS B TRAFFIC _____ ANNEX# _____

Modifications to this Planning Clearance must be approved, in writing, by the Community Development Department. The structure authorized by this application cannot be occupied until a final inspection has been completed and a Certificate of Occupancy has been issued, if applicable, by the Building Department (Section 305, Uniform Building Code).

I hereby acknowledge that I have read this application and the information is correct; I agree to comply with any and all codes, ordinances, laws, regulations or restrictions which apply to the project. I understand that failure to comply shall result in legal action, which may include but not necessarily be limited to non-use of the building(s).

Applicant Signature: Thomas & Nancy Date 3/10/04

Department Approval: Steve Mason Date 3/11/04

Additional water and/or sewer tap fee(s) are required:	YES <input checked="" type="checkbox"/>	NO _____	W/O No. <u>17061</u>
Utility Accounting	<u>Over</u>	Date	<u>3-11-03</u>

VALID FOR SIX MONTHS FROM DATE OF ISSUANCE (Section 9-3-2C Grand Junction Zoning & Development Code)

(White: Planning) (Yellow: Customer) (Pink: Building Department) (Goldenrod: Utility Accounting)


74'

ACCEPTED *W/SLM Major 3-11-04*
ANY CHANGE OF SETBACKS MUST BE APPROVED BY THE CITY PLANNING DEPT. IT IS THE APPLICANT'S RESPONSIBILITY TO PROPERLY LOCATE AND IDENTIFY EASEMENTS AND PROPERTY LINES.

20'6"

58'8"

5'5"

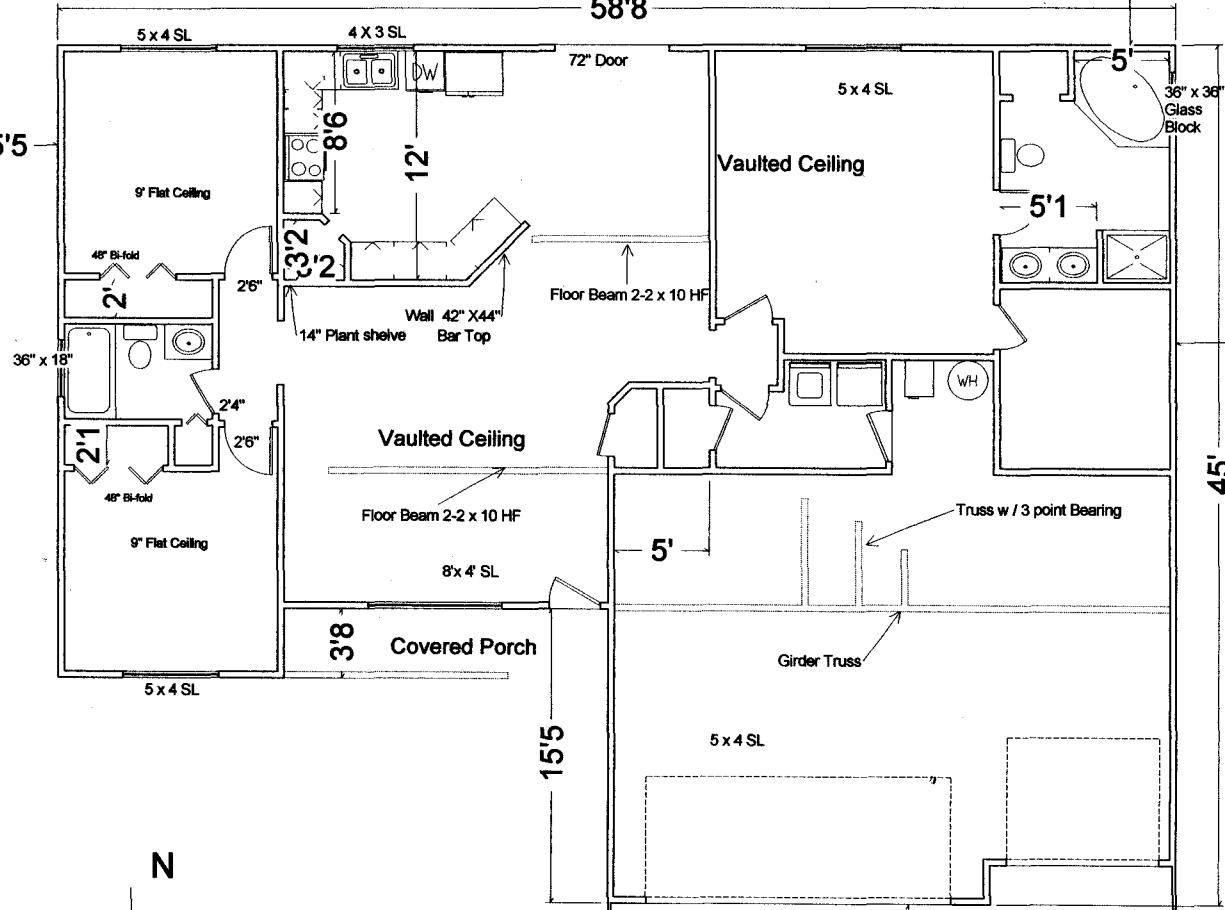

*gle
w
3/12/04*

Custom Quality Homes Inc.
715 Willow creek Rd.
lot 1 block 8 Ph 3
Spanish Trails Subdivision