

Planning \$ <u>10.00</u>	Drainage \$ <u>0</u>
TCP \$ <u>0</u>	School Impact \$ <u>0</u>

BLDG PERMIT NO.
FILE #

PLANNING CLEARANCE

(site plan review, multi-family development, non-residential development)

Grand Junction Community Development Department

62993-35762

THIS SECTION TO BE COMPLETED BY APPLICANT

BUILDING ADDRESS <u>790 26 1/2 RD</u>	TAX SCHEDULE NO. <u>2701-351-60-951</u>
SUBDIVISION _____	SQ. FT. OF EXISTING BLDG(S) _____
FILING _____ BLK _____ LOT _____	SQ. FT. OF PROPOSED BLDG(S)/ADDITONS <u>420</u> <input checked="" type="checkbox"/>
OWNER <u>BISHOP OF RUEBLO #</u>	MULTI-FAMILY: NO. OF DWELLING UNITS: BEFORE _____ AFTER _____
OWNER <u>IMMACULATE HEART CATHOLIC CHURCH</u>	CONSTRUCTION
ADDRESS <u>790 26 1/2 RD</u>	NO. OF BLDGS ON PARCEL: BEFORE _____ AFTER _____
CITY/STATE/ZIP <u>GRAND JCT. CO. 81506</u>	CONSTRUCTION
APPLICANT <u>DIETER W. KUBISCH</u>	USE OF ALL EXISTING BLDG(S) <u>Rectory</u>
ADDRESS <u>230 28 3/4 RD</u>	DESCRIPTION OF WORK & INTENDED USE: _____
CITY/STATE/ZIP <u>GRAND JCT. CO 81503</u>	<u>PATIO COVER</u>
TELEPHONE <u>243-7861</u>	

Submittal requirements are outlined in the SSID (Submittal Standards for Improvements and Development) document.

THIS SECTION TO BE COMPLETED BY COMMUNITY DEVELOPMENT DEPARTMENT STAFF

ZONE <u>RSF-4</u>	LANDSCAPING/SCREENING REQUIRED: YES _____ NO <input checked="" type="checkbox"/>
SETBACKS: FRONT: _____ from Property Line (PL) or _____ from center of ROW, whichever is greater	PARKING REQUIREMENT: <u>N/A</u>
SIDE: _____ from PL REAR: _____ from PL	SPECIAL CONDITIONS: <u>Covering existing concrete slab area w/ a 14' x 30' cover.</u>
MAX. HEIGHT _____	
MAX. COVERAGE OF LOT BY STRUCTURES _____	

Modifications to this Planning Clearance must be approved, in writing, by the Community Development Department Director. The structure authorized by this application cannot be occupied until a final inspection has been completed and a Certificate of Occupancy has been issued by the Building Department (Section 307, Uniform Building Code). Required improvements in the public right-of-way must be guaranteed prior to issuance of a Planning Clearance. All other required site improvements must be completed or guaranteed prior to issuance of a Certificate of Occupancy. Any landscaping required by this permit shall be maintained in an acceptable and healthy condition. The replacement of any vegetation materials that die or are in an unhealthy condition is required by the Grand Junction Zoning and Development Code.

Four (4) sets of final construction drawings must be submitted and stamped by City Engineering prior to issuing the Planning Clearance. One stamped set must be available on the job site at all times.

I hereby acknowledge that I have read this application and the information is correct; I agree to comply with any and all codes, ordinances, laws, regulations, or restrictions which apply to the project. I understand that failure to comply shall result in legal action, which may include but not necessarily be limited to non-use of the building(s).

Applicant's Signature <u>Dieter W. Kubisch</u>	Date <u>10/4/05</u>
Department Approval <u>C. Jay Hall</u>	Date <u>10/4/05</u>

Additional water and/or sewer tap fee(s) are required:	YES	NO <input checked="" type="checkbox"/>	W/O No. <u>N/A</u>
Utility Accounting <u>CU</u>	Date <u>10/4/05</u>		


VALID FOR SIX MONTHS FROM DATE OF ISSUANCE (Section 2.2.C.1 Grand Junction Zoning and Development Code)

(White: Planning) (Yellow: Customer) (Pink: Building Department) (Goldenrod: Utility Accounting)

Immaculate Heart Church
Site Location
790 26 1/2 Road

Not to Scale

ACCEPTED *C. J. 10/4/05*
Clay Hall
ANY CHANGE OF SETBACKS MUST BE
APPROVED BY THE CITY PLANNING
DEPT. IT IS THE APPLICANT'S
RESPONSIBILITY TO PROPERLY
LOCATE AND IDENTIFY EASEMENTS
AND PROPERTY LINES.

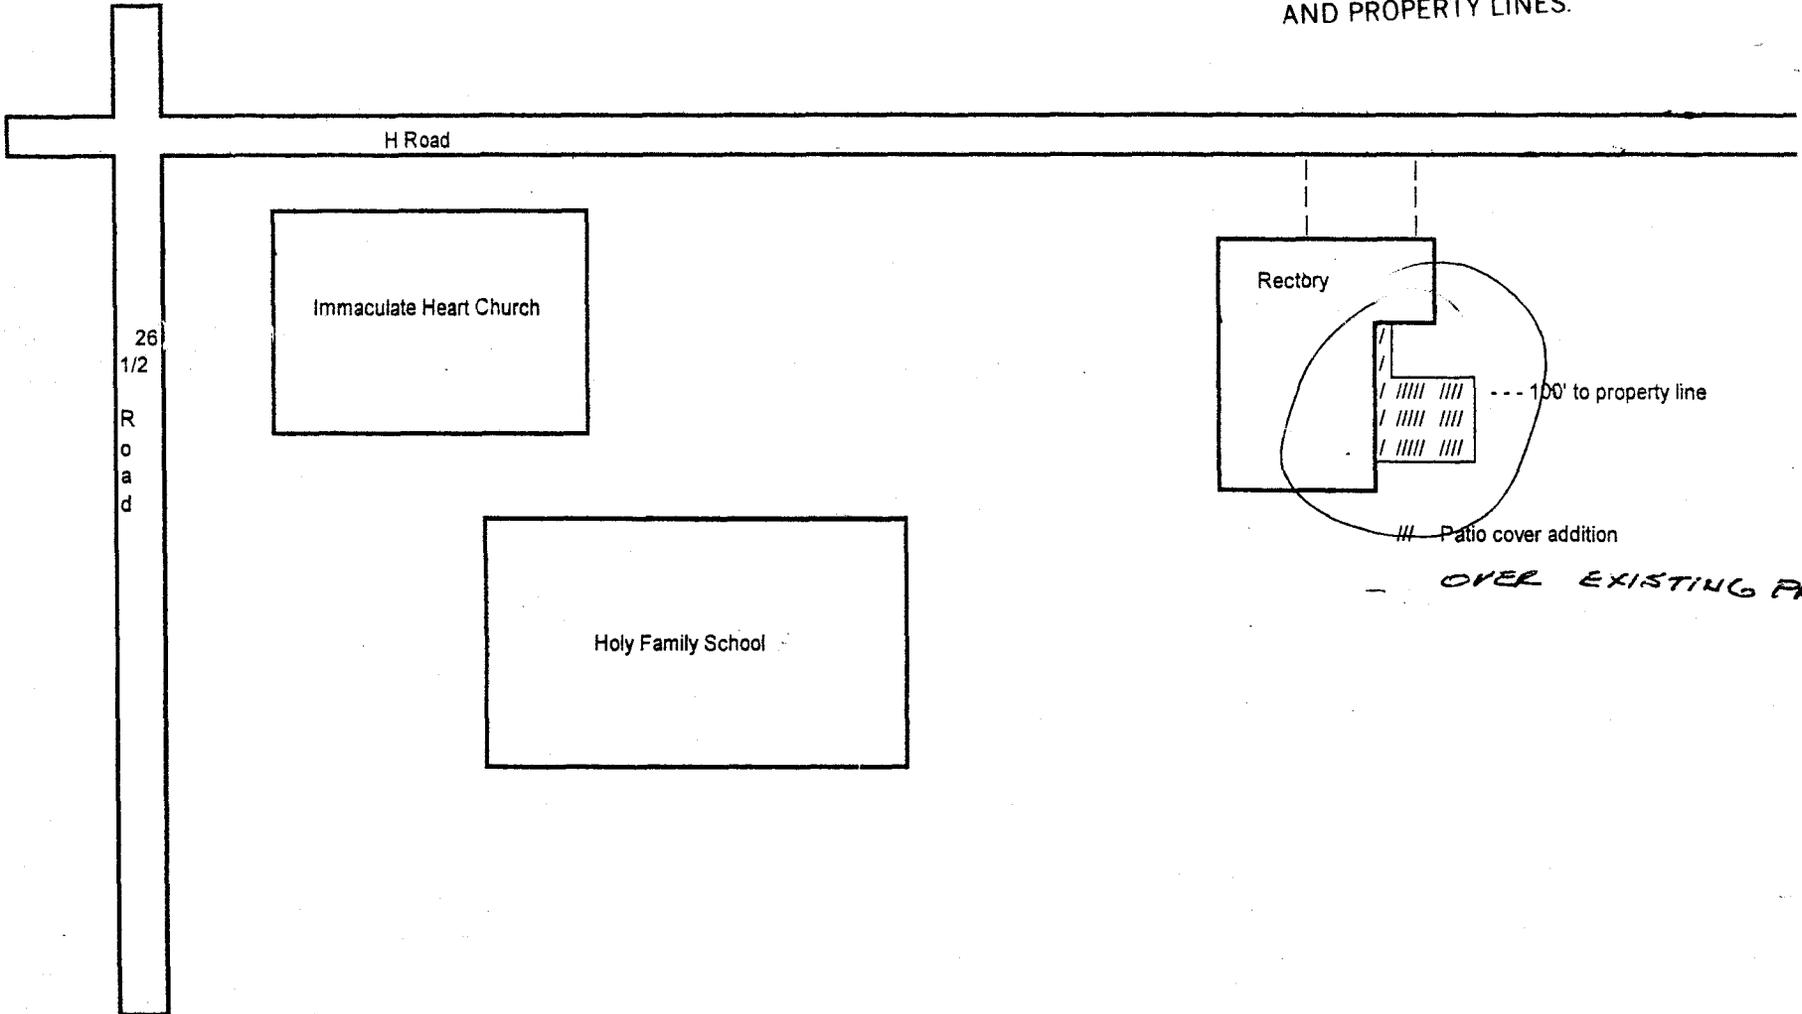

OVER EXISTING PATIO