

FEE \$	10.00
TCP \$	1500.00
SIF \$	292.00

PLANNING CLEARANCE
 (Single Family Residential and Accessory Structures)
Community Development Department

BLDG PERMIT NO. _____

Building Address 706 Caleb St.
 Parcel No. 2701-343-00-170 (Parent Number)
 Subdivision ARCADIA NORTH
 Filing 1 Block 1 Lot 4

No. of Existing Bldgs 0 No. Proposed 1
 Sq. Ft. of Existing Bldgs 0 Sq. Ft. Proposed House 1650 Garage 875
 Sq. Ft. of Lot / Parcel 20 Acre
 Sq. Ft. Coverage of Lot by Structures & Impervious Surface (Total Existing & Proposed) 2525

OWNER INFORMATION:

Name Stremel Homes LLC
 Address 816 ELBERTA AVE
 City / State / Zip Palisade, CO 81526

DESCRIPTION OF WORK & INTENDED USE:

- New Single Family Home (*check type below)
- Interior Remodel Addition
- Other (please specify): _____

APPLICANT INFORMATION:

Name SAME
 Address _____
 City / State / Zip _____
 Telephone 201-6444

***TYPE OF HOME PROPOSED:**

- Site Built Manufactured Home (UBC)
- Manufactured Home (HUD)
- Other (please specify): _____

NOTES: _____

REQUIRED: One plot plan, on 8 1/2" x 11" paper, showing all existing & proposed structure location(s), parking, setbacks to all property lines, ingress/egress to the property, driveway location & width & all easements & rights-of-way which abut the parcel.

THIS SECTION TO BE COMPLETED BY COMMUNITY DEVELOPMENT DEPARTMENT STAFF	
ZONE <u>RSF-4</u>	Maximum coverage of lot by structures <u>50%</u>
SETBACKS: Front <u>20'</u> from property line (PL)	Permanent Foundation Required: YES <u>X</u> NO _____
Side <u>7'</u> from PL Rear <u>25'</u> from PL	Parking Requirement <u>2</u>
Maximum Height of Structure(s) <u>35'</u>	Special Conditions _____
Voting District <u>B</u> Driveway Location Approval <u>W</u> (Engineer's Initials)	


Modifications to this Planning Clearance must be approved, in writing, by the Community Development Department. The structure authorized by this application cannot be occupied until a final inspection has been completed and a Certificate of Occupancy has been issued, if applicable, by the Building Department (Section 305, Uniform Building Code).

I hereby acknowledge that I have read this application and the information is correct; I agree to comply with any and all codes, ordinances, laws, regulations or restrictions which apply to the project. I understand that failure to comply shall result in legal action, which may include but not necessarily be limited to non-use of the building(s).

Applicant Signature [Signature] Date 7-10-05
 Department Approval [Signature] Date 7-13-05

Additional water and/or sewer tap fee(s) are required:	YES <u>X</u>	NO _____	W/O No. <u>18230</u>
Utility Accounting <u>[Signature]</u>	Date <u>7/13/05</u>		

VALID FOR SIX MONTHS FROM DATE OF ISSUANCE (Section 2.2.C.1 Grand Junction Zoning & Development Code)
 (White: Planning) (Yellow: Customer) (Pink: Building Department) (Goldenrod: Utility Accounting)

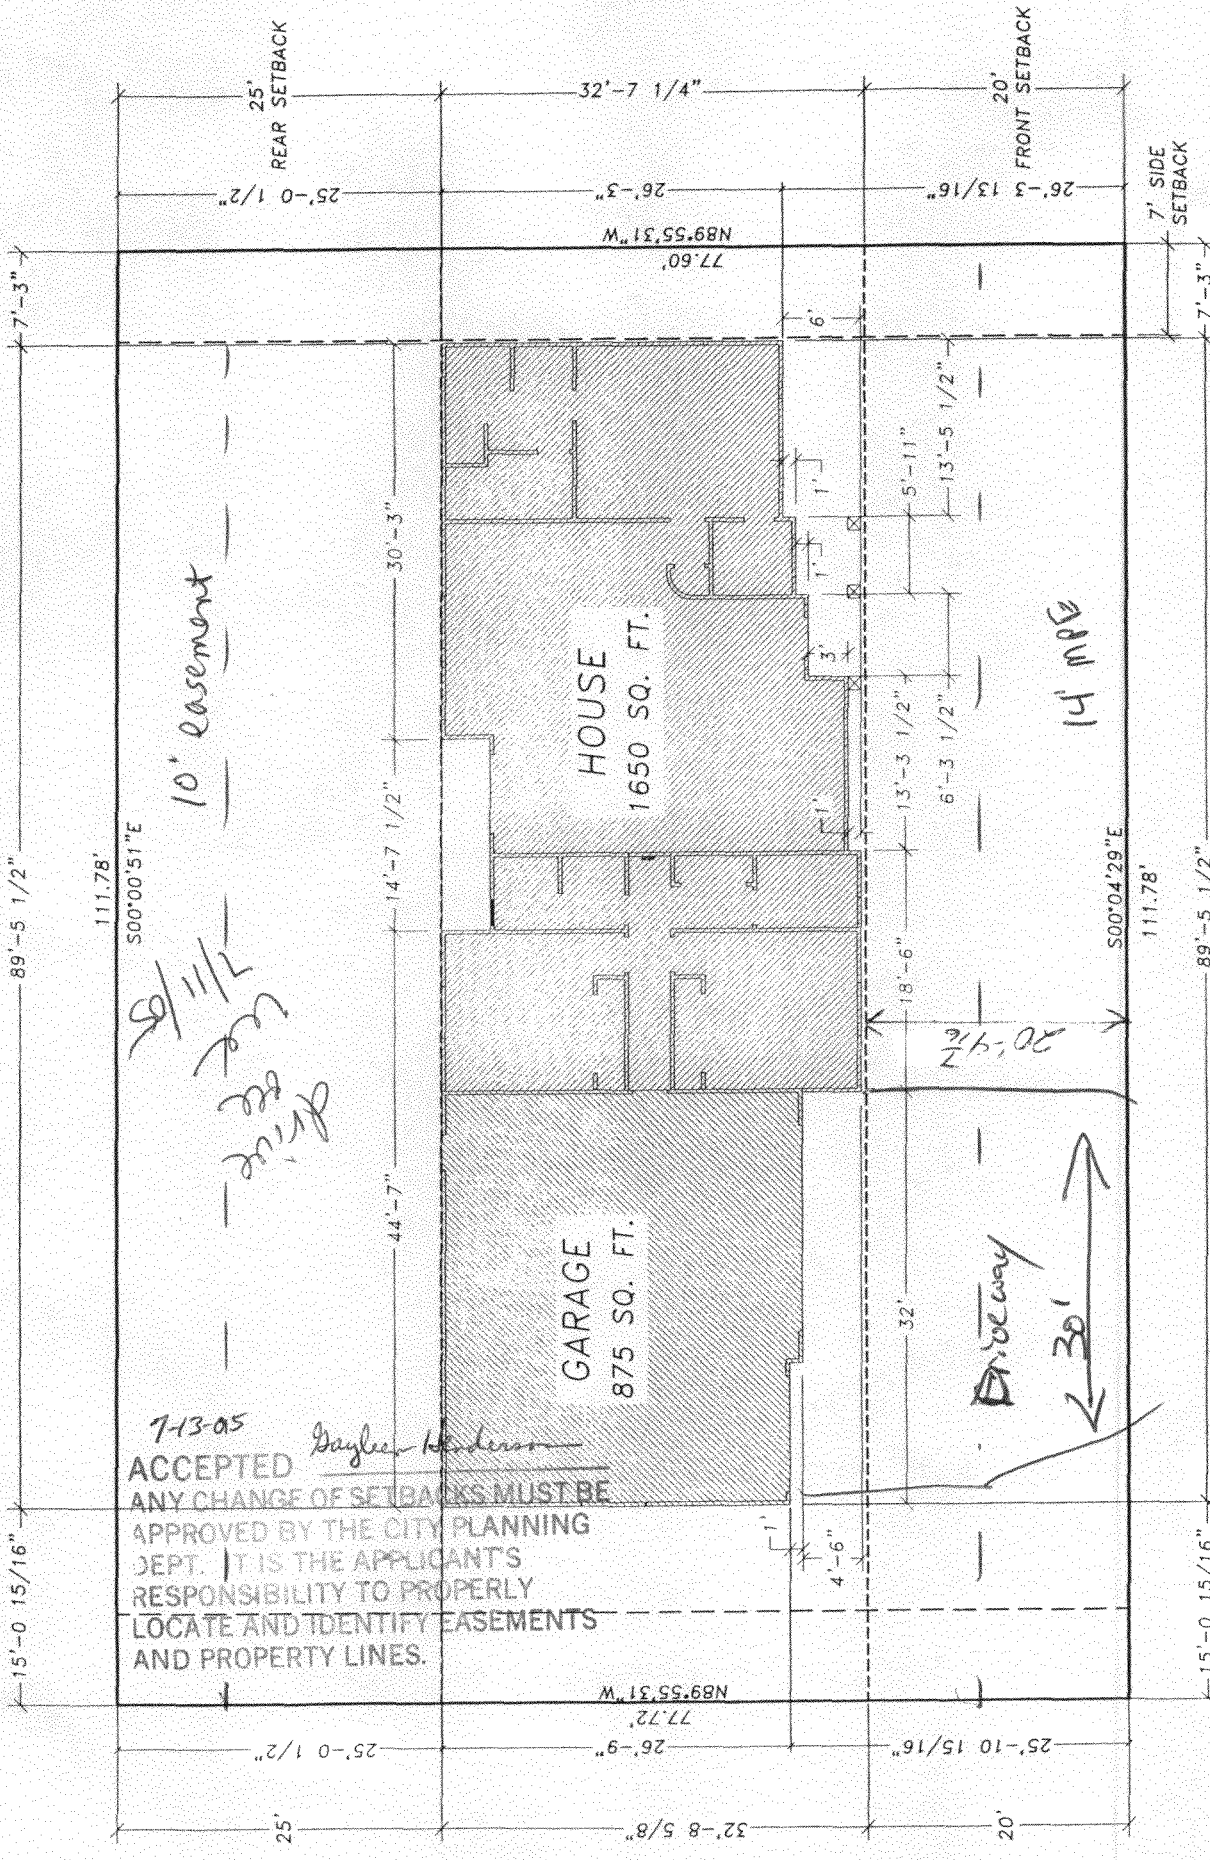

7-13-05
 ACCEPTED *Dayle Henderson*
 ANY CHANGE OF SETBACKS MUST BE APPROVED BY THE CITY PLANNING DEPT. IT IS THE APPLICANT'S RESPONSIBILITY TO PROPERLY LOCATE AND IDENTIFY EASEMENTS AND PROPERTY LINES.

10' easement

HOUSE
 1650 SQ. FT.

GARAGE
 875 SQ. FT.

14' MRE

Driveway

706 CALEB STREET
 LOT 4, BLOCK 1
 ARCADIA NORTH SUBDIVISION
 GRAND JUNCTION, CO

CALEB STREET

