

FEE \$ 10.00
TCP \$ 1500.00
SIF \$ 292.00

PLANNING CLEARANCE 
 (Single Family Residential and Accessory Structures)
Community Development Department

BLDG PERMIT NO. _____

Building Address 708 Caleb St.
 Parcel No. 2701-343-00-170 (PARENT Number)
 Subdivision Arcadia North
 Filing 1 Block 1 Lot 5

No. of Existing Bldgs 0 No. Proposed 1
 Sq. Ft. of Existing Bldgs 0 Sq. Ft. Proposed 1798
 Sq. Ft. of Lot / Parcel .24
 Sq. Ft. Coverage of Lot by Structures & Impervious Surface (Total Existing & Proposed) 2822

OWNER INFORMATION:

Name Stremel Homes LLC
 Address 816 ELBERTA AVE
 City / State / Zip Palisade, CO 81524

DESCRIPTION OF WORK & INTENDED USE:

New Single Family Home (*check type below)
 Interior Remodel Addition
 Other (please specify): _____

APPLICANT INFORMATION:

Name _____
 Address 8AM-1
 City / State / Zip _____
 Telephone 201-6444

***TYPE OF HOME PROPOSED:**

Site Built Manufactured Home (UBC)
 Manufactured Home (HUD)
 Other (please specify): _____

NOTES: _____

REQUIRED: One plot plan, on 8 1/2" x 11" paper, showing all existing & proposed structure location(s), parking, setbacks to all property lines, ingress/egress to the property, driveway location & width & all easements & rights-of-way which abut the parcel.

THIS SECTION TO BE COMPLETED BY COMMUNITY DEVELOPMENT DEPARTMENT STAFF	
ZONE <u>RSF-4</u>	Maximum coverage of lot by structures <u>50%</u>
SETBACKS: Front <u>20'</u> from property line (PL)	Permanent Foundation Required: YES <u>X</u> NO _____
Side <u>7'</u> from PL Rear <u>25'</u> from PL	Parking Requirement <u>2</u>
Maximum Height of Structure(s) <u>35'</u>	Special Conditions _____
Voting District <u>B</u>	Driveway Location Approval <u>M</u> (Engineer's Initials)

Modifications to this Planning Clearance must be approved, in writing, by the Community Development Department. The structure authorized by this application cannot be occupied until a final inspection has been completed and a Certificate of Occupancy has been issued, if applicable, by the Building Department (Section 305, Uniform Building Code).


I hereby acknowledge that I have read this application and the information is correct; I agree to comply with any and all codes, ordinances, laws, regulations or restrictions which apply to the project. I understand that failure to comply shall result in legal action, which may include but not necessarily be limited to non-use of the building(s).

Applicant Signature [Signature] Date 7-6-05
 Department Approval [Signature] Date 7-13-05

Additional water and/or sewer tap fee(s) are required: YES <u>X</u> NO _____	W/O No. <u>18231</u>
Utility Accounting <u>[Signature]</u>	Date <u>7/13/05</u>

VALID FOR SIX MONTHS FROM DATE OF ISSUANCE (Section 2.2.C.1 Grand Junction Zoning & Development Code)
 (White: Planning) (Yellow: Customer) (Pink: Building Department) (Goldenrod: Utility Accounting)

10-7¹³/₁₆

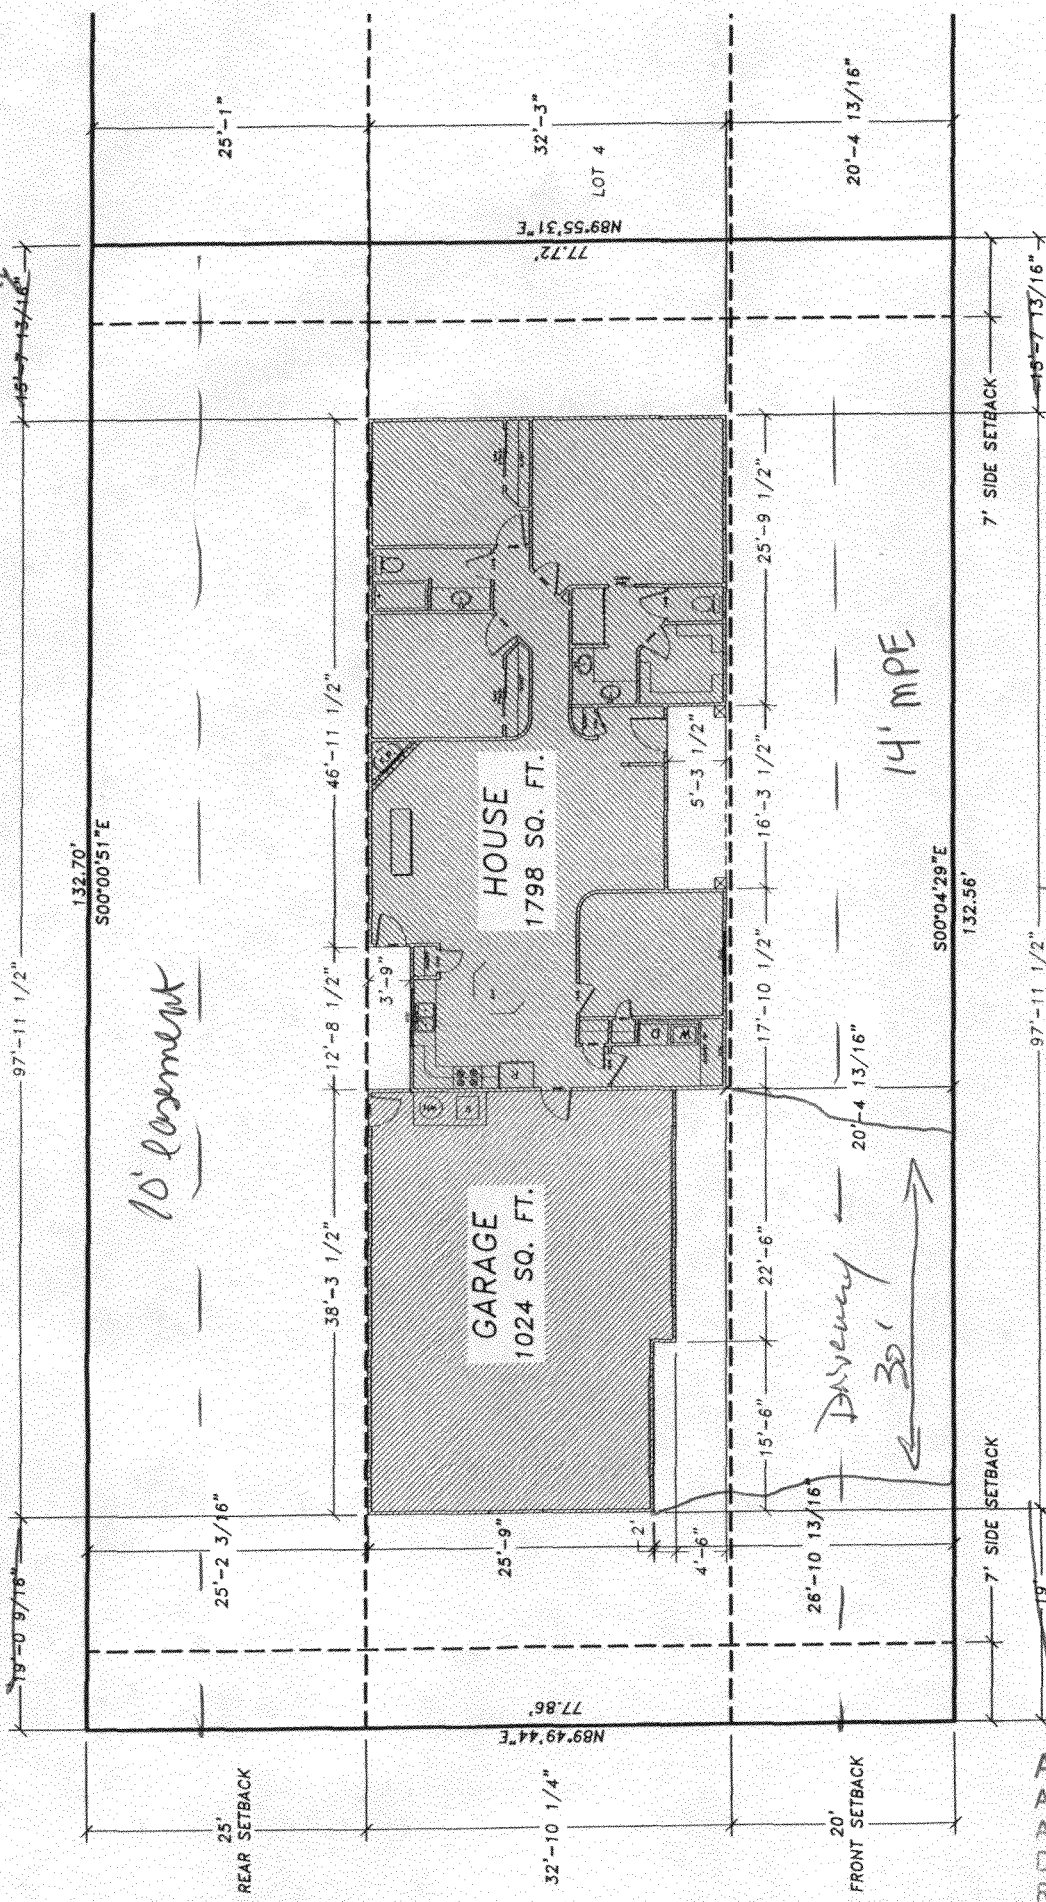

LOT 5, BLOCK 1
 ARCADIA NORTH
 SUBDIVISION

708 Caleb

Drive

507/10/05

7' SIDE SETBACK



7-13-05

ACCEPTED Dayleen Henderson
 ANY CHANGE OF SETBACKS MUST BE APPROVED BY THE CITY PLANNING DEPT. IT IS THE APPLICANT'S RESPONSIBILITY TO PROPERLY LOCATE AND IDENTIFY EASEMENTS AND PROPERTY LINES.