

FEE \$	10.00
TCP \$	/
SIF \$	/

**PLANNING CLEARANCE** (a)  
 (Single Family Residential and Accessory Structures)  
Community Development Department

BLDG PERMIT NO. \_\_\_\_\_

Building Address 307 N Cherry Ln  
 Parcel No. 2945-244-00-143  
 Subdivision \_\_\_\_\_  
 Filing \_\_\_\_\_ Block \_\_\_\_\_ Lot \_\_\_\_\_

No. of Existing Bldgs 2 No. Proposed \_\_\_\_\_  
 Sq. Ft. of Existing Bldgs 1200 Sq. Ft. Proposed \_\_\_\_\_  
 Sq. Ft. of Lot / Parcel .171  
 Sq. Ft. Coverage of Lot by Structures & Impervious Surface (Total Existing & Proposed) \_\_\_\_\_  
 Height of Proposed Structure \_\_\_\_\_

**OWNER INFORMATION:**

Name Henry Billet  
 Address 307 Cherry LN  
 City / State / Zip Grand Junction, CO 81503

**DESCRIPTION OF WORK & INTENDED USE:**

- New Single Family Home (\*check type below)
- Interior Remodel  Addition
- Other (please specify): Small deck off existing floor on second floor of house

**APPLICANT INFORMATION:**

Name \_\_\_\_\_  
 Address SAME  
 City / State / Zip \_\_\_\_\_  
 Telephone \_\_\_\_\_

**\*TYPE OF HOME PROPOSED:**

- Site Built  Manufactured Home (UBC)
- Manufactured Home (HUD)
- Other (please specify): \_\_\_\_\_

NOTES: Deck on 2nd floor, supports must meet setback requirements.

**REQUIRED: One plot plan, on 8 1/2" x 11" paper, showing all existing & proposed structure location(s), parking, setbacks to all property lines, ingress/egress to the property, driveway location & width & all easements & rights-of-way which abut the parcel.**

<b>THIS SECTION TO BE COMPLETED BY COMMUNITY DEVELOPMENT DEPARTMENT STAFF</b>	
ZONE <u>RMF-8</u>	Maximum coverage of lot by structures <u>70%</u>
SETBACKS: Front <u>20'</u> from property line (PL)	Permanent Foundation Required: <u>YES</u> NO _____
Side <u>5'</u> from PL Rear <u>10'</u> from PL	Parking Requirement <u>see Section 3.2.E.2.m.</u>
Maximum Height of Structure(s) <u>35'</u>	Special Conditions <u>Uncovered, unenclosed terraces or porches not to exceed 6ft. but in no case closer than 3ft' to any property line</u>
Voting District _____	Driveway Location Approval _____ (Engineer's Initials)

Modifications to this Planning Clearance must be approved, in writing, by the Community Development Department. The structure authorized by this application cannot be occupied until a final inspection has been completed and a Certificate of Occupancy has been issued, if applicable, by the Building Department (Section 305, Uniform Building Code).

I hereby acknowledge that I have read this application and the information is correct; I agree to comply with any and all codes, ordinances, laws, regulations or restrictions which apply to the project. I understand that failure to comply shall result in legal action, which may include but not necessarily be limited to non-use of the building(s).

Applicant Signature H Billet Date 2-11-05  
 Department Approval B Paulson Date 2-11-05

Additional water and/or sewer tap fee(s) are required:	YES	NO <input checked="" type="checkbox"/>	W/O No.
Utility Accounting <u>U Benseley</u>	Date <u>2/11/05</u>		

VALID FOR SIX MONTHS FROM DATE OF ISSUANCE (Section 2.2.C.1 Grand Junction Zoning & Development Code)  
 (White: Planning) (Yellow: Customer) (Pink: Building Department) (Goldenrod: Utility Accounting)




307 N. Cherry Ln

ACCEPTED *B Paulson 1/1/15*

OLSON AVE

ANY CHANGE OF SETBACKS MUST BE APPROVED BY THE CITY PLANNING DEPARTMENT. THE APPLICANT'S RESPONSIBILITY TO PROPERLY LOCATE AND IDENTIFY EASEMENTS AND PROPERTY LINES.

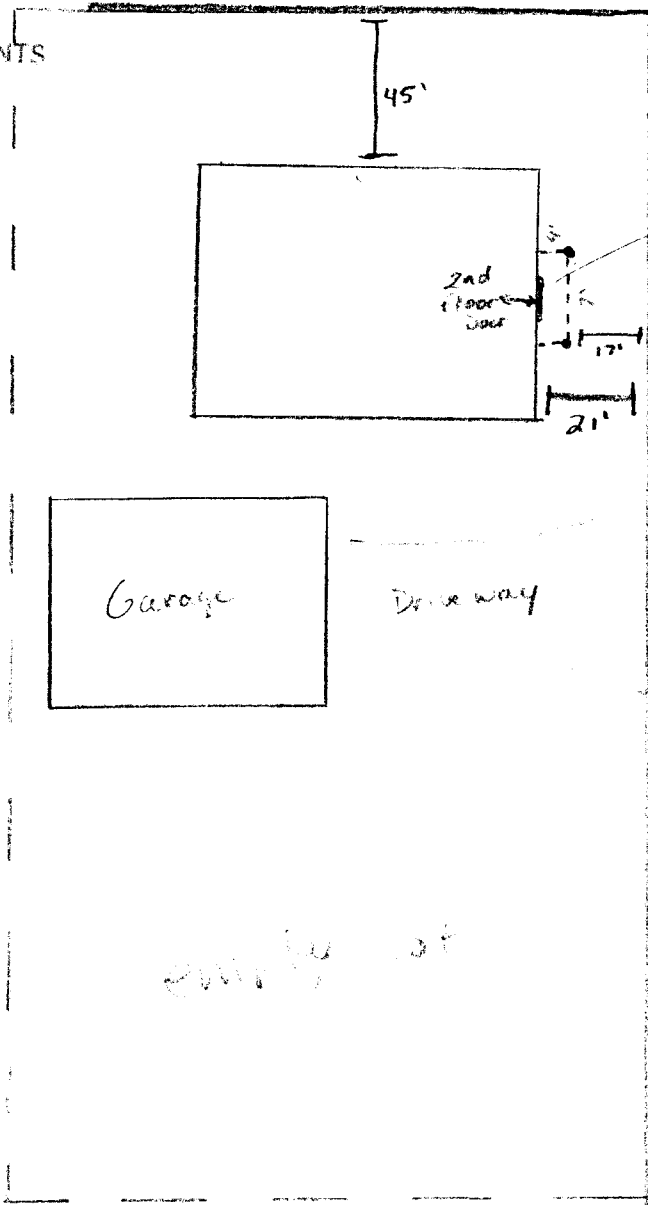

\*supports must meet 20ft setback

empty lot