

FEE \$ 10.00
 TCP \$ 1500.00
 SIF \$ 292.00

PLANNING CLEARANCE (B)
 (Single Family Residential and Accessory Structures)
Community Development Department

BLDG PERMIT NO. _____

Building Address 1701 Christopher Way
 Parcel No. 2943-243-28-002 (parent)
 Subdivision River Glen
 Filing 1 Block 3 Lot 6

No. of Existing Bldgs 0 No. Proposed 1
 Sq. Ft. of Existing Bldgs _____ Sq. Ft. Proposed _____
 Sq. Ft. of Lot / Parcel 5254 SF
 Sq. Ft. Coverage of Lot by Structures & Impervious Surface (Total Existing & Proposed) _____
 Height of Proposed Structure _____

OWNER INFORMATION:

Name Grace Homes
 Address 786 Valley Ct.
 City / State / Zip W.G. Co. 81505

DESCRIPTION OF WORK & INTENDED USE:

New Single Family Home (*check type below)
 Interior Remodel Addition
 Other (please specify): _____

APPLICANT INFORMATION:

Name " "
 Address _____
 City / State / Zip _____
 Telephone _____

***TYPE OF HOME PROPOSED:**

Site Built Manufactured Home (UBC)
 Manufactured Home (HUD)
 Other (please specify): _____

NOTES: _____

REQUIRED: One plot plan, on 8 1/2" x 11" paper, showing all existing & proposed structure location(s), parking, setbacks to all property lines, ingress/egress to the property, driveway location & width & all easements & rights-of-way which abut the parcel.

THIS SECTION TO BE COMPLETED BY COMMUNITY DEVELOPMENT DEPARTMENT STAFF			
ZONE <u>RMF-8</u>	Maximum coverage of lot by structures <u>70%</u>		
SETBACKS: Front <u>20'</u> from property line (PL)	Permanent Foundation Required: YES <input checked="" type="checkbox"/> NO <input type="checkbox"/>		
Side <u>5'</u> from PL Rear <u>10'</u> from PL	Parking Requirement <u>2</u>		
Maximum Height of Structure(s) <u>35'</u>	Special Conditions <u>Engineered Foundation Required</u>		
Voting District <u>E</u>	Driveway Location Approval <u>W</u> (Engineer's Initials)		


Modifications to this Planning Clearance must be approved, in writing, by the Community Development Department. The structure authorized by this application cannot be occupied until a final inspection has been completed and a Certificate of Occupancy has been issued, if applicable, by the Building Department (Section 305, Uniform Building Code).

I hereby acknowledge that I have read this application and the information is correct; I agree to comply with any and all codes, ordinances, laws, regulations or restrictions which apply to the project. I understand that failure to comply shall result in legal action, which may include but not necessarily be limited to non-use of the building(s).

Applicant Signature Monica Duto Agent Date 8/16/05
 Department Approval M. Usher Mayor Date 8/25/05


Additional water and/or sewer tap fee(s) are required: YES NO W/O No. 18257
 Utility Accounting XS Date 8-25-05

VALID FOR SIX MONTHS FROM DATE OF ISSUANCE (Section 2.2.C.1 Grand Junction Zoning & Development Code)
 (White: Planning) (Yellow: Customer) (Pink: Building Department) (Goldenrod: Utility Accounting)

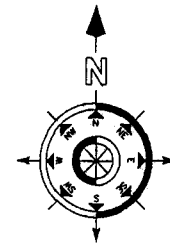

Jason Wells

*drive
done
8/17/05*

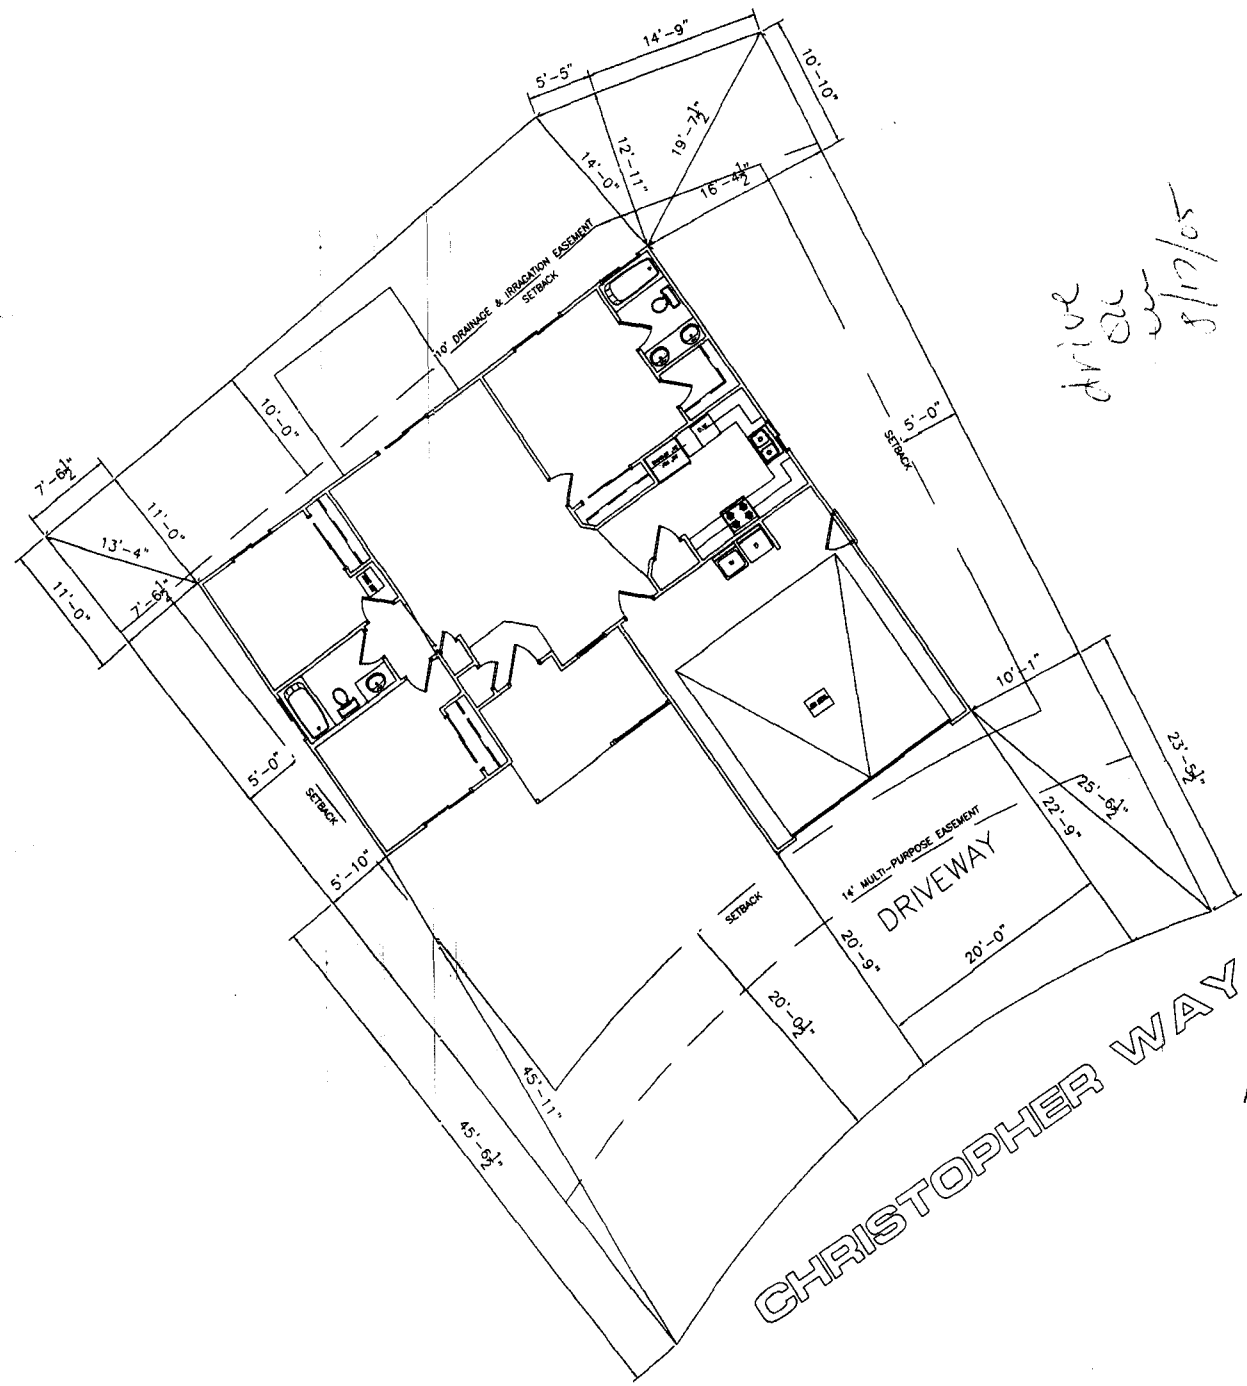

NOTE:
GRADE MUST SLOPE AWAY FROM HOUSE 6" OF FALL IN THE FIRST 10' OF DISTANCE PER LOCAL BUILDING CODE.

NOTE:
DIMENSION LINES ARE PULLED FROM EDGE OF BRICK LEDGE. IF NO BRICK LEDGE EXISTS, DIMENSIONS WILL BE FROM EDGE OF FOUNDATION.

NOTE:
BUILDER TO VERIFY ALL SETBACK AND EASEMENT ENCROACHMENTS PRIOR TO CONSTRUCTION

SITE PLAN INFORMATION	
SUBDIVISION NAME	RIVERGLEN
FILING NUMBER	1
LOT NUMBER	6
BLOCK NUMBER	3
STREET ADDRESS	1701 CHRISTOPHER WAY
COUNTY	MESA
GARAGE SQ. FT.	450 SF
LIVING SQ. FT.	1139 SF
LOT SIZE	5254 SF
SETBACKS USED	FRONT 20' SIDES 5' REAR 10'

SCALE: 1/16" = 1'-0"

ACCEPTED *N. Aragon* 8/25/05
ANY CHANGE OF SETBACKS MUST BE APPROVED BY THE CITY PLANNING DEPT. IT IS THE APPLICANT'S RESPONSIBILITY TO PROPERLY LOCATE AND IDENTIFY EASEMENTS AND PROPERTY LINES.