

BLDG PERMIT NO.

FEE \$ 10.00
TCP \$ ~~100~~
SIF \$ 292.00

PLANNING CLEARANCE
(Single Family Residential and Accessory Structures)
Community Development Department

1500.00
2943-311-34-010

Building Address 178 Country Ridge
Parcel No. ~~2943 311-00-029~~
Subdivision Country Ridge
Filing 1 Block 1 Lot 5

No. of Existing Bldgs _____ No. Proposed 1
Sq. Ft. of Existing Bldgs _____ Sq. Ft. Proposed 2484
Sq. Ft. of Lot / Parcel 8000
Sq. Ft. Coverage of Lot by Structures & Impervious Surface (Total Existing & Proposed) _____
Height of Proposed Structure _____

OWNER INFORMATION:

Name Sonshine II Construction
Address 2350 G Road
City / State / Zip Grand Jct, CO 81505

DESCRIPTION OF WORK & INTENDED USE:

New Single Family Home (*check type below)
 Interior Remodel Addition
 Other (please specify): _____

APPLICANT INFORMATION:

Name Sonshine II Construction
Address 2350 G Road
City / State / Zip Grand Jct, CO 81505
Telephone 970-255-8853

***TYPE OF HOME PROPOSED:**

Site Built Manufactured Home (UBC)
 Manufactured Home (HUD)
 Other (please specify): _____

NOTES: _____

REQUIRED: One plot plan, on 8 1/2" x 11" paper, showing all existing & proposed structure location(s), parking, setbacks to all property lines, ingress/egress to the property, driveway location & width & all easements & rights-of-way which abut the parcel.

THIS SECTION TO BE COMPLETED BY COMMUNITY DEVELOPMENT DEPARTMENT STAFF	
ZONE <u>RSF-4</u>	Maximum coverage of lot by structures <u>50%</u>
SETBACKS: Front <u>20'</u> from property line (PL)	Permanent Foundation Required: YES <u>X</u> NO _____
Side <u>7'</u> from PL Rear <u>25'</u> from PL	Parking Requirement <u>2</u>
Maximum Height of Structure(s) <u>35'</u>	Special Conditions _____
Voting District <u>"E"</u>	Driveway Location Approval <u>lll</u> (Engineer's Initials)

Modifications to this Planning Clearance must be approved, in writing, by the Community Development Department. The structure authorized by this application cannot be occupied until a final inspection has been completed and a Certificate of Occupancy has been issued, if applicable, by the Building Department (Section 305, Uniform Building Code).

I hereby acknowledge that I have read this application and the information is correct; I agree to comply with any and all codes, ordinances, laws, regulations or restrictions which apply to the project. I understand that failure to comply shall result in legal action, which may include but not necessarily be limited to non-use of the building(s).


Applicant Signature Maria Rhodes Date 7/29/05

Department Approval NA Gaylen Henderson Date 12-20-05

Additional water and/or sewer tap fee(s) are required: YES <input checked="" type="radio"/> NO <input type="radio"/>	W/O No. <u>PL OMBD</u>
Utility Accounting <u>lll</u>	Date <u>12/20/05</u>

VALID FOR SIX MONTHS FROM DATE OF ISSUANCE (Section 2.2.C.1 Grand Junction Zoning & Development Code)
(White: Planning) (Yellow: Customer) (Pink: Building Department) (Goldenrod: Utility Accounting)

COUNTRY RIDGE ROAD

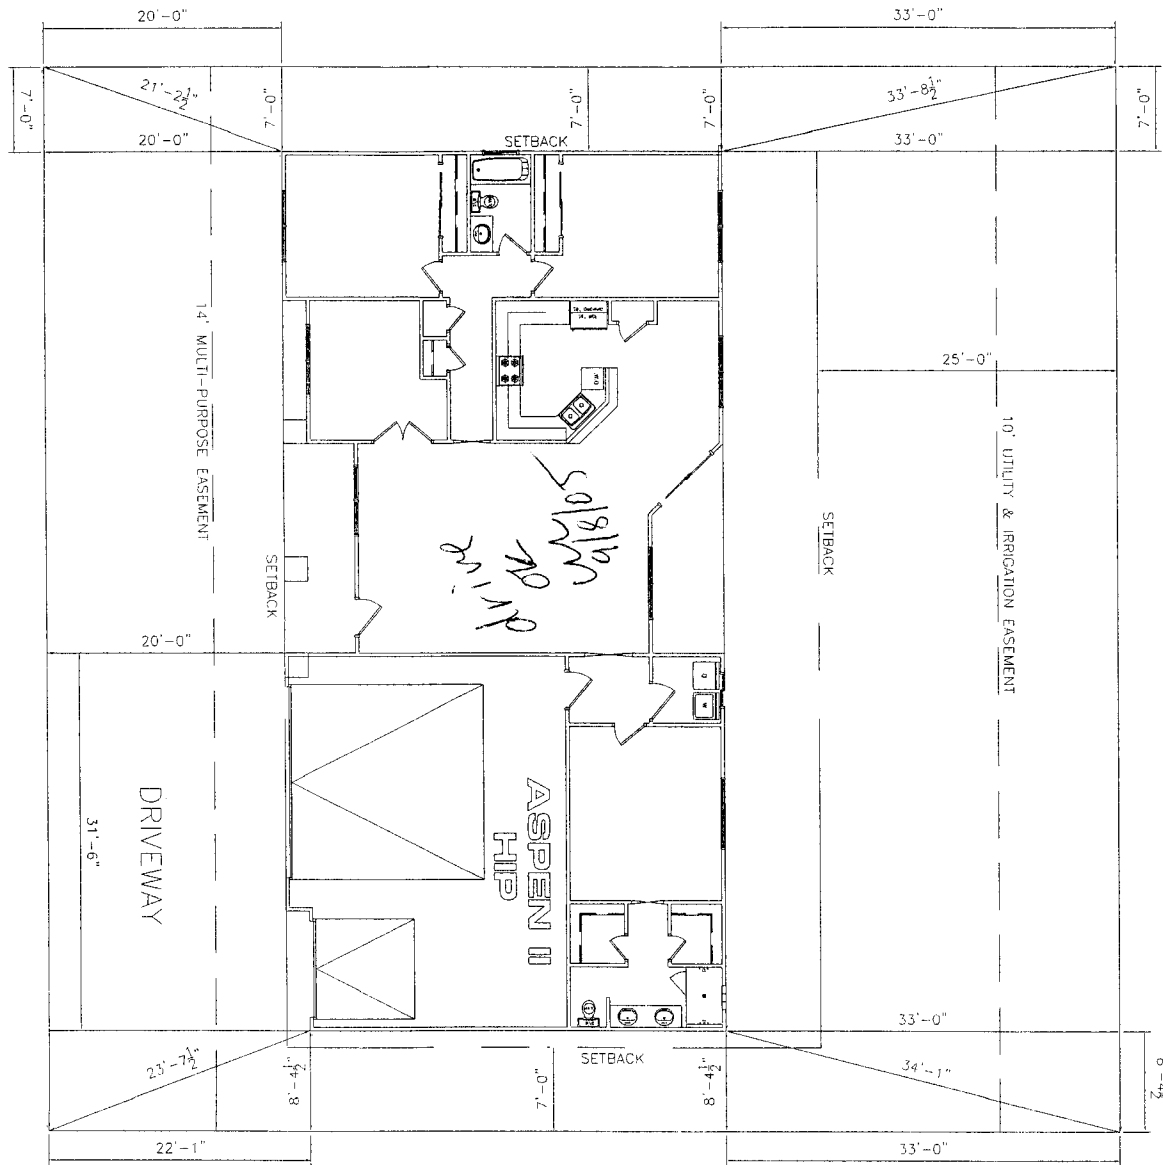


SCALE: 1/16" = 1'-0"

178 Country Ridge

NOTE:
GRADE MUST SLOPE AWAY FROM HOUSE 6" OF FALL IN THE FIRST 10' OF DISTANCE PER LOCAL BUILDING CODE.

NOTE:
DIMENSION LINES ARE PULLED FROM EDGE OF BRICK LEDGE. IF NO BRICK LEDGE EXISTS, DIMENSIONS WILL BE FROM EDGE OF FOUNDATION

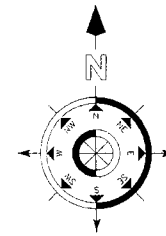


SITE PLAN INFORMATION	
SUBDIVISION NAME	COUNTRY RIDGE ESTATES
FILING NUMBER	1
LOT NUMBER	5
BLOCK NUMBER	1
STREET ADDRESS	178 COUNTRY RIDGE RD.
COUNTY	MESA
GARAGE SQ. FT.	722 SF
LIVING SQ. FT.	1762 SF
LOT SIZE	8000 SF
SETBACKS USED	FRONT 20'
	SIDES 7'
	REAR 25'

NOTE:
BUILDER TO VERIFY ALL SETBACK AND EASEMENT ENCROACHMENTS PRIOR TO CONSTRUCTION


NA
ACCEPTED *Gayleen Henderson*
ANY CHANGE OF SETBACKS MUST BE APPROVED BY THE CITY PLANNING DEPT. BEFORE ANY CONSTRUCTION RESUMES. VERIFY ALL SETBACKS, EASEMENTS AND PROPERTY LINES.

COUNTRY RIDGE ROAD

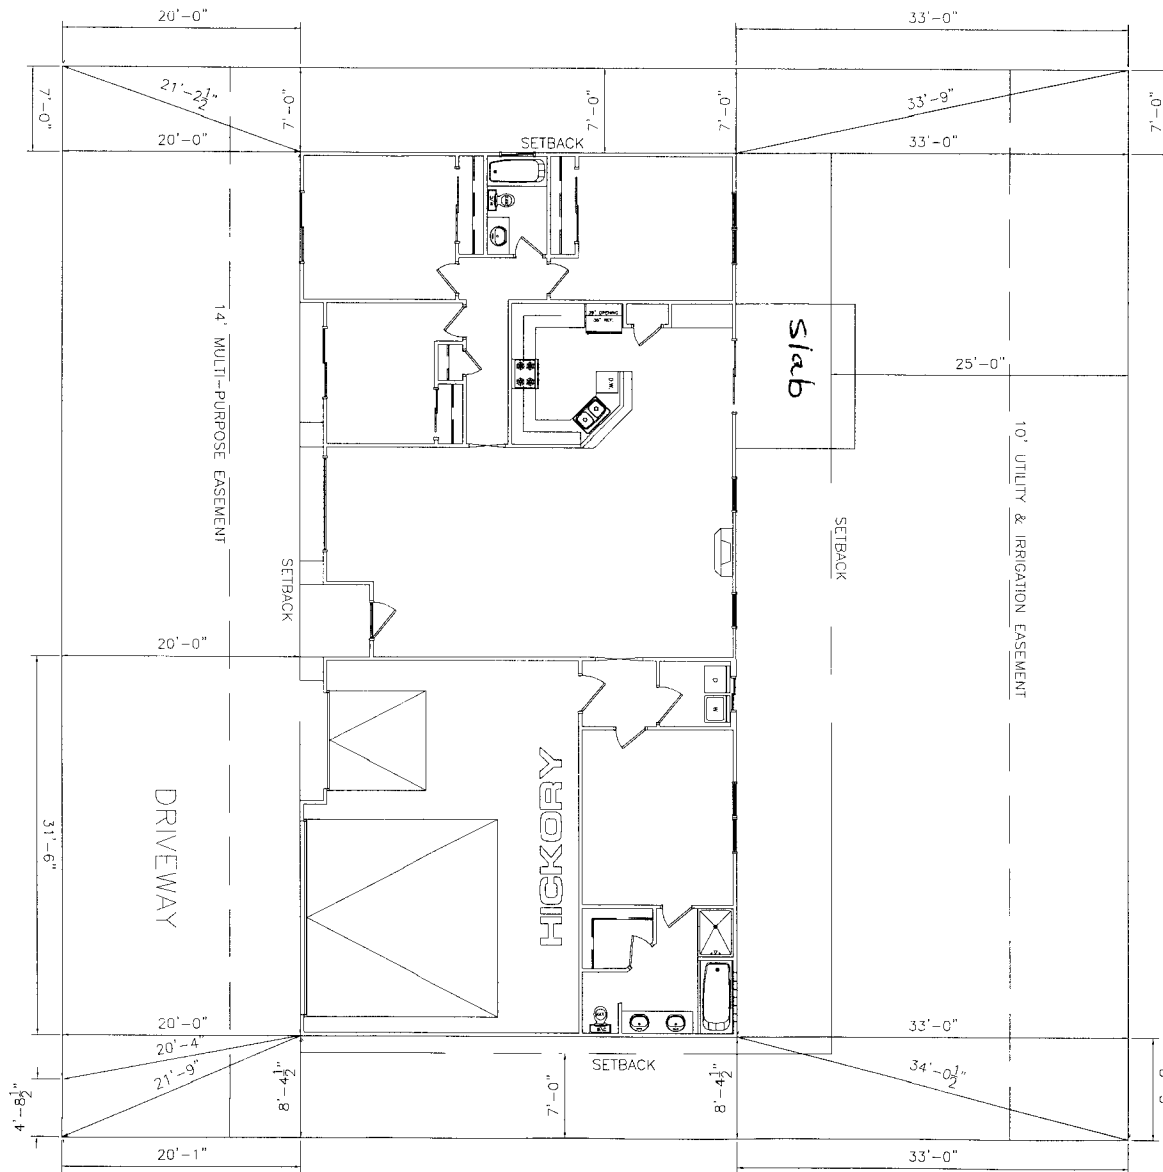

NOTE:
GRADE MUST SLOPE AWAY FROM HOUSE 6" OF FALL IN THE FIRST 10' OF DISTANCE PER LOCAL BUILDING CODE.

NOTE:
DIMENSION LINES ARE PULLED FROM EDGE OF BRICK LEDGE. IF NO BRICK LEDGE EXISTS, DIMENSIONS WILL BE FROM EDGE OF FOUNDATION.

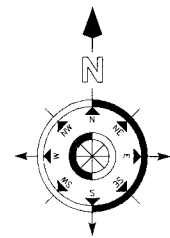

SITE PLAN INFORMATION	
SUBDIVISION NAME	COUNTRY RIDGE ESTATES
FILING NUMBER	1
LOT NUMBER	5
BLOCK NUMBER	1
STREET ADDRESS	178 COUNTRY RIDGE RD.
COUNTY	MESA
GARAGE SQ. FT.	718 SF
LIVING SQ. FT.	1895 SF
LOT SIZE	8000 SF
SETBACKS USED	FRONT 20'
	SIDES 7'
	REAR 25'

NOTE:
BUILDER TO VERIFY ALL SETBACK AND EASEMENT ENCROACHMENTS PRIOR TO CONSTRUCTION

3-7-06
ACCEPTED *Gayleen Henderson*
ANY CHANGE OF SETBACKS MUST BE APPROVED BY THE CITY PLANNING DEPT. IT IS THE APPLICANT'S RESPONSIBILITY TO PROPERLY LOCATE AND VERIFY EASEMENTS AND PROPERTY LINES.

SCALE: 1/16" = 1'-0"