

FEE \$ <u>70.00</u>
TCP \$ <u>None</u>
SIF \$ <u>292.00</u>

PLANNING CLEARANCE

BLDG PERMIT NO. _____

(Single Family Residential and Accessory Structures)

Community Development Department

2943-311-33-006

Building Address 180 Country Ridge No. of Existing Bldgs _____ No. Proposed 1
 Parcel No. 2943 311-00-029 Sq. Ft. of Existing Bldgs _____ Sq. Ft. Proposed 2626
 Subdivision Country Ridge Sq. Ft. of Lot / Parcel 8000
 Filing 1 Block 1 Lot 6 Sq. Ft. Coverage of Lot by Structures & Impervious Surface (Total Existing & Proposed) _____
 Height of Proposed Structure _____

OWNER INFORMATION:

Name Sonshine II Construction
 Address 2350 G Road
 City / State / Zip Grand Jct, CO 81505

DESCRIPTION OF WORK & INTENDED USE:

New Single Family Home (*check type below)
 Interior Remodel Addition
 Other (please specify): _____

APPLICANT INFORMATION:

Name Sonshine II Construction
 Address 2350 G Road
 City / State / Zip Grand Jct, CO 81505
 Telephone 970-255-8853

*TYPE OF HOME PROPOSED:

Site Built Manufactured Home (UBC)
 Manufactured Home (HUD)
 Other (please specify): _____

NOTES: _____

REQUIRED: One plot plan, on 8 1/2" x 11" paper, showing all existing & proposed structure location(s), parking, setbacks to all property lines, ingress/egress to the property, driveway location & width & all easements & rights-of-way which abut the parcel.

THIS SECTION TO BE COMPLETED BY COMMUNITY DEVELOPMENT DEPARTMENT STAFF

ZONE RSF-4 Maximum coverage of lot by structures 50%
 SETBACKS: Front 20' from property line (PL) Permanent Foundation Required: YES X NO _____
 Side 7' from PL Rear 25' from PL Parking Requirement 2
 Maximum Height of Structure(s) 35' Special Conditions _____
 Voting District "E" Driveway Location Approval [Signature]
 (Engineer's Initials)


Modifications to this Planning Clearance must be approved, in writing, by the Community Development Department. The structure authorized by this application cannot be occupied until a final inspection has been completed and a Certificate of Occupancy has been issued, if applicable, by the Building Department (Section 305, Uniform Building Code).

I hereby acknowledge that I have read this application and the information is correct; I agree to comply with any and all codes, ordinances, laws, regulations or restrictions which apply to the project. I understand that failure to comply shall result in legal action, which may include but not necessarily be limited to non-use of the building(s).

Applicant Signature Maria Rhodes Date 7/29/05
 Department Approval NA Dayleen Henderson Date 12-20-05


Additional water and/or sewer tap fee(s) are required: YES <input checked="" type="radio"/> NO <input type="radio"/>	W/O No. <u>PL0M20</u>
Utility Accounting <u>[Signature]</u>	Date <u>12/20/05</u>

VALID FOR SIX MONTHS FROM DATE OF ISSUANCE (Section 2.2.C.1 Grand Junction Zoning & Development Code)
 (White: Planning) (Yellow: Customer) (Pink: Building Department) (Goldenrod: Utility Accounting)

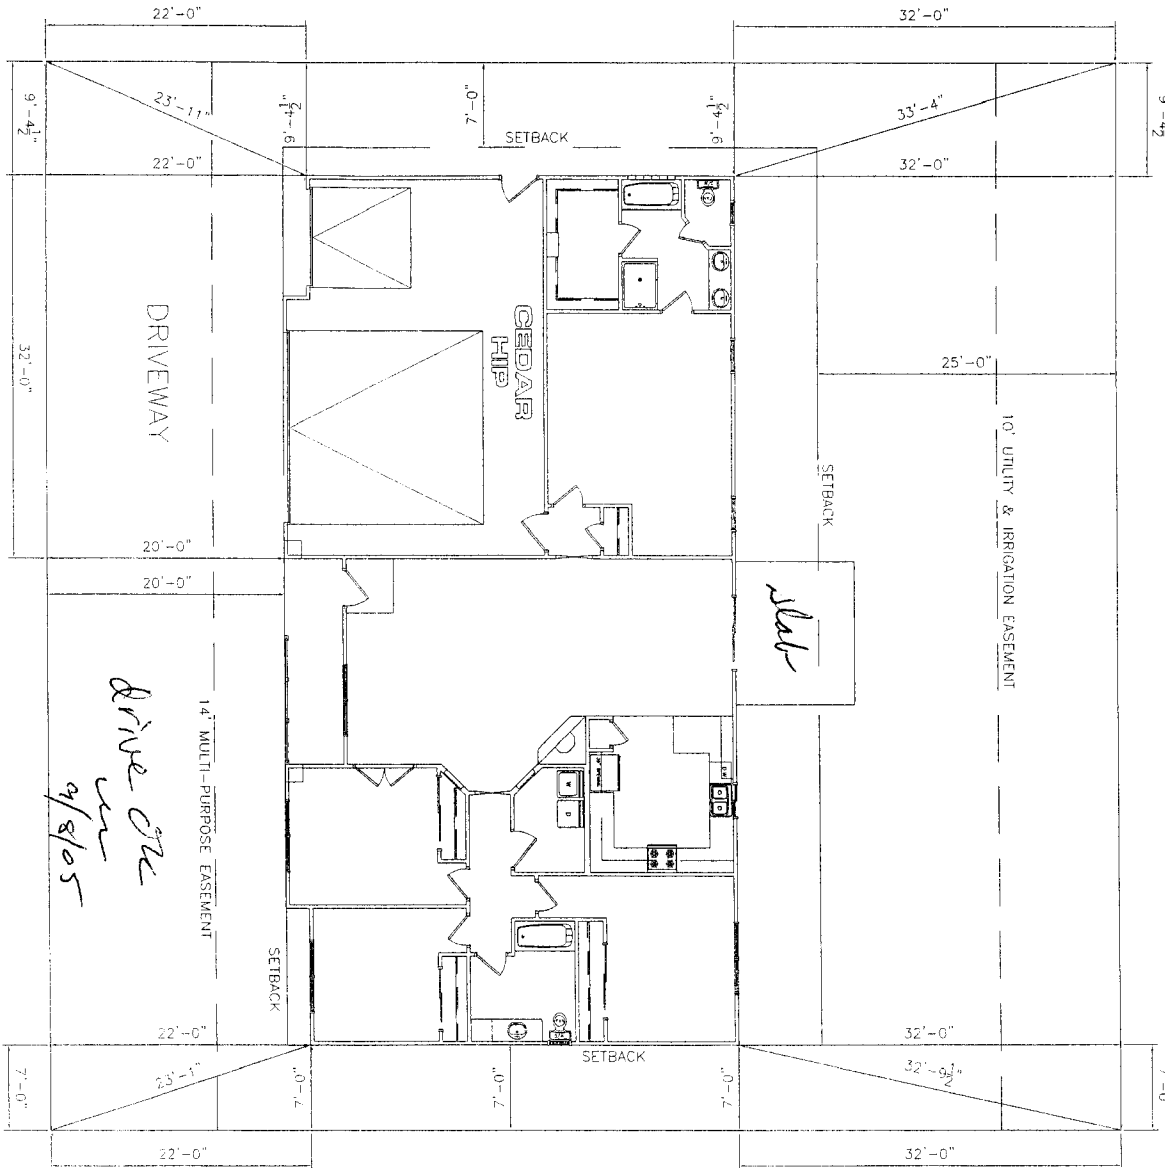

NOTE:
GRADE MUST SLOPE AWAY FROM HOUSE 6" OF FALL IN THE FIRST 10' OF DISTANCE PER LOCAL BUILDING CODE.

NOTE:
DIMENSION LINES ARE PULLED FROM EDGE OF BRICK LEDGE. IF NO BRICK LEDGE EXISTS, DIMENSIONS WILL BE FROM EDGE OF FOUNDATION.

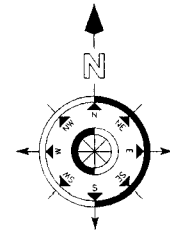

SITE PLAN INFORMATION	
SUBDIVISION NAME	COUNTRY RIDGE ESTATES
FILING NUMBER	1
LOT NUMBER	6
BLOCK NUMBER	1
STREET ADDRESS	180 COUNTRY RIDGE RD.
COUNTY	MESA
LIVING SQ. FT.	1947 SF
GARAGE SQ. FT.	679 SF
LOT SIZE	8000 SF
SETBACKS USED	FRONT 20' SIDES 7' REAR 25'

NOTE:
BUILDER TO VERIFY ALL SETBACK AND EASEMENT ENCROACHMENTS PRIOR TO CONSTRUCTION

SCALE: 1/16" = 1'-0"

COUNTRY RIDGE RO ACCEPTED

*drive on
9/8/05*

slab

NR
ANY CHANGE OF SETBACKS MUST BE APPROVED BY THE PLANNING DEPT.
RESPONSE TO COMMENTS MUST BE SUBMITTED TO THE PLANNING DEPT.
LOCATE ALL EASEMENTS AND PROPERTY LINES.

180 Country Ridge