

FEE \$ 10.00
 TCP \$ None
 SIF \$ 292.00

PLANNING CLEARANCE

BLDG PERMIT NO. _____

(Single Family Residential and Accessory Structures)
Community Development Department

2943-311-34-007

Building Address 181 Country Ridge No. of Existing Bldgs _____ No. Proposed 1
 Parcel No. 2943-311-00-029 Sq. Ft. of Existing Bldgs _____ Sq. Ft. Proposed 2217
 Subdivision Country Ridge Sq. Ft. of Lot / Parcel 8001
 Filing 1 Block 2 Lot 7 Sq. Ft. Coverage of Lot by Structures & Impervious Surface (Total Existing & Proposed) _____
 Height of Proposed Structure _____

OWNER INFORMATION:

Name Sunshine II Construction
 Address 2350 G Road
 City / State / Zip Grand Jet, CO 81505

DESCRIPTION OF WORK & INTENDED USE:

New Single Family Home (*check type below)
 Interior Remodel Addition
 Other (please specify): _____

APPLICANT INFORMATION:

Name Sunshine II Construction
 Address 2350 G Road
 City / State / Zip Grand Jet, CO 81505
 Telephone 970-255-8853

***TYPE OF HOME PROPOSED:**

Site Built Manufactured Home (UBC)
 Manufactured Home (HUD)
 Other (please specify): _____

NOTES: _____

REQUIRED: One plot plan, on 8 1/2" x 11" paper, showing all existing & proposed structure location(s), parking, setbacks to all property lines, ingress/egress to the property, driveway location & width & all easements & rights-of-way which abut the parcel.

THIS SECTION TO BE COMPLETED BY COMMUNITY DEVELOPMENT DEPARTMENT STAFF	
ZONE <u>RSF-4</u>	Maximum coverage of lot by structures <u>50%</u>
SETBACKS: Front <u>20'</u> from property line (PL)	Permanent Foundation Required: YES <u>X</u> NO _____
Side <u>7'</u> from PL Rear <u>25'</u> from PL	Parking Requirement <u>2</u>
Maximum Height of Structure(s) <u>35'</u>	Special Conditions _____
Voting District _____	Driveway Location Approval <u>[Signature]</u> (Engineer's Initials)

Modifications to this Planning Clearance must be approved, in writing, by the Community Development Department. The structure authorized by this application cannot be occupied until a final inspection has been completed and a Certificate of Occupancy has been issued, if applicable, by the Building Department (Section 305, Uniform Building Code).

I hereby acknowledge that I have read this application and the information is correct; I agree to comply with any and all codes, ordinances, laws, regulations or restrictions which apply to the project. I understand that failure to comply shall result in legal action, which may include but not necessarily be limited to non-use of the building(s).

Applicant Signature Maria Rhodes Date 7/29/05
 Department Approval [Signature] Date 12-2-05

Additional water and/or sewer tap fee(s) are required:	YES <input checked="" type="checkbox"/>	NO <input type="checkbox"/>	W/O No. <u>01MRD 4812</u>
Utility Accounting <u>[Signature]</u>	Date <u>12/2/05</u>		

VALID FOR SIX MONTHS FROM DATE OF ISSUANCE (Section 2.2.C.1 Grand Junction Zoning & Development Code)
 (White: Planning) (Yellow: Customer) (Pink: Building Department) (Goldenrod: Utility Accounting)


N/A

12-2-05 Gayle Henderson

ACCEPTED
ANY CHANGE OF SETBACKS MUST BE APPROVED BY THE CITY PLANNING DEPARTMENT. THE SETBACKS MUST BE PROPERLY LOCATED AND IDENTIFY EASEMENTS AND PROPERTY LINES.


NOTE:
GRADE MUST SLOPE AWAY FROM HOUSE 6" OF FALL IN THE FIRST 10' OF DISTANCE PER LOCAL BUILDING CODE.

NOTE:
DIMENSION LINES ARE PULLED FROM EDGE OF BRICK LEDGE. IF NO BRICK LEDGE EXISTS, DIMENSIONS WILL BE FROM EDGE OF FOUNDATION.

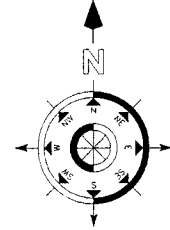

SITE PLAN INFORMATION	
SUBDIVISION NAME	COUNTRY RIDGE ESTATES
FILING NUMBER	1
LOT NUMBER	7
BLOCK NUMBER	2
STREET ADDRESS	181 COUNTRY RIDGE RD.
COUNTY	MESA
GARAGE SQ. FT.	653 SF
LIVING SQ. FT.	1564 SF
LOT SIZE	8001 SF
SETBACKS USED	FRONT 20' SIDES 7' REAR 25'

NOTE:
BUILDER TO VERIFY ALL SETBACK AND EASEMENT ENCROACHMENTS PRIOR TO CONSTRUCTION

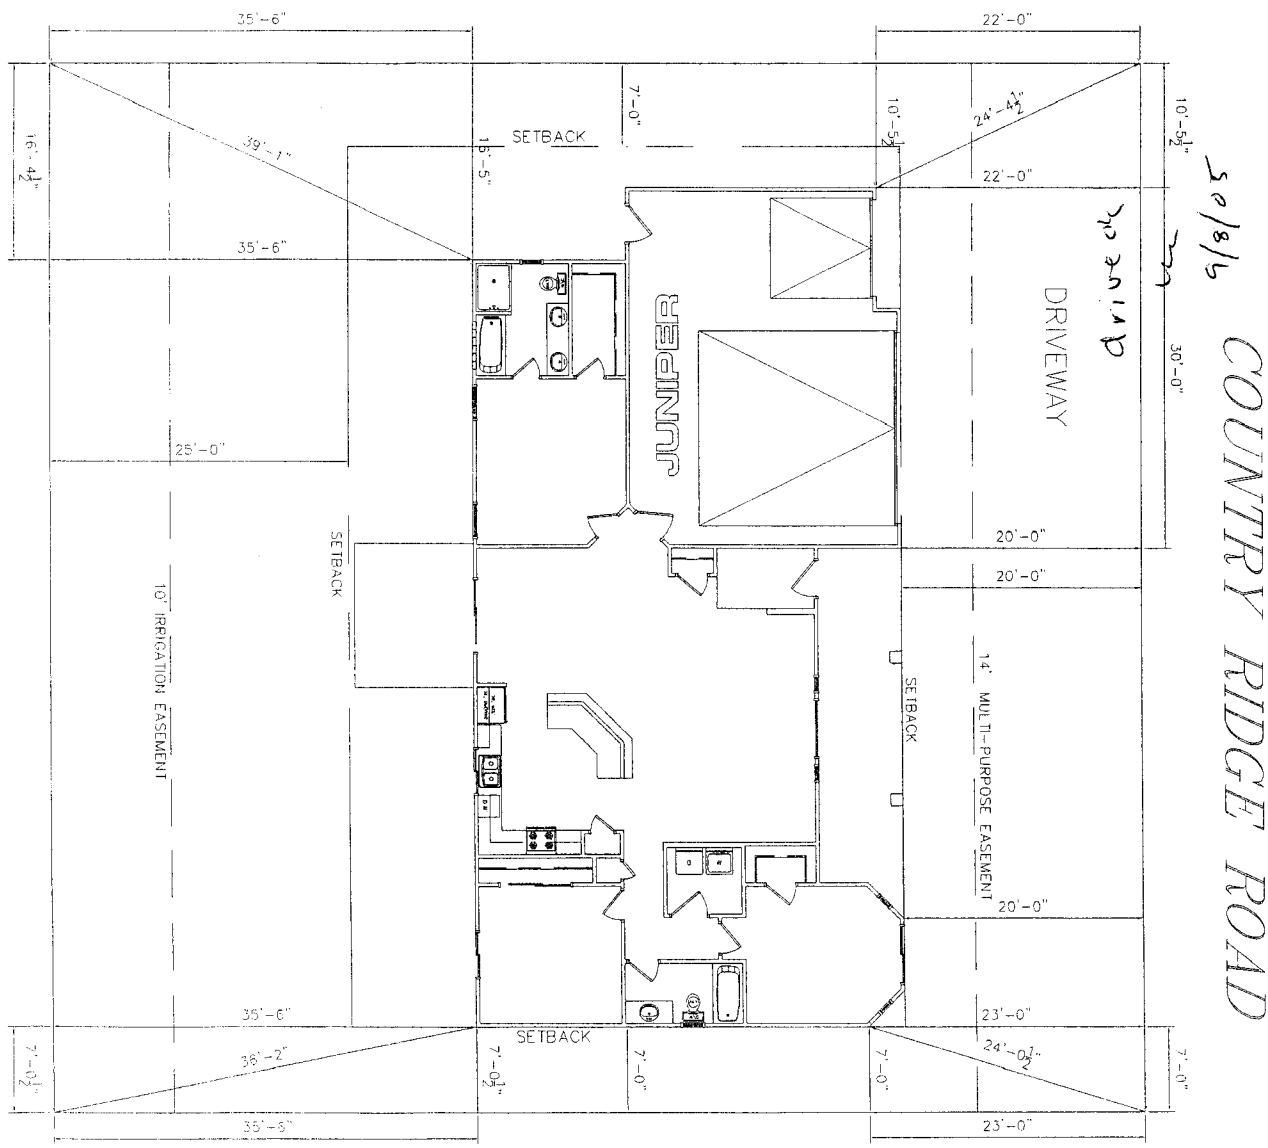

SCALE: 1/16" = 1'-0"

181 Country Ridge