

FEE \$	10.00
TCP \$	<del>1500.00</del>
SIF \$	292.00

**PLANNING CLEARANCE**  
 1500.00  
 (Single Family Residential and Accessory Structures)  
**Community Development Department**

BLDG PERMIT NO. \_\_\_\_\_

2943-311-33-009

Building Address 186 Country Ridge  
 Parcel No. ~~2943-311-00-089~~  
 Subdivision Country Ridge  
 Filing 1 Block 1 Lot 9

No. of Existing Bldgs \_\_\_\_\_ No. Proposed 1  
 Sq. Ft. of Existing Bldgs \_\_\_\_\_ Sq. Ft. Proposed 2626  
 Sq. Ft. of Lot / Parcel 8000  
 Sq. Ft. Coverage of Lot by Structures & Impervious Surface (Total Existing & Proposed) \_\_\_\_\_  
 Height of Proposed Structure \_\_\_\_\_

**OWNER INFORMATION:**

Name Sonshine II Construction  
 Address 2350 G Road  
 City / State / Zip Grand Jct, CO 81505

DESCRIPTION OF WORK & INTENDED USE:  
 New Single Family Home (\*check type below)  
 Interior Remodel  Addition  
 Other (please specify): \_\_\_\_\_

**APPLICANT INFORMATION:**

Name Sonshine II Construction  
 Address 2350 G Road  
 City / State / Zip Grand Jct, CO 81505  
 Telephone 970-255-8853

\*TYPE OF HOME PROPOSED:  
 Site Built  Manufactured Home (UBC)  
 Manufactured Home (HUD)  
 Other (please specify): \_\_\_\_\_

NOTES: \_\_\_\_\_

**REQUIRED: One plot plan, on 8 1/2" x 11" paper, showing all existing & proposed structure location(s), parking, setbacks to all property lines, ingress/egress to the property, driveway location & width & all easements & rights-of-way which abut the parcel.**

<b>THIS SECTION TO BE COMPLETED BY COMMUNITY DEVELOPMENT DEPARTMENT STAFF</b>	
ZONE <u>RSF-4</u>	Maximum coverage of lot by structures <u>50%</u>
SETBACKS: Front <u>20'</u> from property line (PL)	Permanent Foundation Required: YES <input checked="" type="checkbox"/> NO _____
Side <u>7'</u> from PL Rear <u>25'</u> from PL	Parking Requirement <u>2</u>
Maximum Height of Structure(s) <u>35'</u>	Special Conditions _____
Voting District _____	Driveway Location Approval <u>WR</u> (Engineer's Initials)

Modifications to this Planning Clearance must be approved, in writing, by the Community Development Department. The structure authorized by this application cannot be occupied until a final inspection has been completed and a Certificate of Occupancy has been issued, if applicable, by the Building Department (Section 305, Uniform Building Code).


I hereby acknowledge that I have read this application and the information is correct; I agree to comply with any and all codes, ordinances, laws, regulations or restrictions which apply to the project. I understand that failure to comply shall result in legal action, which may include but not necessarily be limited to non-use of the building(s).

Applicant Signature Maria Rhodes Date 7/29/05  
 Department Approval NA Gayle Henderson Date 12-2-05

Additional water and/or sewer tap fee(s) are required:	YES <input checked="" type="checkbox"/>	NO <input type="checkbox"/>	W/O No. <u>4817</u>
Utility Accounting <u>JME</u>	Date <u>12/2/05</u>		


VALID FOR SIX MONTHS FROM DATE OF ISSUANCE (Section 2.2.C.1 Grand Junction Zoning & Development Code)  
 (White: Planning) (Yellow: Customer) (Pink: Building Department) (Goldenrod: Utility Accounting)

COUNTRY RIDGE ROAD

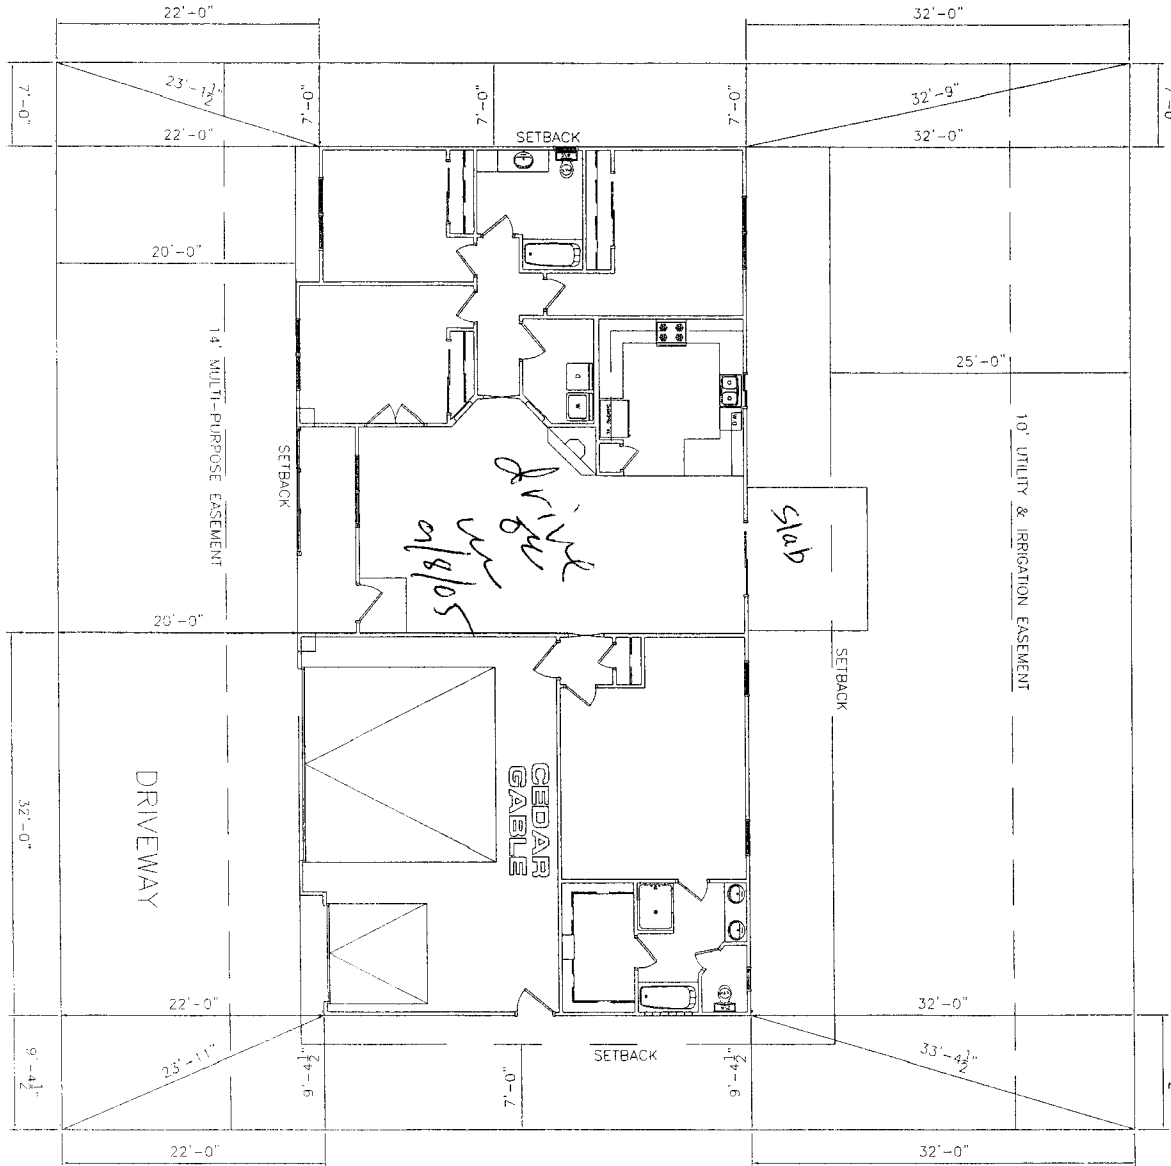

NOTE:  
GRADE MUST SLOPE AWAY FROM HOUSE 6" OF FALL IN THE FIRST 10' OF DISTANCE PER LOCAL BUILDING CODE.

NOTE:  
DIMENSION LINES ARE PULLED FROM EDGE OF BRICK LEDGE. IF NO BRICK LEDGE EXISTS, DIMENSIONS WILL BE FROM EDGE OF FOUNDATION.

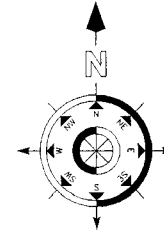

SITE PLAN INFORMATION	
SUBDIVISION NAME	COUNTRY RIDGE ESTATES
FILING NUMBER	1
LOT NUMBER	9
BLOCK NUMBER	1
STREET ADDRESS	186 COUNTRY RIDGE RD.
COUNTY	MESA
GARAGE SQ. FT.	679 SF
LIVING SQ. FT.	1947 SF
LOT SIZE	8000 SF
SETBACKS USED	FRONT 20'
	SIDES 7' REAR 25'

NOTE:  
BUILDER TO VERIFY ALL SETBACK AND EASEMENT ENCROACHMENTS PRIOR TO CONSTRUCTION

SCALE: 1/16" = 1'-0"

186 Country Ridge

NA 122-05 *Gayleen Henderson*  
ACCEPTED  
ANY CHANGES TO THIS PLAN MUST BE APPROVED BY THE CITY PLANNING DEPARTMENT. THE CITY HAS RESPONSIBILITY TO VERIFY ALL EASEMENTS AND PROPERTY LINES.