

FEE \$ <u>10.00</u>
TCP \$ <u>1500.00</u>
SIF \$ <u>292.00</u>

**PLANNING CLEARANCE**  
 (Single Family Residential and Accessory Structures)  
Community Development Department

BLDG PERMIT NO. \_\_\_\_\_

Building Address 189 Country Ridge  
 Parcel No. 2943-311-00-029  
 Subdivision Country Ridge  
 Filing 1 Block 2 Lot 3

No. of Existing Bldgs \_\_\_\_\_ No. Proposed 1  
 Sq. Ft. of Existing Bldgs \_\_\_\_\_ Sq. Ft. Proposed 2607  
 Sq. Ft. of Lot / Parcel 8001  
 Sq. Ft. Coverage of Lot by Structures & Impervious Surface  
 (Total Existing & Proposed) \_\_\_\_\_  
 Height of Proposed Structure \_\_\_\_\_

**OWNER INFORMATION:**

Name Sonshine II Construction  
 Address 2350 G Road  
 City / State / Zip Grand Jet, CO 81505

**DESCRIPTION OF WORK & INTENDED USE:**

New Single Family Home (\*check type below)  
 Interior Remodel  Addition  
 Other (please specify): \_\_\_\_\_

**APPLICANT INFORMATION:**

Name Sonshine II Construction  
 Address 2350 G Road  
 City / State / Zip Grand Jet, CO 81505  
 Telephone 970-255-8853

**\*TYPE OF HOME PROPOSED:**

Site Built  Manufactured Home (UBC)  
 Manufactured Home (HUD)  
 Other (please specify): \_\_\_\_\_

NOTES: \_\_\_\_\_

**REQUIRED: One plot plan, on 8 1/2" x 11" paper, showing all existing & proposed structure location(s), parking, setbacks to all property lines, ingress/egress to the property, driveway location & width & all easements & rights-of-way which abut the parcel.**

THIS SECTION TO BE COMPLETED BY COMMUNITY DEVELOPMENT DEPARTMENT STAFF	
ZONE <u>R8F-4</u>	Maximum coverage of lot by structures <u>50%</u>
SETBACKS: Front <u>20'</u> from property line (PL)	Permanent Foundation Required: YES <u>X</u> NO _____
Side <u>7'</u> from PL Rear <u>25'</u> from PL	Parking Requirement <u>2</u>
Maximum Height of Structure(s) <u>35'</u>	Special Conditions _____
Voting District _____	Driveway Location Approval _____ (Engineer's Initials)

Modifications to this Planning Clearance must be approved, in writing, by the Community Development Department. The structure authorized by this application cannot be occupied until a final inspection has been completed and a Certificate of Occupancy has been issued, if applicable, by the Building Department (Section 305, Uniform Building Code).

I hereby acknowledge that I have read this application and the information is correct; I agree to comply with any and all codes, ordinances, laws, regulations or restrictions which apply to the project. I understand that failure to comply shall result in legal action, which may include but not necessarily be limited to non-use of the building(s).

Applicant Signature Maria Rhodes Date 7/29/05  
 Department Approval NA Gayle Henderson Date 11-3-05


Additional water and/or sewer tap fee(s) are required: YES <input checked="" type="checkbox"/> NO <input type="checkbox"/>	W/O No. <u>OWSD #4820</u>
Utility Accounting <u>[Signature]</u>	Date <u>11/3/05</u>

VALID FOR SIX MONTHS FROM DATE OF ISSUANCE (Section 2.2.C.1 Grand Junction Zoning & Development Code)  
 (White: Planning) (Yellow: Customer) (Pink: Building Department) (Goldenrod: Utility Accounting)

173-05  
 ACCEPTED *Gayleen Henderson*  
 ANY CHANGE OF SETBACKS MUST BE APPROVED BY THE CITY PLANNING DEPARTMENT. THE APPLICANT'S RESPONSIBILITY TO PROPERLY LOCATE AND IDENTIFY EASEMENTS AND PROPERTY LINES.

**NOTE:**  
 GRADE MUST SLOPE AWAY FROM HOUSE 6" OF FALL IN THE FIRST 10' OF DISTANCE PER LOCAL BUILDING CODE.

**NOTE:**  
 DIMENSION LINES ARE PULLED FROM EDGE OF BRICK LEDGE. IF NO BRICK LEDGE EXISTS, DIMENSIONS WILL BE FROM EDGE OF FOUNDATION.

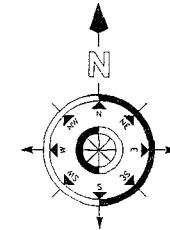


SITE PLAN INFORMATION

SUBDIVISION NAME	COUNTRY RIDGE ESTATES
FILING NUMBER	1
LOT NUMBER	3
BLOCK NUMBER	2
STREET ADDRESS	189 COUNTRY RIDGE RD.
COUNTY	MESA
GARAGE SQ. FT.	665 SF
LIVING SQ. FT.	1942 SF
LOT SIZE	8001 SF
SETBACKS USED	FRONT 20'
	SIDES 7'
	REAR 25'

**NOTE:**  
 BUILDER TO VERIFY ALL SETBACK AND EASEMENT ENCROACHMENTS PRIOR TO CONSTRUCTION

COUNTRY RIDGE ROAD

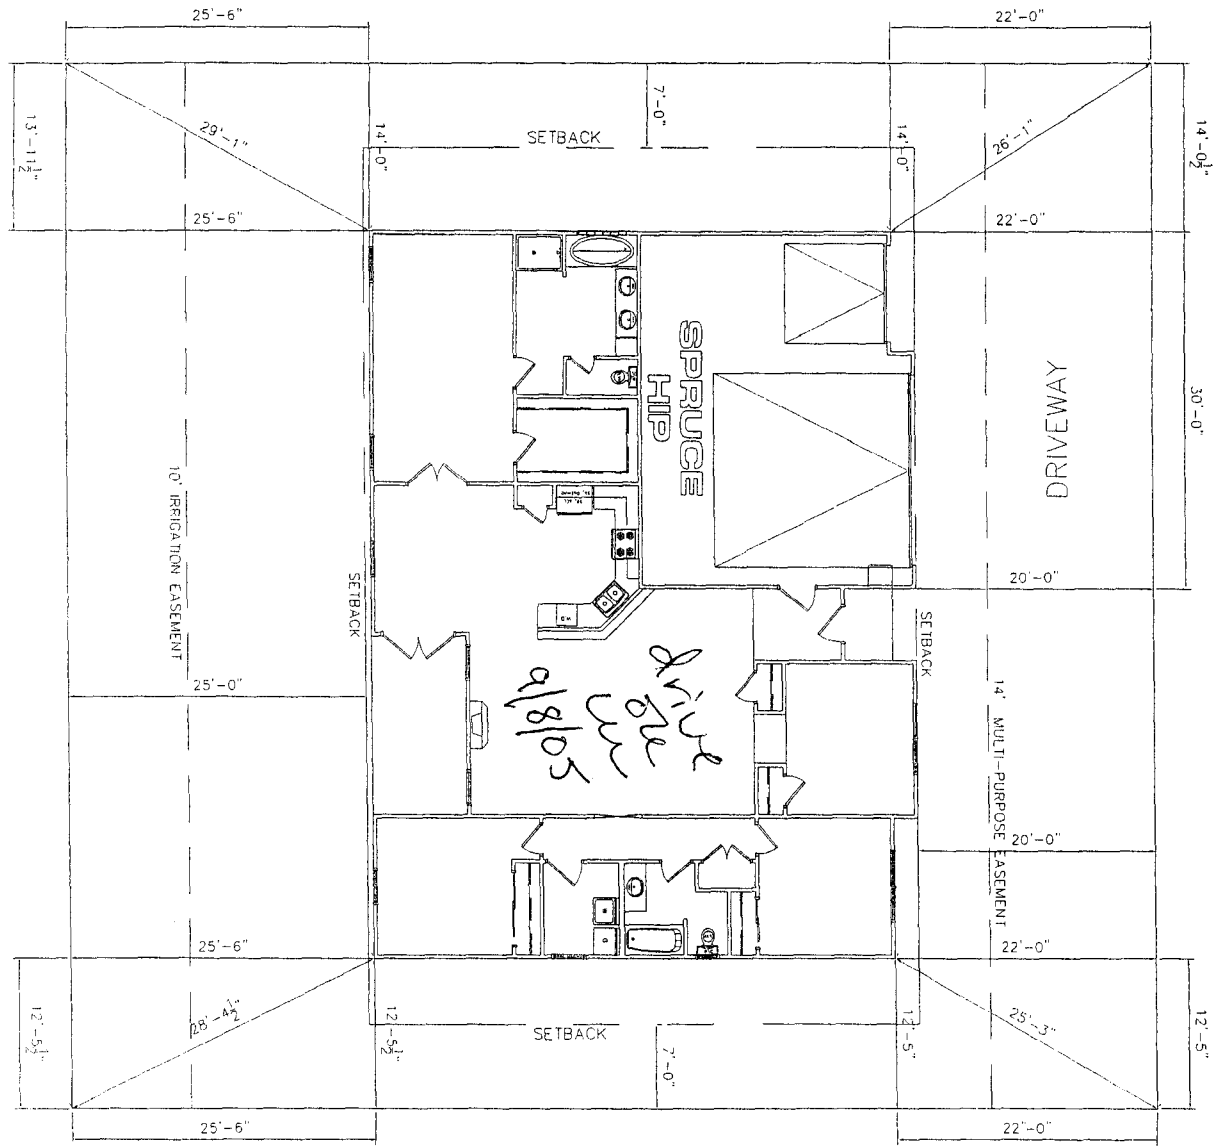

SCALE: 1/16" = 1'-0"

189 Country Ridge