

FEE \$	10.00
TCP \$	1500.00
SIF \$	292.00

PLANNING CLEARANCE
 (Single Family Residential and Accessory Structures)
Community Development Department

BLDG PERMIT NO. _____

Building Address 280 Gill Creek
 Parcel No. 2943 301 86 008
 Subdivision Unawee Heights
 Filing 2 Block 3 Lot 8

ⓐ

No. of Existing Bldgs 0 No. Proposed 0
 Sq. Ft. of Existing Bldgs 0 Sq. Ft. Proposed 1437
 Sq. Ft. of Lot / Parcel _____
 Sq. Ft. Coverage of Lot by Structures & Impervious Surface
 (Total Existing & Proposed) _____
 Height of Proposed Structure 8'1 1/8"

OWNER INFORMATION:

Name Pinnacle Homes
 Address 3111 F road
 City / State / Zip GJ CO 81504

DESCRIPTION OF WORK & INTENDED USE:
 New Single Family Home (*check type below)
 Interior Remodel Addition
 Other (please specify): _____

APPLICANT INFORMATION:

Name Pinnacle Homes
 Address 3111 F rd
 City / State / Zip Grand Jct CO 81504
 Telephone 241 6646

***TYPE OF HOME PROPOSED:**
 Site Built Manufactured Home (UBC)
 Manufactured Home (HUD)
 Other (please specify): _____

NOTES: New Home Construction

REQUIRED: One plot plan, on 8 1/2" x 11" paper, showing all existing & proposed structure location(s), parking, setbacks to all property lines, ingress/egress to the property, driveway location & width & all easements & rights-of-way which abut the parcel.

THIS SECTION TO BE COMPLETED BY COMMUNITY DEVELOPMENT DEPARTMENT STAFF			
ZONE <u>RSF-4</u>	Maximum coverage of lot by structures <u>50%</u>		
SETBACKS: Front <u>20'</u> from property line (PL)	Permanent Foundation Required: YES <input checked="" type="checkbox"/> NO <input type="checkbox"/>		
Side <u>7'</u> from PL Rear <u>25'</u> from PL	Parking Requirement <u>2</u>		
Maximum Height of Structure(s) <u>35'</u>	Special Conditions <u>Open hole foundation required by licensed engineer</u>		
Voting District <u>E</u>	Driveway Location Approval <u>lll</u> (Engineer's Initials)		

Modifications to this Planning Clearance must be approved, in writing, by the Community Development Department. The structure authorized by this application cannot be occupied until a final inspection has been completed and a Certificate of Occupancy has been issued, if applicable, by the Building Department (Section 305, Uniform Building Code).


I hereby acknowledge that I have read this application and the information is correct; I agree to comply with any and all codes, ordinances, laws, regulations or restrictions which apply to the project. I understand that failure to comply shall result in legal action, which may include but not necessarily be limited to non-use of the building(s).

Applicant Signature Merrick Macomber Date 3.28.05
 Department Approval H C Faye Hall Date 4/19/05

Additional water and/or sewer tap fee(s) are required:	YES	NO	W/O No.
Utility Accounting	Date		

VALID FOR SIX MONTHS FROM DATE OF ISSUANCE (Section 2.2.C.1 Grand Junction Zoning & Development Code)
 (White: Planning) (Yellow: Customer) (Pink: Building Department) (Goldenrod: Utility Accounting)

GILL CREEK CT.

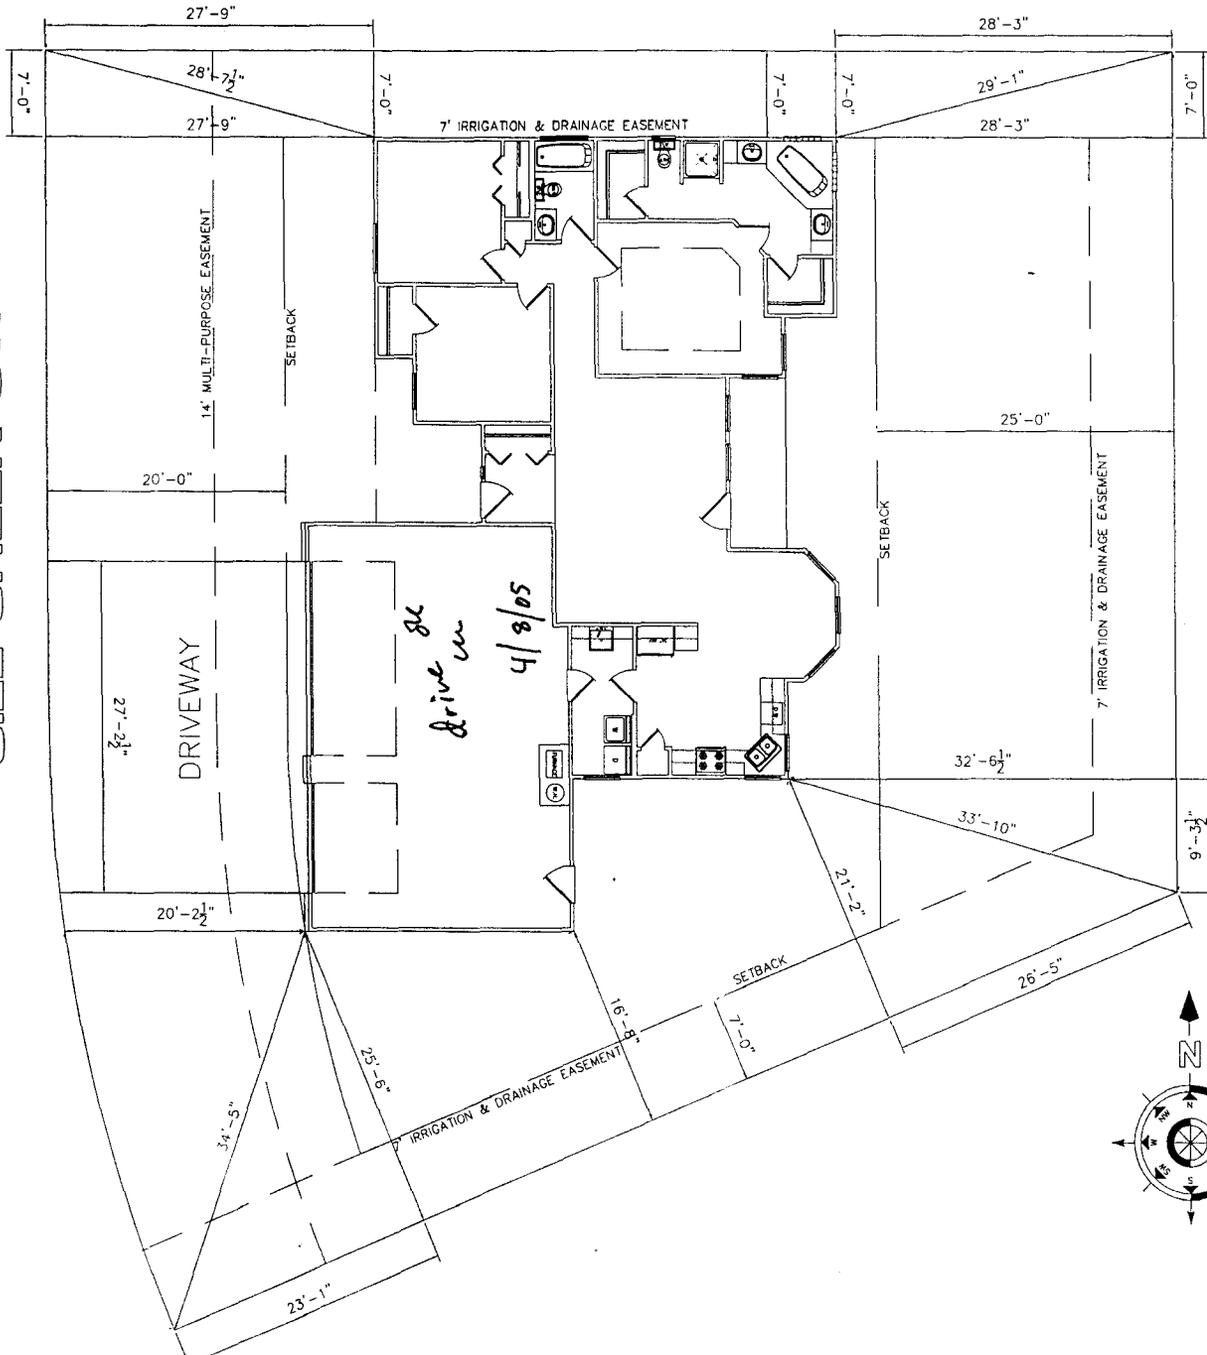


NOTE:
GRADE MUST SLOPE AWAY FROM HOUSE 6" OF FALL IN THE FIRST 10' OF DISTANCE PER LOCAL BUILDING CODE.

NOTE:
DIMENSION LINES ARE PULLED FROM EDGE OF BRICK LEDGE IF NO BRICK LEDGE EXISTS, DIMENSIONS WILL BE FROM EDGE OF FOUNDATION.

NOTE:
BUILDER TO VERIFY ALL SETBACK AND EASEMENT ENCROACHMENTS PRIOR TO CONSTRUCTION

SITE PLAN INFORMATION	
SUBDIVISION NAME	UNAWEEP HEIGHTS
FILING NUMBER	2
LOT NUMBER	8
BLOCK NUMBER	3
STREET ADDRESS	2806 GILL CREEK
COUNTY	MESA
GARAGE SQ. FT.	738 SF
COVERED ENTRY SQ. FT.	91 SF
COVERED PATIO SQ. FT.	66 SF
LIVING SQ. FT.	1438 SF
LOT SIZE	8244 SF
TOP OF FOUNDATION	MIN-4663.5 - MAX-4665.5
SETBACKS USED	FRONT 20'
	SIDES 7'
	REAR 25'

SCALE: 1/8" = 1'-0"

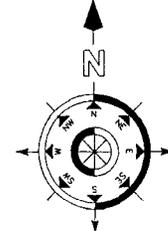

ACCEPTED *4/19/05*
C. J. Hall
ANY CHANGE OF SETBACKS MUST BE APPROVED BY THE CITY PLANNING DEPT. IT IS THE APPLICANT'S RESPONSIBILITY TO PROPERLY LOCATE AND IDENTIFY EASEMENTS AND PROPERTY LINES.