

FEE \$	10.00
TCP \$	0
SIF \$	292.00

PLANNING CLEARANCE
 (Single Family Residential and Accessory Structures)
Community Development Department

BLDG PERMIT NO. _____

Building Address 539 Hoover Ct
 Parcel No. 2943-094-79-010
 Subdivision Fruitvale Estates
 Filing 1 Block 2 Lot 10

No. of Existing Bldgs 0 No. Proposed 1
 Sq. Ft. of Existing Bldgs 2360 Sq. Ft. Proposed 2360
 Sq. Ft. of Lot / Parcel ≈ 8,015
 Sq. Ft. Coverage of Lot by Structures & Impervious Surface
 (Total Existing & Proposed) ≈ 3110
 Height of Proposed Structure ≈ 17'

OWNER INFORMATION:

Name Todd + Corey Van Burg
 Address 2250 Signal Rock Ct
 City / State / Zip GJ., CO 81505

DESCRIPTION OF WORK & INTENDED USE:

New Single Family Home (*check type below)
 Interior Remodel Addition
 Other (please specify): _____

APPLICANT INFORMATION:

Name Same as above
 Address _____
 City / State / Zip _____
 Telephone 970 270 6169

***TYPE OF HOME PROPOSED:**

Site Built Manufactured Home (UBC)
 Manufactured Home (HUD)
 Other (please specify): _____

NOTES: _____

REQUIRED: One plot plan, on 8 1/2" x 11" paper, showing all existing & proposed structure location(s), parking, setbacks to all property lines, ingress/egress to the property, driveway location & width & all easements & rights-of-way which abut the parcel.

THIS SECTION TO BE COMPLETED BY COMMUNITY DEVELOPMENT DEPARTMENT STAFF	
ZONE <u>RSF-4</u>	Maximum coverage of lot by structures <u>50%</u>
SETBACKS: Front <u>20'</u> from property line (PL)	Permanent Foundation Required: YES <u>X</u> NO _____
Side <u>7'</u> from PL Rear <u>25'</u> from PL	Parking Requirement <u>2</u>
Maximum Height of Structure(s) <u>35'</u>	Special Conditions <u>Engineered Foundation Required</u>
Voting District <u>C</u> Driveway Location Approval <u>RAD</u> (Engineer's Initials)	

Modifications to this Planning Clearance must be approved, in writing, by the Community Development Department. The structure authorized by this application cannot be occupied until a final inspection has been completed and a Certificate of Occupancy has been issued, if applicable, by the Building Department (Section 305, Uniform Building Code).


I hereby acknowledge that I have read this application and the information is correct; I agree to comply with any and all codes, ordinances, laws, regulations or restrictions which apply to the project. I understand that failure to comply shall result in legal action, which may include but not necessarily be limited to non-use of the building(s).

Applicant Signature Todd Van Burg Date 8/26/05
 Department Approval [Signature] Date 9-1-05

Additional water and/or sewer tap fee(s) are required: YES <u>0</u> NO _____	W/O No. <u>18371</u>
Utility Accounting <u>[Signature]</u>	Date <u>9/1/05</u>

VALID FOR SIX MONTHS FROM DATE OF ISSUANCE (Section 2.2.C.1 Grand Junction Zoning & Development Code)
 (White: Planning) (Yellow: Customer) (Pink: Building Department) (Goldenrod: Utility Accounting)

HOOVER COURT

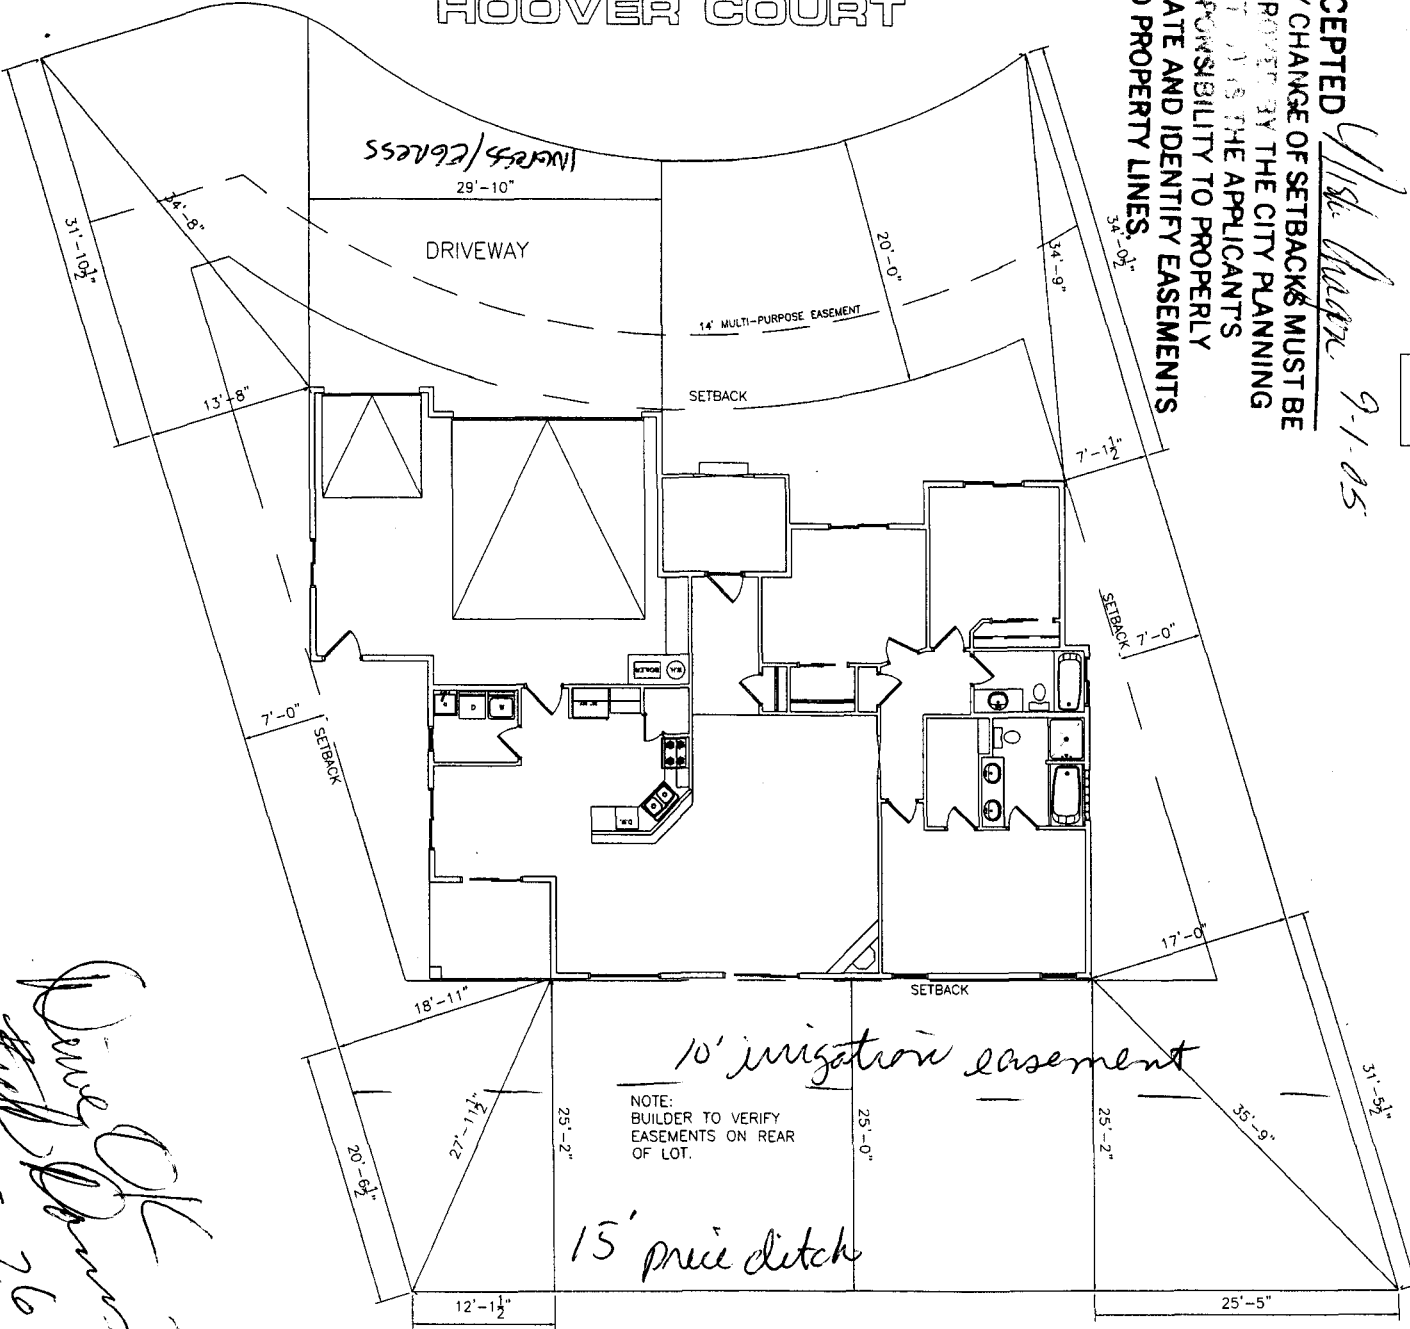

ACCEPTED
 ANY CHANGE OF SETBACKS MUST BE APPROVED BY THE CITY PLANNING DEPT. IT IS THE APPLICANTS RESPONSIBILITY TO PROPERLY LOCATE AND IDENTIFY EASEMENTS AND PROPERTY LINES.

W. H. Moore
 9-1-05

NOTE:
 BUILDER TO VERIFY ALL SETBACK AND EASEMENT ENCROACHMENTS PRIOR TO CONSTRUCTION

NOTE:
 GRADE MUST SLOPE AWAY FROM HOUSE 6" OF FALL IN THE FIRST 10' OF DISTANCE PER LOCAL BUILDING CODE.

NOTE:
 DIMENSION LINES ARE PULLED FROM EDGE OF BRICK LEDGE. IF NO BRICK LEDGE EXISTS, DIMENSIONS WILL BE FROM EDGE OF FOUNDATION.

SITE PLAN INFORMATION	
SUBDIVISION NAME	FRUITVALE ESTATES
FILING NUMBER	N/A
LOT NUMBER	10
BLOCK NUMBER	2
STREET ADDRESS	539 HOOVER COURT
COUNTY	MESA
GARAGE SQ. FT.	691 SF
LIVING SQ. FT.	1671 SF
LOT SIZE	0.184 ACRES
SETBACKS USED	FRONT 20' SIDES 7' REAR 25'

Divide OK
8-26-05

SCALE: 1/16" = 1'-0"