

FEE \$ 10⁰⁰
 TCP \$ 1500⁰⁰
 SIF \$ ~~297⁰⁰~~ (credit)

PLANNING CLEARANCE

(Single Family Residential and Accessory Structures)

Community Development Department

BLDG PERMIT NO. _____

Building Address 2946 Joan Way
 Parcel No. 2943-053-00-033
 Subdivision Summit View Estates
 Filing 1 Block 2 Lot 8

No. of Existing Bldgs 0 No. Proposed 1
 Sq. Ft. of Existing Bldgs N/A Sq. Ft. Proposed 1894
 Sq. Ft. of Lot / Parcel 6268
 Sq. Ft. Coverage of Lot by Structures & Impervious Surface (Total Existing & Proposed) 1838

OWNER INFORMATION:

Name Zeck Homes, Inc.
 Address 1950 Hwy 6+50
 City / State / Zip Fruita, CO 81521

DESCRIPTION OF WORK & INTENDED USE:

New Single Family Home (*check type below)
 Interior Remodel Addition
 Other (please specify): _____

APPLICANT INFORMATION:

Name Zeck Homes, Inc.
 Address 1950 Hwy 6+50
 City / State / Zip Fruita, CO 81521
 Telephone (970) 858-0178

***TYPE OF HOME PROPOSED:**

Site Built Manufactured Home (UBC)
 Manufactured Home (HUD)
 Other (please specify): _____

NOTES: _____

REQUIRED: One plot plan, on 8 1/2" x 11" paper, showing all existing & proposed structure location(s), parking, setbacks to all property lines, ingress/egress to the property, driveway location & width & all easements & rights-of-way which abut the parcel.

THIS SECTION TO BE COMPLETED BY COMMUNITY DEVELOPMENT DEPARTMENT STAFF			
ZONE <u>RMF-8</u>	Maximum coverage of lot by structures <u>70%</u>		
SETBACKS: Front <u>20'</u> from property line (PL)	Permanent Foundation Required: YES <u>X</u> NO _____		
Side <u>5'</u> from PL Rear <u>10'</u> from PL	Parking Requirement <u>2</u>		
Maximum Height of Structure(s) <u>35'</u>	Special Conditions _____		
Voting District <u>D</u>	Driveway Location Approval <u>RAT</u> (Engineer's Initials)		

Modifications to this Planning Clearance must be approved, in writing, by the Community Development Department. The structure authorized by this application cannot be occupied until a final inspection has been completed and a Certificate of Occupancy has been issued, if applicable, by the Building Department (Section 305, Uniform Building Code).

I hereby acknowledge that I have read this application and the information is correct; I agree to comply with any and all codes, ordinances, laws, regulations or restrictions which apply to the project. I understand that failure to comply shall result in legal action, which may include but not necessarily be limited to non-use of the building(s).


Applicant Signature Juni Arnold Date 11/30/04
 Department Approval Gaylean Henderson Date 2-16-05

Additional water and/or sewer tap fee(s) are required: YES <input checked="" type="checkbox"/> NO <input type="checkbox"/>	W/O No. <u>PL CGVBD</u>
Utility Accounting <u>D Arnold</u>	Date <u>2/16/05</u>


VALID FOR SIX MONTHS FROM DATE OF ISSUANCE (Section 2.2.C.1 Grand Junction Zoning & Development Code)
 (White: Planning) (Yellow: Customer) (Pink: Building Department) (Goldenrod: Utility Accounting)

2-16-05
Gayle Henderson

ACCEPTED
ANY CHANGE OF SETBACKS MUST BE APPROVED BY THE CITY PLANNING DEPT. IT IS THE OWNER'S RESPONSIBILITY TO PROPERLY LOCATE AND MARK EASEMENTS AND PROPERTY LINES.

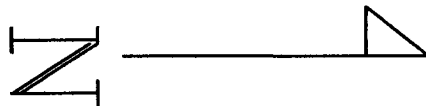

76.55'

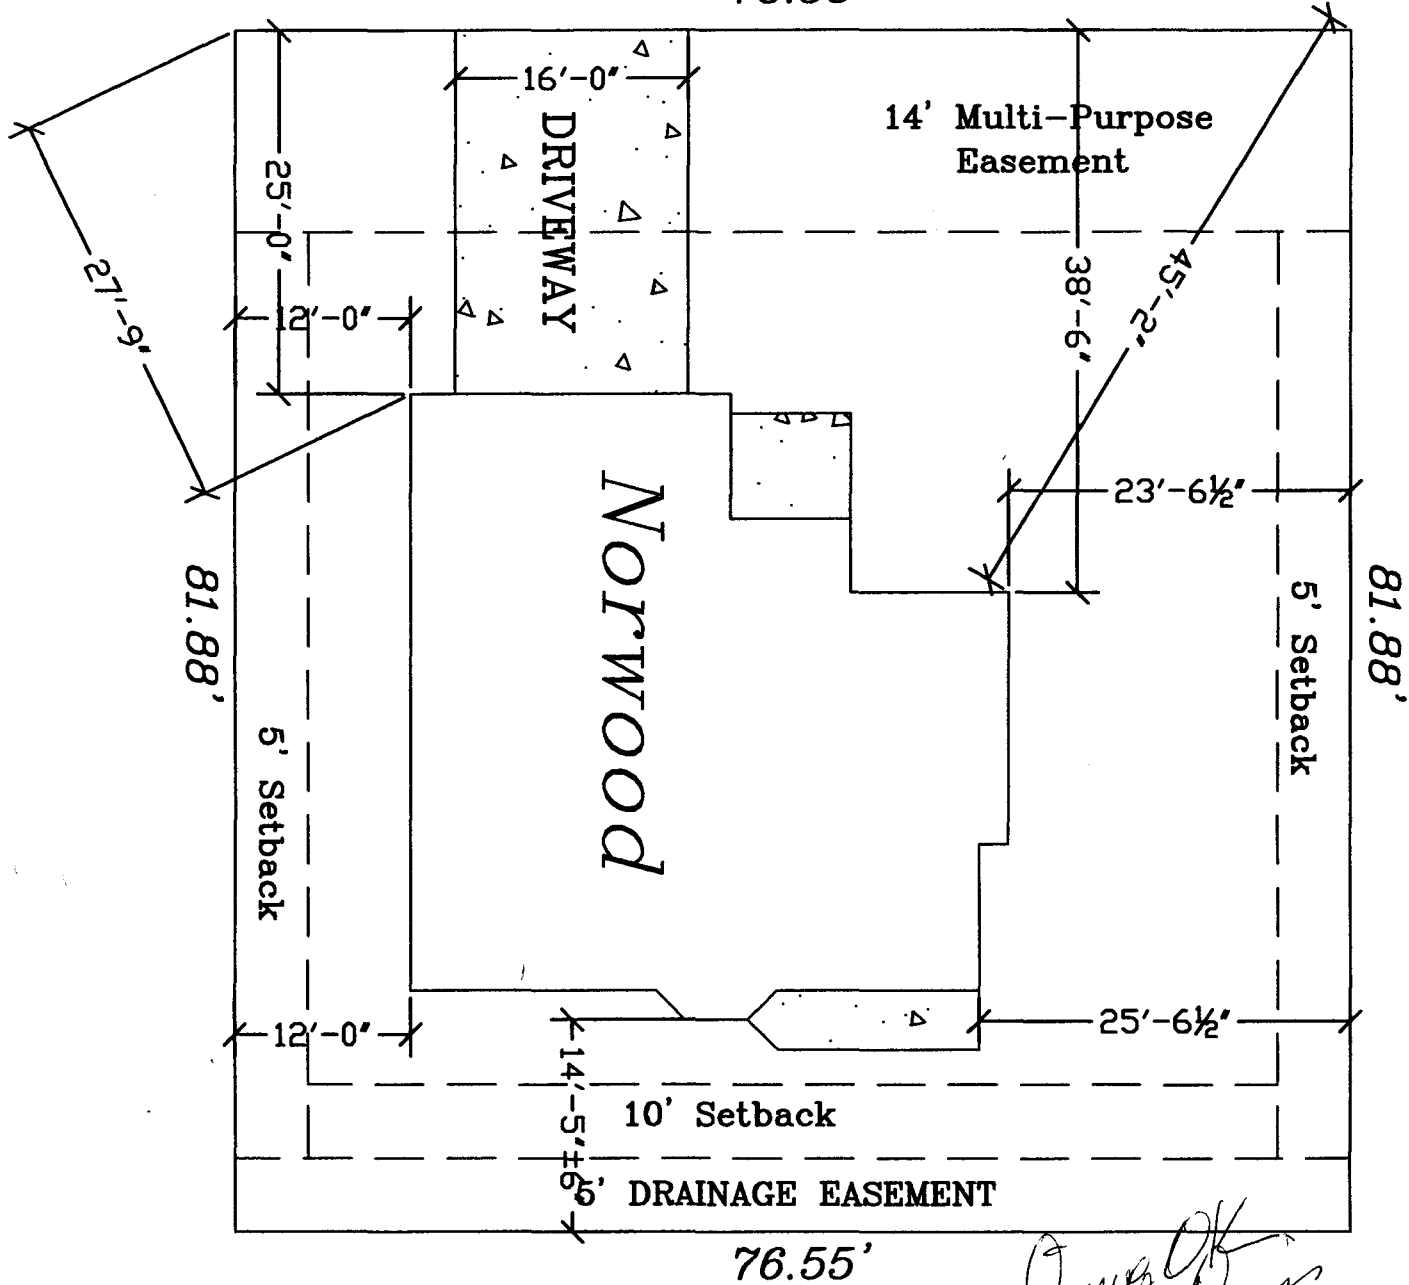

*Dying Ok
Rick Davis
2-10-05*