

FEE \$ 10.00  
 TCP \$ 1500.00  
 SIF \$ 292.00

**PLANNING CLEARANCE**  
 (Single Family Residential and Accessory Structures)  
Community Development Department

BLDG PERMIT NO. \_\_\_\_\_

Building Address 685 Kupata  
 Parcel No. 2945-031-70-003  
 Subdivision Valley Meadows North  
 Filing \_\_\_\_\_ Block 3 Lot 3

No. of Existing Bldgs 0 No. Proposed 1  
 Sq. Ft. of Existing Bldgs \_\_\_\_\_ Sq. Ft. Proposed 2634  
 Sq. Ft. of Lot / Parcel 11239  
 Sq. Ft. Coverage of Lot by Structures & Impervious Surface (Total Existing & Proposed) \_\_\_\_\_  
 Height of Proposed Structure \_\_\_\_\_

**OWNER INFORMATION:**

Name Leonard W Page  
 Address 708 Willow Creek Rd  
 City / State / Zip Grand Jct CO 81505

**DESCRIPTION OF WORK & INTENDED USE:**

New Single Family Home (\*check type below)  
 Interior Remodel  Addition  
 Other (please specify): \_\_\_\_\_

**APPLICANT INFORMATION:**

Name \_\_\_\_\_  
 Address \_\_\_\_\_  
 City / State / Zip \_\_\_\_\_  
 Telephone \_\_\_\_\_

**\*TYPE OF HOME PROPOSED:**

Site Built  Manufactured Home (UBC)  
 Manufactured Home (HUD)  
 Other (please specify): \_\_\_\_\_

NOTES: \_\_\_\_\_

**REQUIRED: One plot plan, on 8 1/2" x 11" paper, showing all existing & proposed structure location(s), parking, setbacks to all property lines, ingress/egress to the property, driveway location & width & all easements & rights-of-way which abut the parcel.**

**THIS SECTION TO BE COMPLETED BY COMMUNITY DEVELOPMENT DEPARTMENT STAFF**

ZONE RSF-4 Maximum coverage of lot by structures 50%  
 SETBACKS: Front 20' from property line (PL) Permanent Foundation Required: YES  NO \_\_\_\_\_  
 Side 7' from PL Rear 25' from PL Parking Requirement 2  
 Maximum Height of Structure(s) 35' Special Conditions \_\_\_\_\_  
 Voting District B Driveway Location Approval lee  
 (Engineer's Initials)


Modifications to this Planning Clearance must be approved, in writing, by the Community Development Department. The structure authorized by this application cannot be occupied until a final inspection has been completed and a Certificate of Occupancy has been issued, if applicable, by the Building Department (Section 305, Uniform Building Code).

I hereby acknowledge that I have read this application and the information is correct; I agree to comply with any and all codes, ordinances, laws, regulations or restrictions which apply to the project. I understand that failure to comply shall result in legal action, which may include but not necessarily be limited to non-use of the building(s).

Applicant Signature \_\_\_\_\_ Date 7-12-05  
 Department Approval JH Hayden Henderson Date 7-13-05


Additional water and/or sewer tap fee(s) are required:  YES  NO W/O No. 18241  
 Utility Accounting Overhead Date 7/13/05

VALID FOR SIX MONTHS FROM DATE OF ISSUANCE (Section 2.2.C.1 Grand Junction Zoning & Development Code)  
 (White: Planning) (Yellow: Customer) (Pink: Building Department) (Goldenrod: Utility Accounting)

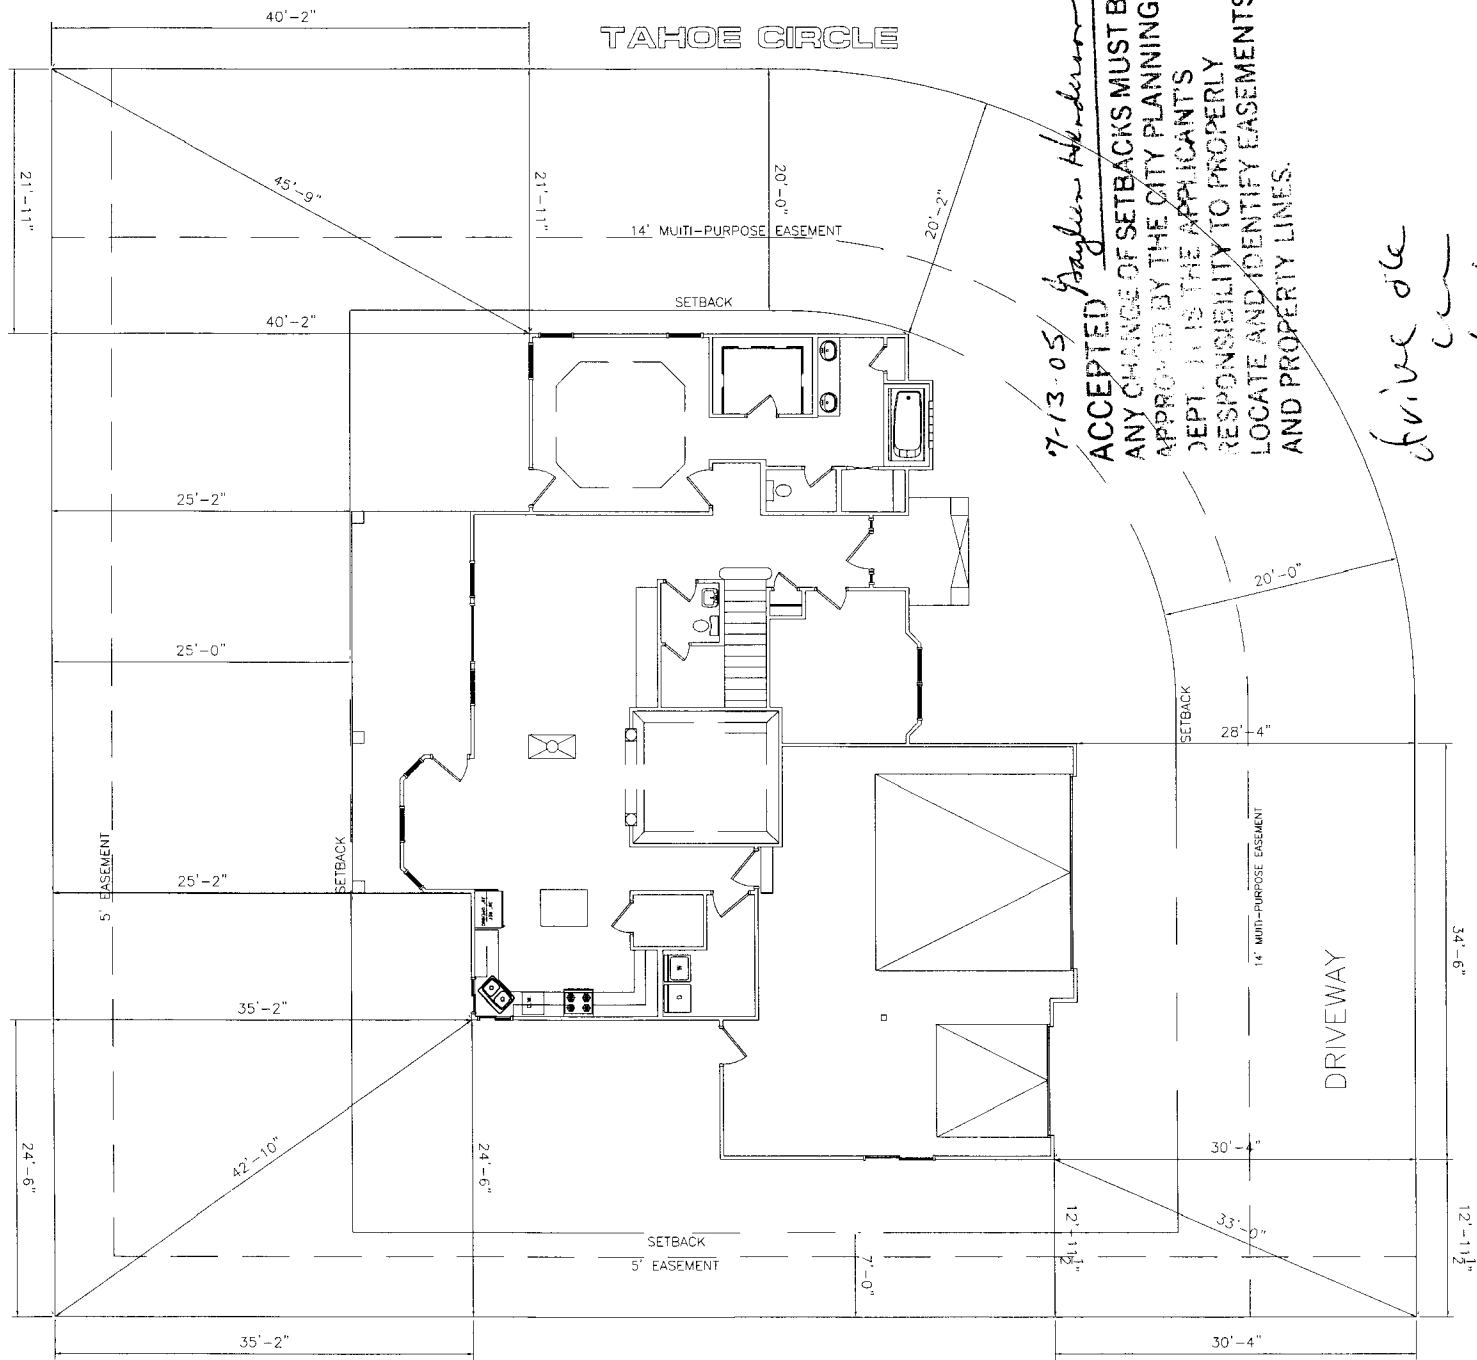

7-13-05/ Gaylen Anderson  
 ACCEPTED  
 ANY CHANGE OF SETBACKS MUST BE APPROVED BY THE CITY PLANNING DEPT. IT IS THE APPLICANT'S RESPONSIBILITY TO PROPERLY LOCATE AND IDENTIFY EASEMENTS AND PROPERTY LINES.

drive ok  
 7/13/05

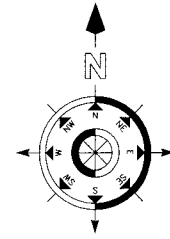

NOTE:  
 BUILDER TO VERIFY ALL SETBACK AND EASEMENT ENCROACHMENTS PRIOR TO CONSTRUCTION

NOTE:  
 GRADE MUST SLOPE AWAY FROM HOUSE 6" OF FALL IN THE FIRST 10' OF DISTANCE PER LOCAL BUILDING CODE.

NOTE:  
 DIMENSION LINES ARE PULLED FROM EDGE OF BRICK LEDGE IF NO BRICK LEDGE EXISTS, DIMENSIONS WILL BE FROM EDGE OF FOUNDATION.

SITE PLAN INFORMATION	
SUBDIVISION NAME	VALLEY MEADOWS NORTH
FILING NUMBER	1
BLOCK NUMBER	3
LOT NUMBER	3
STREET ADDRESS	? KAPOTA STREET
COUNTY	MESA
GARAGE SQ. FT.	915 SF
LIVING SQ. FT.	2636 SF
LOT SIZE	11,239 SF
FRONT	20'
SETBACKS USED	SIDES 7' REAR 25'

SCALE: 1/16" = 1'-0"