


ACCEPTED *Brawson 2/22/05*
 ANY CHANGE OF SETBACKS MUST BE
 APPROVED BY THE CITY PLANNING
 DEPARTMENT. THE APPLICANT'S
 RESPONSIBILITY TO PROPERLY
 LOCATE AND IDENTIFY EASEMENTS
 AND PROPERTY LINES.

for planning clearance and permit

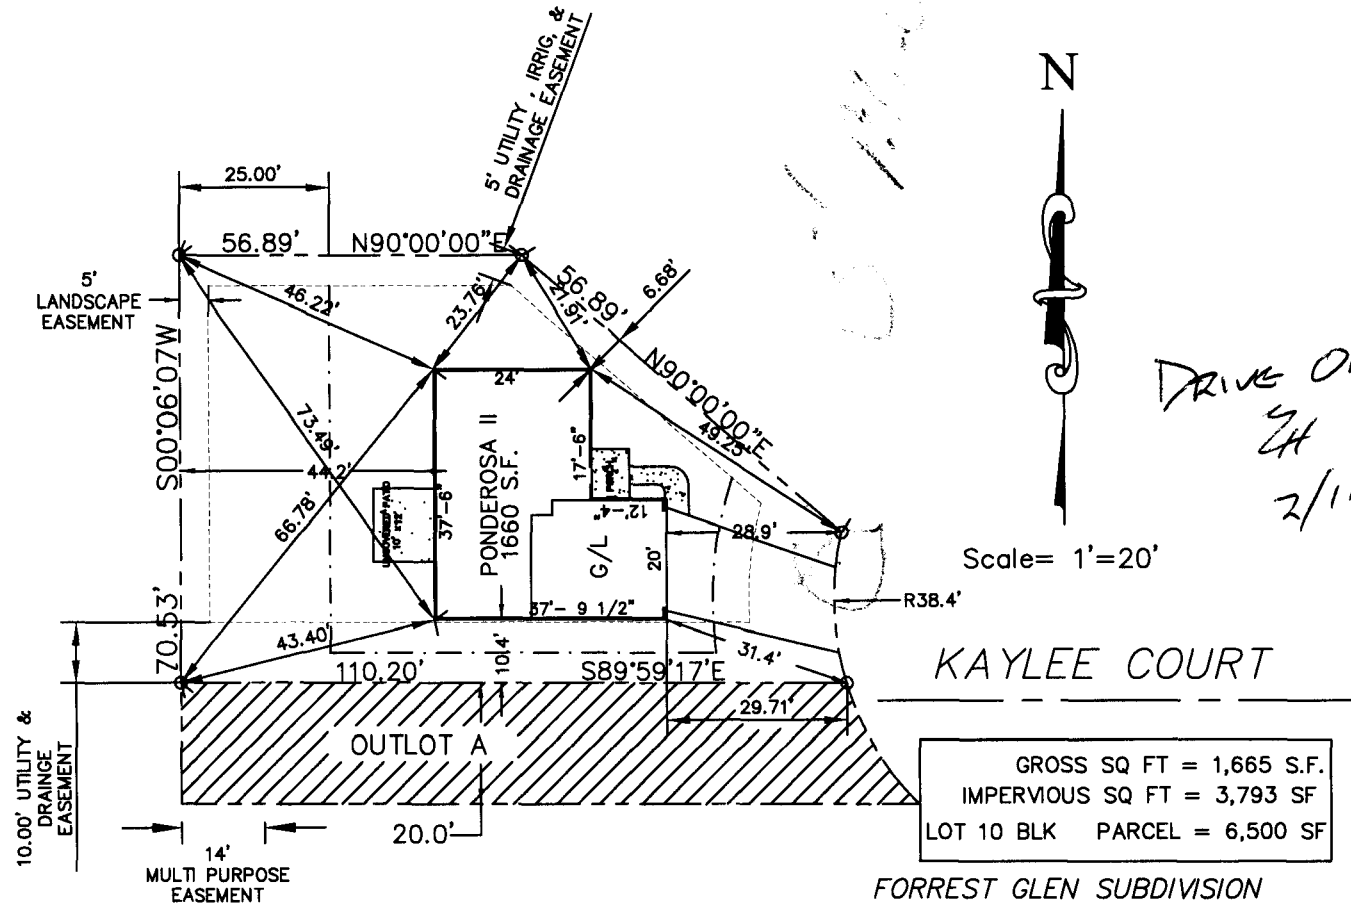

*DRIVE OK
 GH
 2/11/05*

FORREST GLEN SUBDIVISION
 2900 KAYLEE COURT
 Lot 10 16-NOV-04
 REV'D 2-DEC-04
 7-JAN-05
 26-JAN-05