

FEE \$	10.00
TCP \$	1500.00
SIF \$	0

PLANNING CLEARANCE

(Single Family Residential and Accessory Structures)

Community Development Department

BLDG PERMIT NO. _____

Building Address 637 Longs Peak Court No. of Existing Bldgs 0 No. Proposed 1
 Parcel No. 2943-053-81-008 Sq. Ft. of Existing Bldgs N/A Sq. Ft. Proposed 1993
 Subdivision Summit View Estates Sq. Ft. of Lot / Parcel 6000
 Filing 1 Block 4 Lot 8 Sq. Ft. Coverage of Lot by Structures & Impervious Surface (Total Existing & Proposed) 2393
 Height of Proposed Structure 21'-8"

OWNER INFORMATION:

Name Zeck Homes, Inc.
 Address 1950 Highway 6 and 50
 City / State / Zip Fruita, CO 81521

DESCRIPTION OF WORK & INTENDED USE:

New Single Family Home (*check type below)
 Interior Remodel Addition
 Other (please specify): _____

APPLICANT INFORMATION:

Name Zeck Homes, Inc.
 Address 1950 Highway 6 and 50
 City / State / Zip Fruita, CO 81521
 Telephone (970) 858-0178

***TYPE OF HOME PROPOSED:**

Site Built Manufactured Home (UBC)
 Manufactured Home (HUD)
 Other (please specify): _____

NOTES: _____

REQUIRED: One plot plan, on 8 1/2" x 11" paper, showing all existing & proposed structure location(s), parking, setbacks to all property lines, ingress/egress to the property, driveway location & width & all easements & rights-of-way which abut the parcel.

THIS SECTION TO BE COMPLETED BY COMMUNITY DEVELOPMENT DEPARTMENT STAFF

ZONE RMF-8 Maximum coverage of lot by structures 70%
 SETBACKS: Front 20' from property line (PL) Permanent Foundation Required: YES X NO _____
 Side 5' from PL Rear 10' from PL Parking Requirement 2
 Maximum Height of Structure(s) 35' Special Conditions _____
 Voting District D Driveway Location Approval UL
 (Engineer's Initials)

Modifications to this Planning Clearance must be approved, in writing, by the Community Development Department. The structure authorized by this application cannot be occupied until a final inspection has been completed and a Certificate of Occupancy has been issued, if applicable, by the Building Department (Section 305, Uniform Building Code).


I hereby acknowledge that I have read this application and the information is correct; I agree to comply with any and all codes, ordinances, laws, regulations or restrictions which apply to the project. I understand that failure to comply shall result in legal action, which may include but not necessarily be limited to non-use of the building(s).


Applicant Signature Jeni Arnold Date 2/17/05
 Department Approval [Signature] Date 3/10/05

Additional water and/or sewer tap fee(s) are required:	YES <u>X</u>	NO	W/O No. <u>PL CGVSD</u>
Utility Accounting <u>[Signature]</u>	Date <u>3/10/05</u>		

VALID FOR SIX MONTHS FROM DATE OF ISSUANCE (Section 2.2.C.1 Grand Junction Zoning & Development Code)
 (White: Planning) (Yellow: Customer) (Pink: Building Department) (Goldenrod: Utility Accounting)

ACCEPTED *Alshu Orager* 3/10/05
 ANY CHANGE OF SETBACKS MUST BE APPROVED BY THE CITY PLANNING DEPARTMENT. APPLICANTS NEED TO PROPERLY LOCATE AND IDENTIFY EASEMENTS AND PROPERTY LINES.

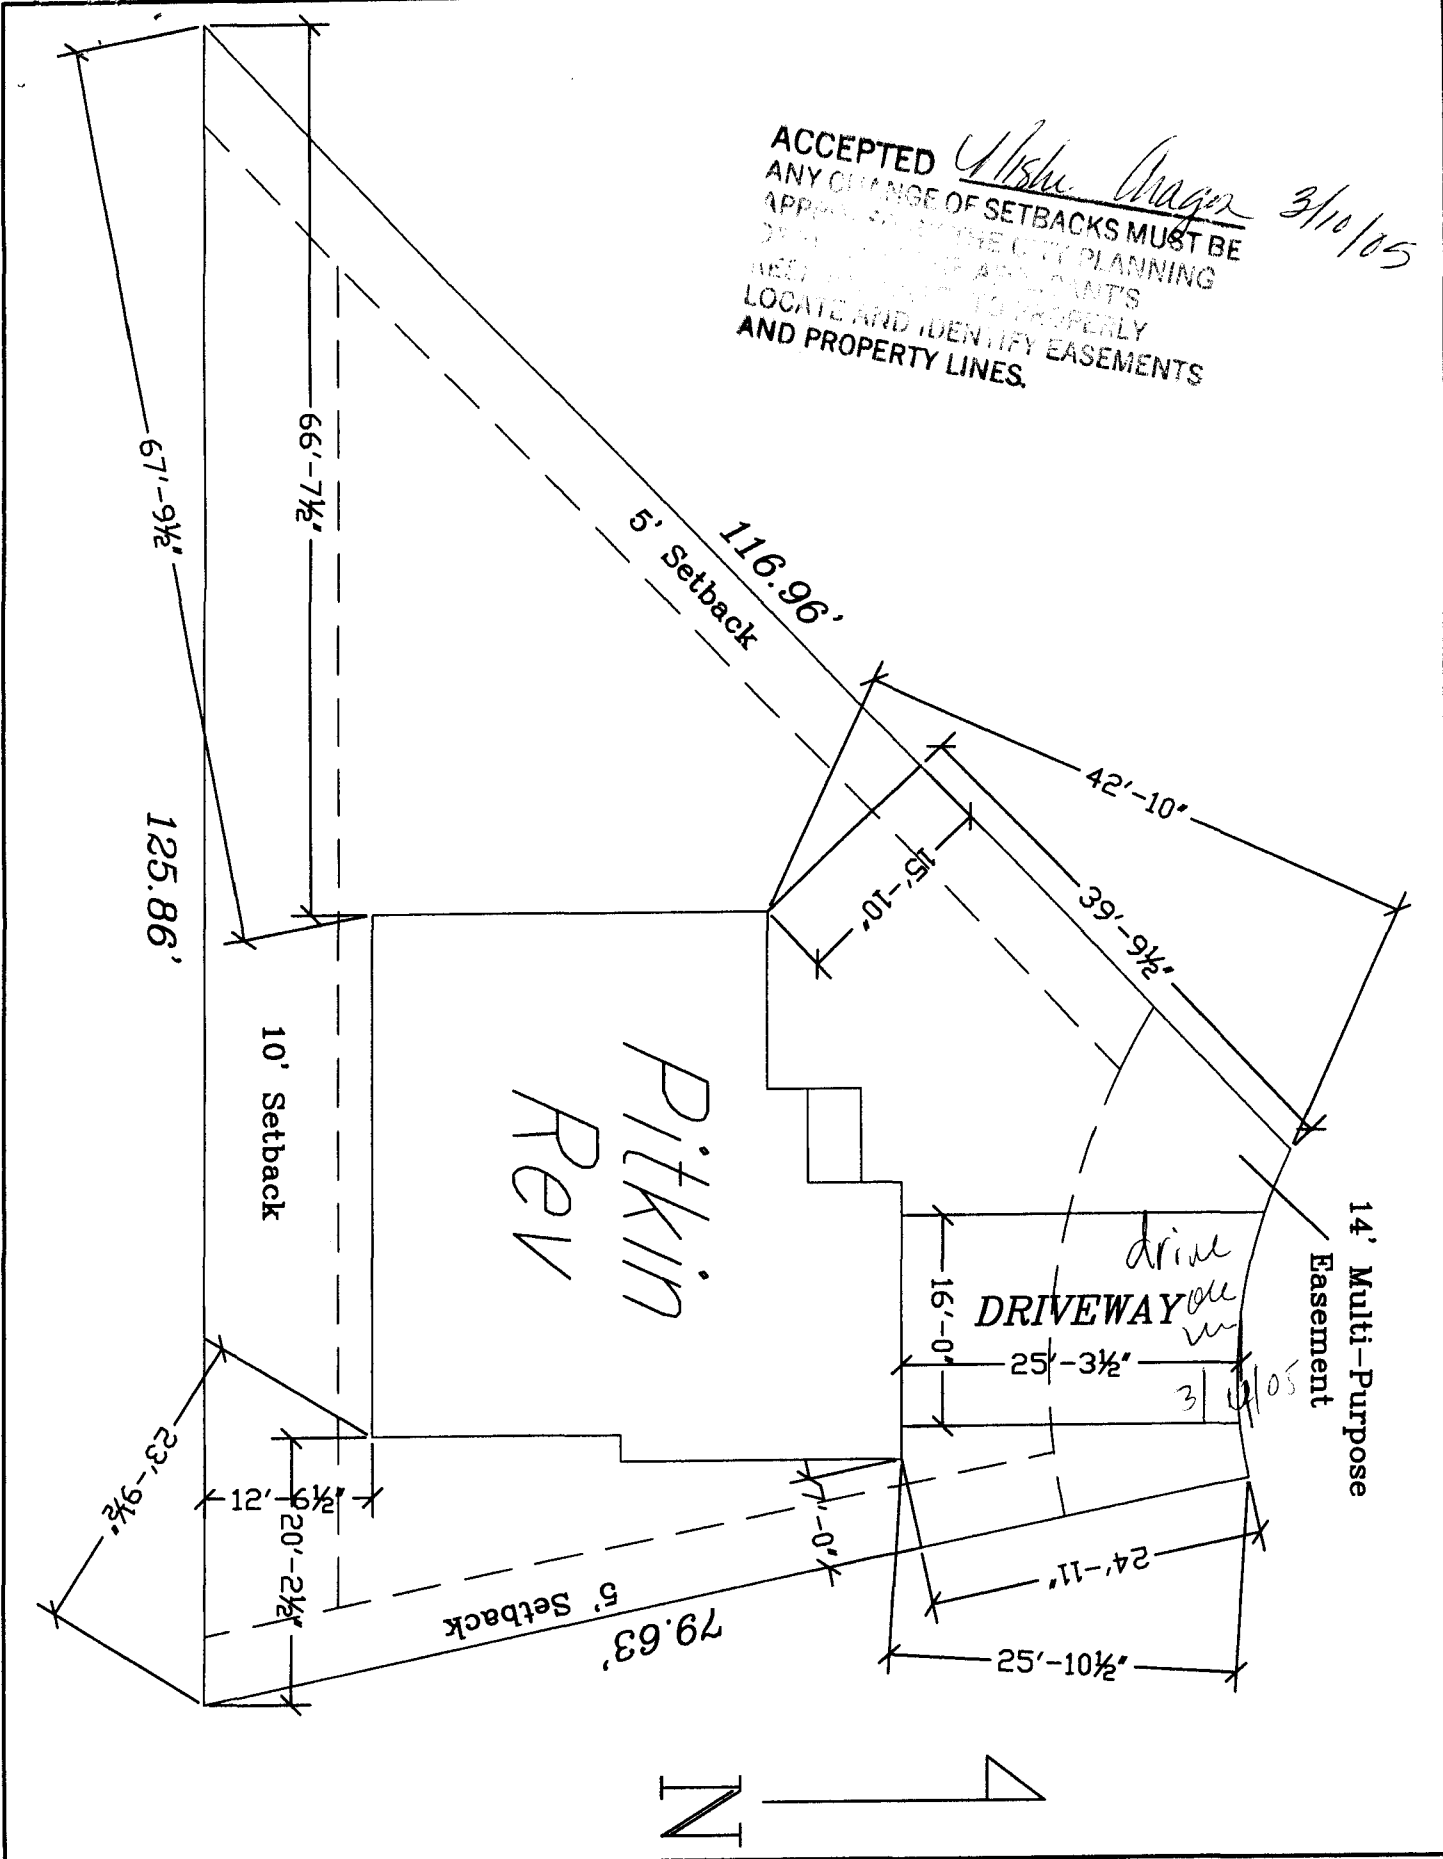

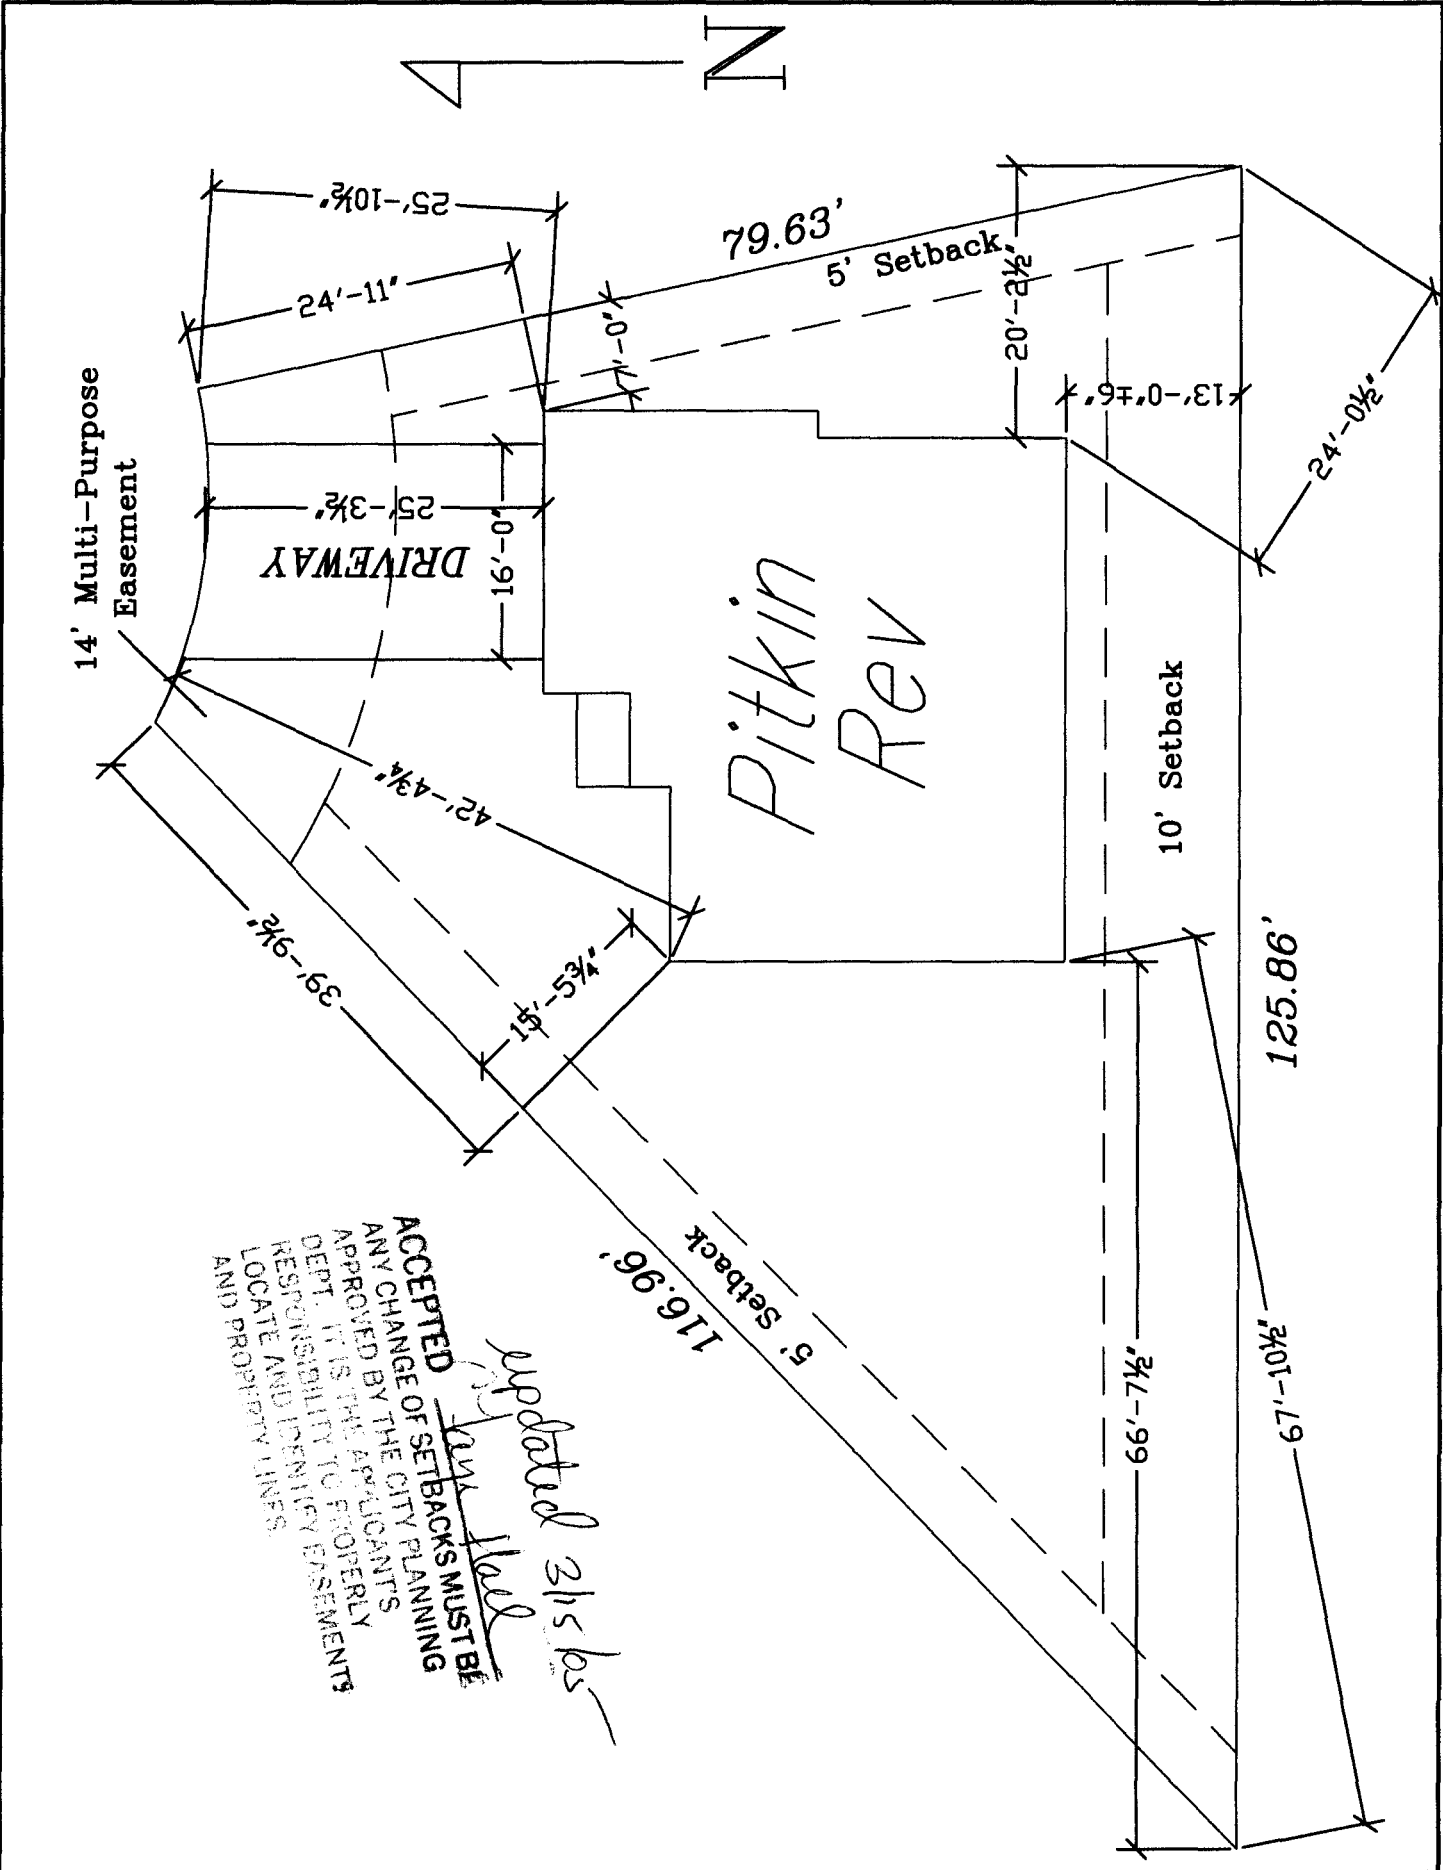

ACCEPTED SETBACKS MUST BE
 ANY CHANGE BY THE APPLICANT'S
 APPROVED BY THE CITY PLANNING
 DEPT. IT IS THE APPLICANT'S
 RESPONSIBILITY TO PROPERLY
 LOCATE AND IDENTIFY EASEMENTS
 AND PROPERTY LINES.

updated 3/15/20
AW Hall