

FEE \$ 10.00
 TCP \$ 1500.00
 SIF \$ 0

PLANNING CLEARANCE
 (Single Family Residential and Accessory Structures)
Community Development Department

BLDG PERMIT NO. _____

Building Address 6416 Longs Peak Dr
 Parcel No. 2943-053-78-013
 Subdivision Summit View Estates
 Filing 1 Block 1 Lot 13

No. of Existing Bldgs 0 No. Proposed 1
 Sq. Ft. of Existing Bldgs 0 Sq. Ft. Proposed 1917
 Sq. Ft. of Lot / Parcel 6471
 Sq. Ft. Coverage of Lot by Structures & Impervious Surface
 (Total Existing & Proposed) ~~1917~~ 2317
 Height of Proposed Structure _____

OWNER INFORMATION:

Name Zeck Homes, Inc.
 Address 1950 Hwy 6 + 50
 City / State / Zip Fruita, CO 81521

DESCRIPTION OF WORK & INTENDED USE:

New Single Family Home (*check type below)
 Interior Remodel Addition
 Other (please specify): _____

APPLICANT INFORMATION:

Name Zeck Homes, Inc.
 Address 1950 Hwy 6 + 50
 City / State / Zip Fruita, CO 81521
 Telephone (970) 858-0178

***TYPE OF HOME PROPOSED:**

Site Built Manufactured Home (UBC)
 Manufactured Home (HUD)
 Other (please specify): _____

NOTES: _____

REQUIRED: One plot plan, on 8 1/2" x 11" paper, showing all existing & proposed structure location(s), parking, setbacks to all property lines, ingress/egress to the property, driveway location & width & all easements & rights-of-way which abut the parcel.

THIS SECTION TO BE COMPLETED BY COMMUNITY DEVELOPMENT DEPARTMENT STAFF

ZONE RMF-8 Maximum coverage of lot by structures 70%
 SETBACKS: Front 20' from property line (PL) Permanent Foundation Required: YES X NO _____
 Side 5' from PL Rear 10' from PL Parking Requirement 2
 Maximum Height of Structure(s) 35' Special Conditions _____
 Voting District D Driveway Location Approval [Signature]
 (Engineer's Initials)

Modifications to this Planning Clearance must be approved, in writing, by the Community Development Department. The structure authorized by this application cannot be occupied until a final inspection has been completed and a Certificate of Occupancy has been issued, if applicable, by the Building Department (Section 305, Uniform Building Code).

I hereby acknowledge that I have read this application and the information is correct; I agree to comply with any and all codes, ordinances, laws, regulations or restrictions which apply to the project. I understand that failure to comply shall result in legal action, which may include but not necessarily be limited to non-use of the building(s).


Applicant Signature [Signature] Date 8-15-05
 Department Approval [Signature] Date 8/24/05

Additional water and/or sewer tap fee(s) are required: YES NO W/O No.

Utility Accounting [Signature] Date 8-24-05

VALID FOR SIX MONTHS FROM DATE OF ISSUANCE (Section 2.2.C.1 Grand Junction Zoning & Development Code)
 (White: Planning) (Yellow: Customer) (Pink: Building Department) (Goldenrod: Utility Accounting)

ACCEPTED *Staylos*
Chase Hall
 ANY CHANGE OF SETBACKS MUST BE APPROVED BY THE CITY PLANNING DEPT. IT IS THE APPLICANT'S RESPONSIBILITY TO PROPERLY LOCATE AND IDENTIFY EASEMENTS AND PROPERTY LINES.

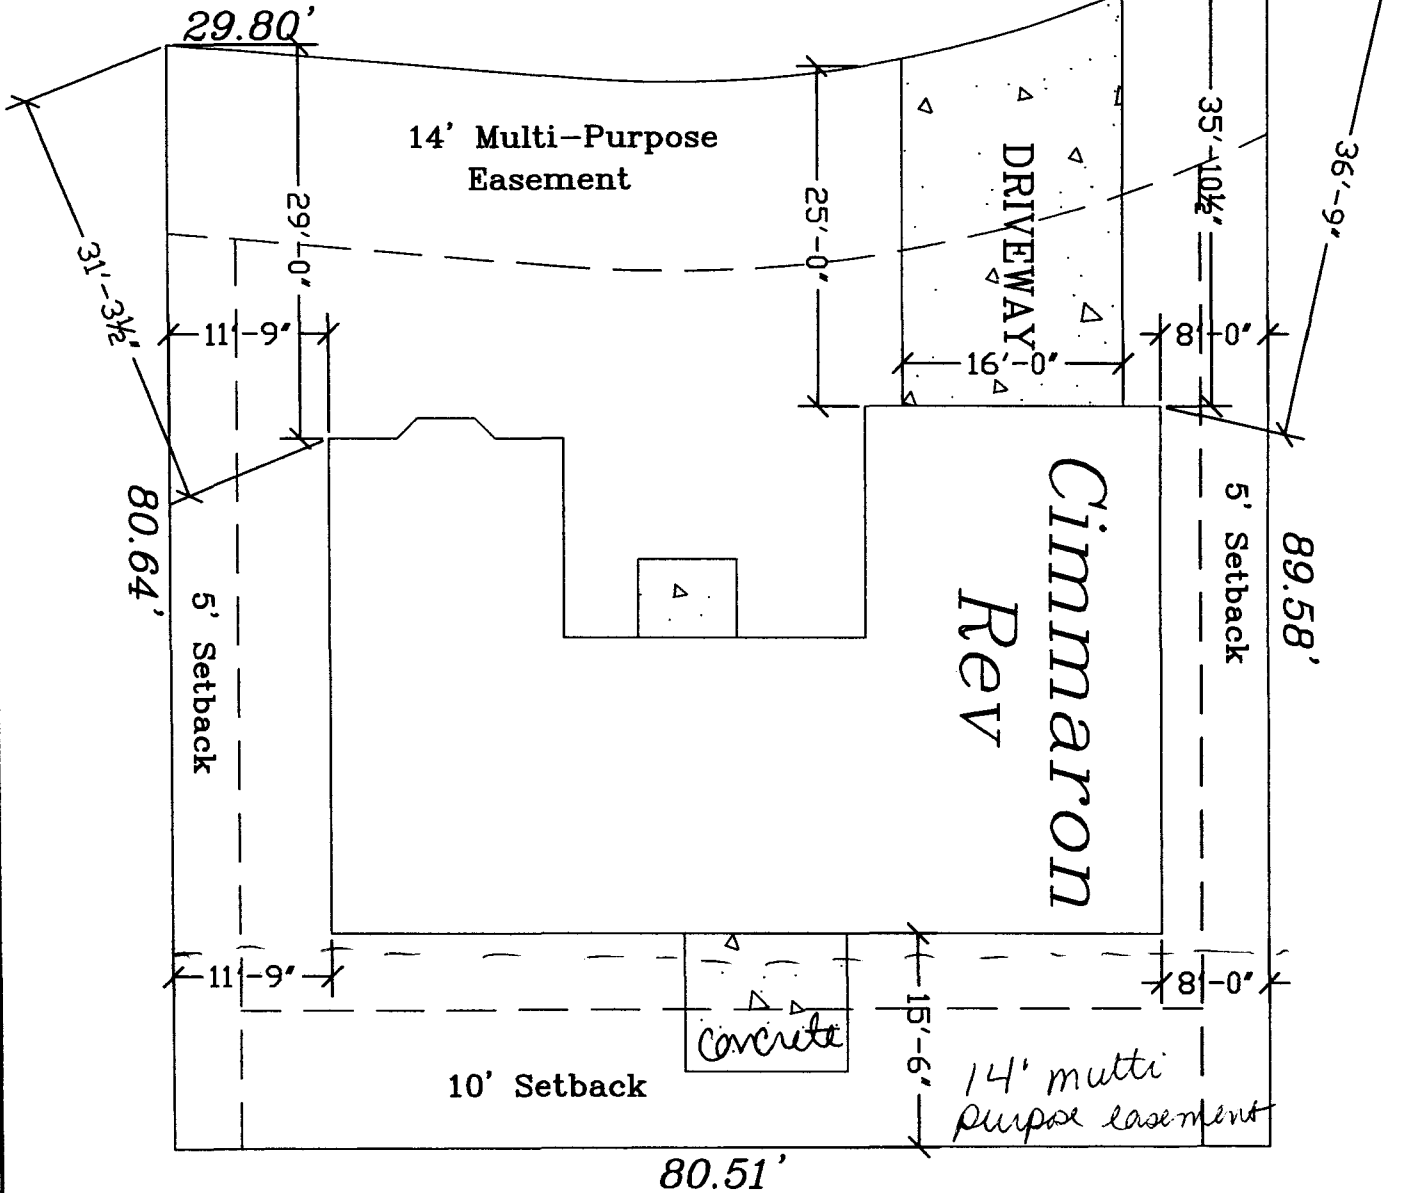

*drive
 etc
 in
 8/17/05*