

FEE \$	10.00
TCP \$	0
SIF \$	0

PLANNING CLEARANCE
 (Single Family Residential and Accessory Structures)
Community Development Department

BLDG PERMIT NO. _____

Building Address 441 MARIANNE DR
 Parcel No. 2943-174-14-005
 Subdivision WESTLAND ESTATES
 Filing _____ Block 1 Lot 5

No. of Existing Bldgs 1 No. Proposed 1
 Sq. Ft. of Existing Bldgs _____ Sq. Ft. Proposed _____
 Sq. Ft. of Lot / Parcel _____
 Sq. Ft. Coverage of Lot by Structures & Impervious Surface
 (Total Existing & Proposed) _____
 Height of Proposed Structure _____

OWNER INFORMATION:

Name DONALD R WHITE
 Address 441 MARIANNE DR
 City / State / Zip CO 81504

DESCRIPTION OF WORK & INTENDED USE:

- New Single Family Home (*check type below)
 Interior Remodel Addition
 Other (please specify): STORAGE SHED 8'x13'

APPLICANT INFORMATION:

Name _____
 Address _____
 City / State / Zip _____
 Telephone _____

***TYPE OF HOME PROPOSED:**

- Site Built Manufactured Home (UBC)
 Manufactured Home (HUD)
 Other (please specify): _____

NOTES: _____

REQUIRED: One plot plan, on 8 1/2" x 11" paper, showing all existing & proposed structure location(s), parking, setbacks to all property lines, ingress/egress to the property, driveway location & width & all easements & rights-of-way which abut the parcel.

THIS SECTION TO BE COMPLETED BY COMMUNITY DEVELOPMENT DEPARTMENT STAFF

ZONE <u>RSF-4</u>	Maximum coverage of lot by structures <u>50%</u>
SETBACKS: Front <u>20'/25'</u> from property line (PL)	Permanent Foundation Required: YES <input checked="" type="checkbox"/> NO <input type="checkbox"/>
Side <u>7'/3'</u> from PL Rear <u>25'/5'</u> from PL	Parking Requirement <u>2</u>
Maximum Height of Structure(s) <u>35'</u>	Special Conditions _____
Voting District _____	Driveway Location Approval _____ (Engineer's Initials)

Modifications to this Planning Clearance must be approved, in writing, by the Community Development Department. The structure authorized by this application cannot be occupied until a final inspection has been completed and a Certificate of Occupancy has been issued, if applicable, by the Building Department (Section 305, Uniform Building Code).

I hereby acknowledge that I have read this application and the information is correct; I agree to comply with any and all codes, ordinances, laws, regulations or restrictions which apply to the project. I understand that failure to comply shall result in legal action, which may include but not necessarily be limited to non-use of the building(s).

Applicant Signature Donald R White Date 3/14/05
 Department Approval Gayleen Henderson Date 3-14-05

Additional water and/or sewer tap fee(s) are required:	YES	NO <input checked="" type="checkbox"/>	W/O No. _____
Utility Accounting <u>D. Oenholz</u>	Date <u>3/14/05</u>		

VALID FOR SIX MONTHS FROM DATE OF ISSUANCE (Section 2.2.C.1 Grand Junction Zoning & Development Code)
 (White: Planning) (Yellow: Customer) (Pink: Building Department) (Goldenrod: Utility Accounting)

IMPROVEMENT LOCATION CERTIFICATE

441 MARIANN DRIVE


RSF-4



FIRST AMERICAN TITLE #155926
WHITE ACCOUNT
LOT 5 IN BLOCK 1 OF WESTLAND ESTATES - FILING ONE,
MESA COUNTY, COLORADO.

3-14-05
ACCEPTED *Gaylen Henderson*
ANY CHANGE OF SETBACKS MUST BE
APPROVED BY THE CITY PLANNING
DEPT. BY THE APPLICANT'S
RESPONSIBILITY TO PROPERLY
LOCATE AND IDENTIFY EASEMENTS
AND PROPERTY LINES.

SCALE: 1" = 30'

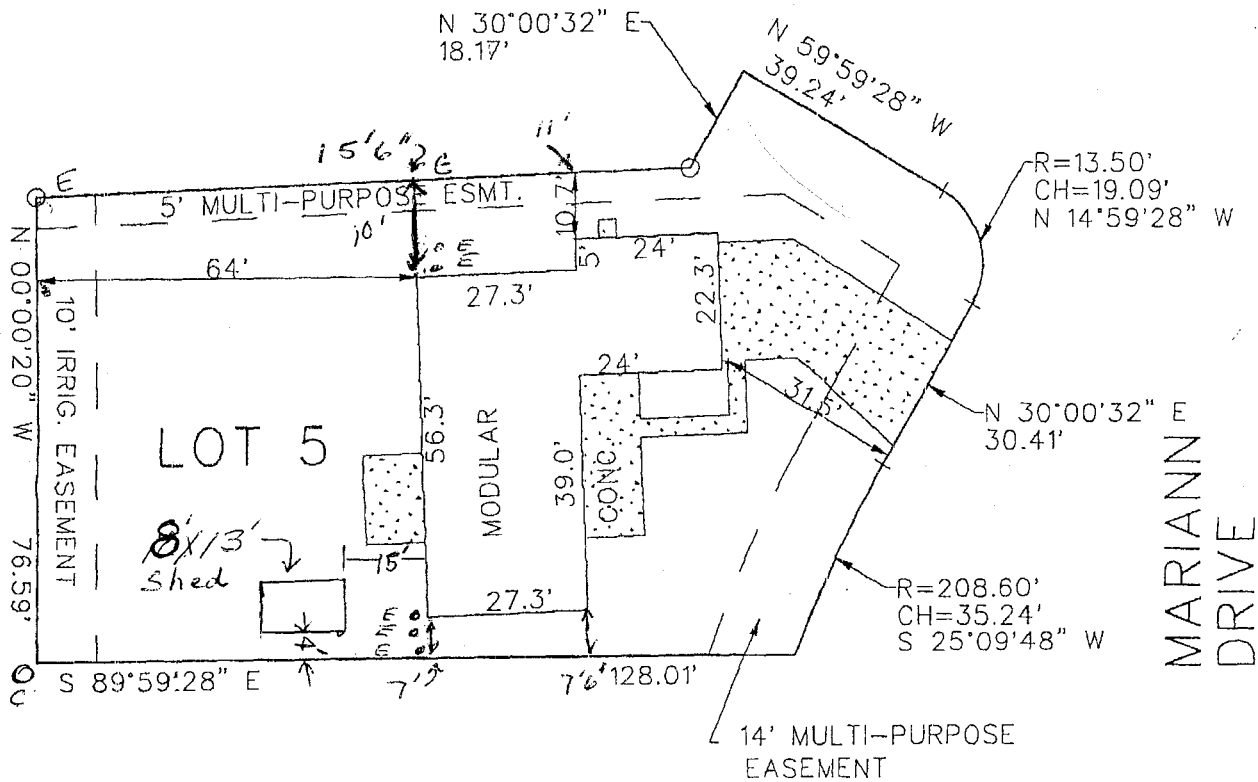

I HEREBY CERTIFY THAT THIS IMPROVEMENT LOCATION CERTIFICATE WAS PREPARED FOR FIDELITY MORTGAGE, THAT IT IS NOT A LAND SURVEY PLAT OR IMPROVEMENT SURVEY PLAT, AND THAT IT IS NOT TO BE RELIED UPON FOR THE ESTABLISHMENT OF FENCE, BUILDING OR OTHER FUTURE IMPROVEMENT LINES. I FURTHER CERTIFY THE IMPROVEMENTS ON THE ABOVE DESCRIBED PARCEL ON THIS DATE, 12/9/03 EXCEPT UTILITY CONNECTIONS, ARE ENTIRELY WITHIN THE BOUNDARIES OF THE PARCEL, EXCEPT AS SHOWN, THAT THERE ARE NO ENCROACHMENTS UPON THE DESCRIBED PREMISES BY IMPROVEMENTS ON ANY ADJOINING PREMISES, EXCEPT AS INDICATED, AND THAT THERE IS NO EVIDENCE OR SIGN OF ANY EASEMENT CROSSING OR BURDENING ANY PART OF SAID PARCEL, EXCEPT AS