
FEE \$ 10.00 PLANNING CLEA	BANCE BLDG PERMIT NO.
TCP \$ 0 (Single Family Residential and Ac	
SIF \$ 292.00 Community Development Department	
Building Address 2517 Madison ane	No. of Existing Bldgs No. Proposed
Parcel No. 2945-032-00-114	Sq. Ft. of Existing Bldgs Sq. Ft. Proposed <u>2403</u>
Subdivision <u>Colonial Heights</u>	Sq. Ft. of Lot / Parcel <u>6743</u>
Filing Block 5 Lot 8	Sq. Ft. Coverage of Lot by Structures & Impervious Surface (Total Existing & Proposed)
OWNER INFORMATION:	Height of Proposed Structure $20 f_{\pm}$
Name Alen Manley	DESCRIPTION OF WORK & INTENDED USE:
Address <u>723 Jasper Ar</u>	New Single Family Home (*check type below) Interior Remodel Other (please specify):
City/State/Zip Fruita; CO 81521	
APPLICANT INFORMATION:	*TYPE OF HOME PROPOSED:
Name RED Quality Builders, Lic	Manufactured Home (HUD)
Address <u>880 20 Rd.</u>	Other (please specify):
City/State/Zip Fruita, CO 81521	NOTES:
Telephone 234-0717 858-0717	
REQUIRED: One plot plan, on 8 1/2" x 11" paper, showing all existing & proposed structure location(s), parking, setbacks to all property lines, ingress/egress to the property, driveway location & width & all easements & rights-of-way which abut the parcel.	
THIS SECTION TO BE COMPLETED BY COMM	IUNITY DEVELOPMENT DEPARTMENT STAFF
ZONE <u>RMF-5</u>	Maximum coverage of lot by structures $(\mathcal{D} \mathcal{D} \mathcal{D})_{\mathcal{D}}$
SETBACKS: Front_20 from property line (PL)	Permanent Foundation Required: YESNO
Sidefrom PL Rear 25from PL	Parking Requirement
Maximum Height of Structure(s) 3 5	Special Conditions of pricipic excavation
Voting District Driveway Location Approval(Engineer's Initials)	Observation riquired by
Modifications to this Planning Clearance must be approved, in writing, by the Community Development Department. The structure authorized by this application cannot be occupied until a final inspection has been completed and a Certificate of Occupancy has been issued, if applicable, by the Building Department (Section 305, Uniform Building Code).	
I hereby acknowledge that I have read this application and the information is correct; I agree to comply with any and all codes, ordinances, laws, regulations or restrictions which apply to the project. I understand that failure to comply shall result in legal action, which may include but not necessarily be limited to non-use of the building(s).	
Applicant Signature	Date 7-7-05
Department Approval III / Ishe Magne	Date 7/13/05
Additional water and/or sewer tap fee(s) are required:	NO W/O No. 18-24-3
Utility Accounting	Date 7/13/05
VALID FOR SIX MONTHS FROM DATE OF ISSUANCE (Sec	tion 2.2.C.1 Grand Junction Zoning & Development Code)

(Yellow:	Customer)
----------	-----------

(White: Planning)

(Goldenrod: Utility Accounting)

⁽Pink: Building Department)

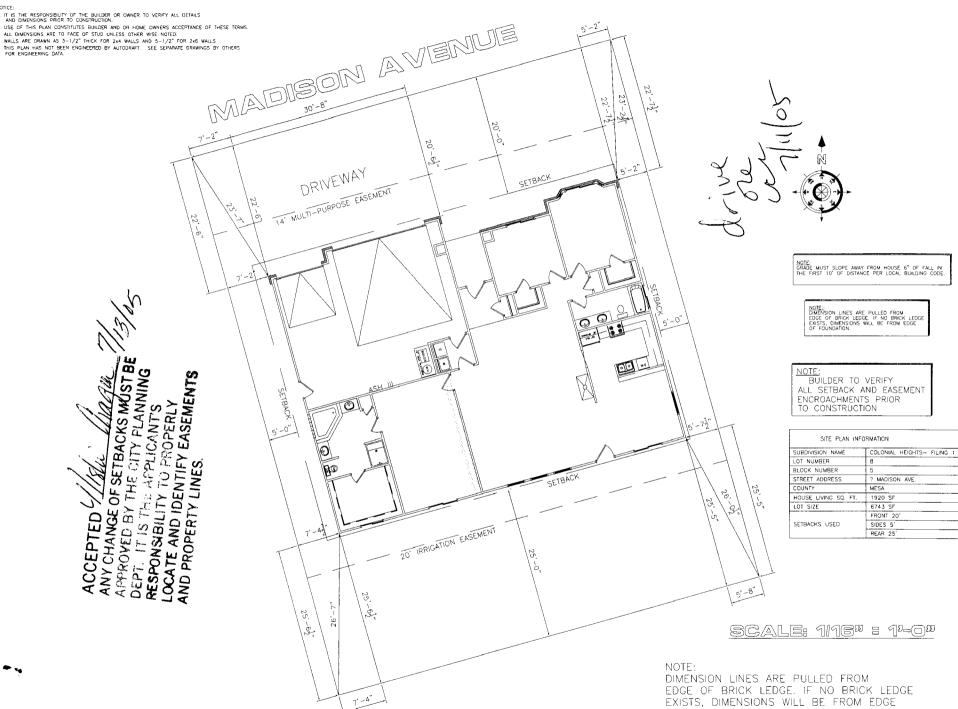

OTICE

OF FOUNDATION.