

FEE \$	10.00
TCP \$	1500.00
SIF \$	292.00

PLANNING CLEARANCE
 (Single Family Residential and Accessory Structures)
Community Development Department

BLDG PERMIT NO. _____

Building Address 711 Metate Ct EW 81505 No. of Existing Bldgs 0 No. Proposed 1
 Parcel No. 2701-333-41-008 Sq. Ft. of Existing Bldgs 0 Sq. Ft. Proposed 1978
 Subdivision Spanish Trail Sq. Ft. of Lot / Parcel 5401
 Filing 4 Block 11 Lot 8 Sq. Ft. Coverage of Lot by Structures & Impervious Surface (Total Existing & Proposed) 2378
 Height of Proposed Structure 19'

OWNER INFORMATION:

Name Hunter Const and Development
 Address PO Box 55063
 City / State / Zip Grand Junction CO 81505

DESCRIPTION OF WORK & INTENDED USE:

New Single Family Home (*check type below)
 Interior Remodel Addition
 Other (please specify): _____

APPLICANT INFORMATION:

Name Hunter Const + Development
 Address PO Box 55063
 City / State / Zip Grand Junction CO 81505
 Telephone 970.241.5059

***TYPE OF HOME PROPOSED:**

Site Built Manufactured Home (UBC)
 Manufactured Home (HUD)
 Other (please specify): _____

NOTES: _____

REQUIRED: One plot plan, on 8 1/2" x 11" paper, showing all existing & proposed structure location(s), parking, setbacks to all property lines, ingress/egress to the property, driveway location & width & all easements & rights-of-way which abut the parcel.

THIS SECTION TO BE COMPLETED BY COMMUNITY DEVELOPMENT DEPARTMENT STAFF	
ZONE <u>PD</u>	Maximum coverage of lot by structures <u>60%</u>
SETBACKS: Front <u>15' House 20' Garage</u> from property line (PL)	Permanent Foundation Required: YES <u>X</u> NO _____
Side <u>5'</u> from PL Rear <u>10'</u> from PL	Parking Requirement <u>2</u>
Maximum Height of Structure(s) <u>32'</u>	Special Conditions <u>Approval Letter from Lic Eng required</u>
Voting District <u>B</u> Driveway Location Approval <u>CU</u> (Engineer's Initials)	


Modifications to this Planning Clearance must be approved, in writing, by the Community Development Department. The structure authorized by this application cannot be occupied until a final inspection has been completed and a Certificate of Occupancy has been issued, if applicable, by the Building Department (Section 305, Uniform Building Code).

I hereby acknowledge that I have read this application and the information is correct; I agree to comply with any and all codes, ordinances, laws, regulations or restrictions which apply to the project. I understand that failure to comply shall result in legal action, which may include but not necessarily be limited to non-use of the building(s).

Applicant Signature [Signature] Date 8/31/05
 Department Approval NAC Jay Hall Date 9/12/05

Additional water and/or sewer tap fee(s) are required:	YES <u>X</u> NO _____	W/O No. <u>18389</u>
Utility Accounting <u>[Signature]</u>	Date <u>9/12/05</u>	

VALID FOR SIX MONTHS FROM DATE OF ISSUANCE (Section 2.2.C.1 Grand Junction Zoning & Development Code)
 (White: Planning) (Yellow: Customer) (Pink: Building Department) (Goldenrod: Utility Accounting)

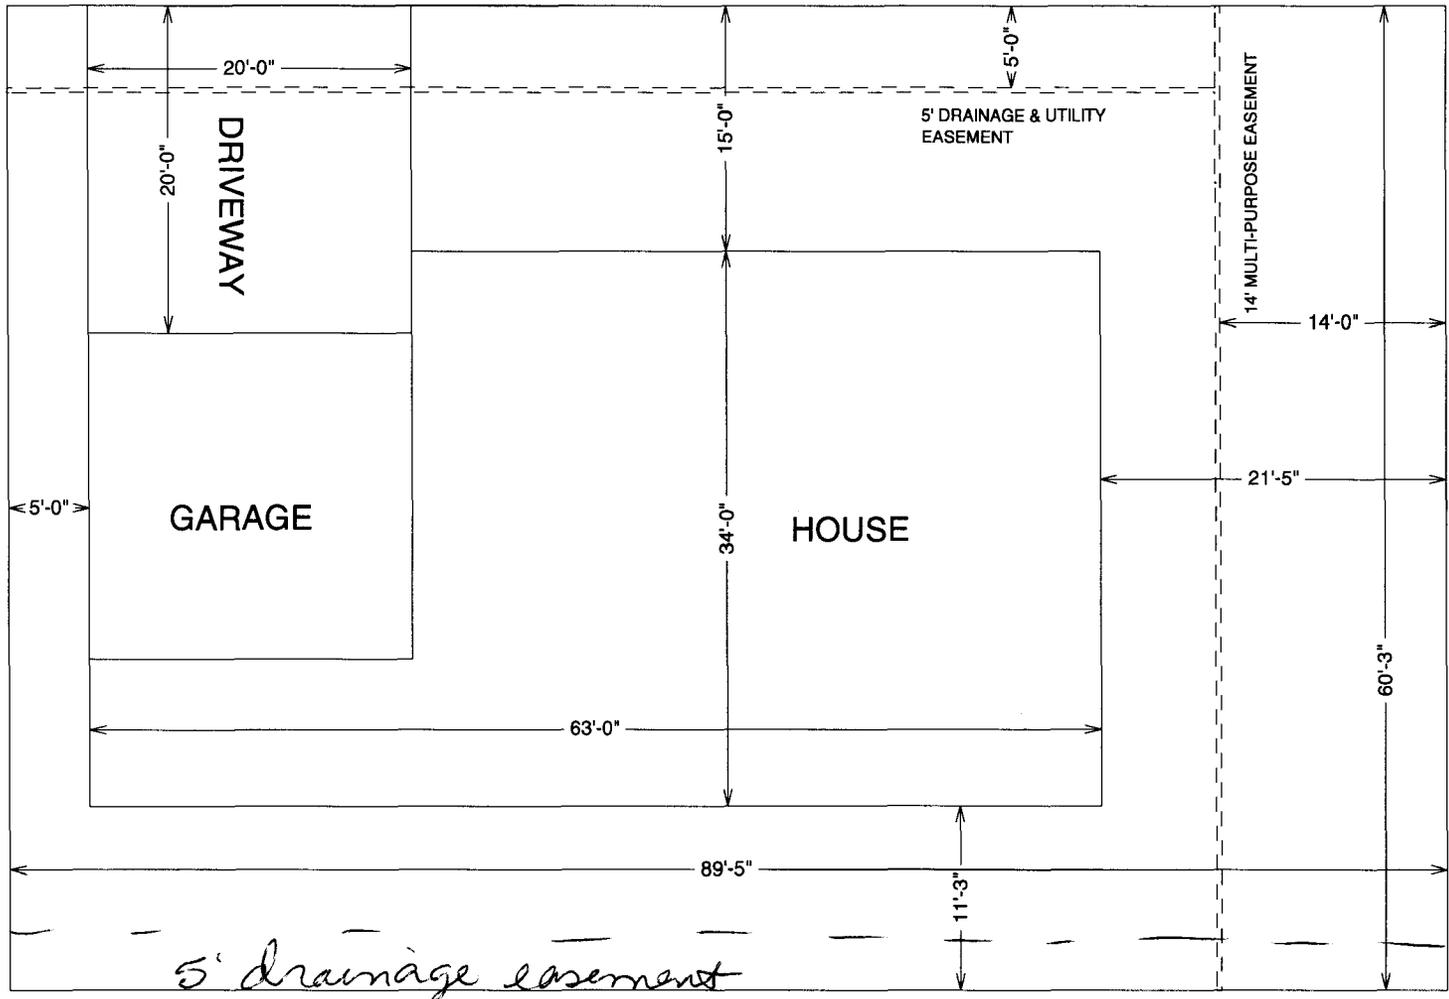

9/12/05
 ACCEPTED C. Hay Hall
 ANY CHANGE OF SETBACKS MUST BE APPROVED BY THE CITY PLANNING DEPT. IT IS THE APPLICANT'S RESPONSIBILITY TO PROPERLY LOCATE AND IDENTIFY EASEMENTS AND PROPERTY LINES.



BLOCK 11
 LOT 8
 711 METATE COURT
 SPANISH TRAILS SUB.

"The El Monte"

drive ok ll
 9/1/05