

FEE \$	10.00
TCP \$	NONE
SIF \$	292.00

PLANNING CLEARANCE
 (Single Family Residential and Accessory Structures)
Community Development Department

BLDG PERMIT NO. _____

Building Address 692 Miranda
 Parcel No. 2945-032-99-036
 Subdivision Colonia Heights
 Filing 3 Block 1 Lot 36

No. of Existing Bldgs _____ No. Proposed 1
 Sq. Ft. of Existing Bldgs _____ Sq. Ft. Proposed 1883
 Sq. Ft. of Lot / Parcel _____
 Sq. Ft. Coverage of Lot by Structures & Impervious Surface (Total Existing & Proposed) _____
 Height of Proposed Structure _____

OWNER INFORMATION:

Name Sonshine II Construction
 Address 2350 G Road
 City / State / Zip Grand Jct, CO 81505

DESCRIPTION OF WORK & INTENDED USE:

New Single Family Home (*check type below)
 Interior Remodel Addition
 Other (please specify): _____

APPLICANT INFORMATION:

Name Sonshine II Construction
 Address 2350 G Road
 City / State / Zip Grand Jct, CO 81505
 Telephone 970-255-8853

***TYPE OF HOME PROPOSED:**

Site Built Manufactured Home (UBC)
 Manufactured Home (HUD)
 Other (please specify): _____

NOTES: _____

REQUIRED: One plot plan, on 8 1/2" x 11" paper, showing all existing & proposed structure location(s), parking, setbacks to all property lines, ingress/egress to the property, driveway location & width & all easements & rights-of-way which abut the parcel.

THIS SECTION TO BE COMPLETED BY COMMUNITY DEVELOPMENT DEPARTMENT STAFF	
ZONE <u>RMF-5</u>	Maximum coverage of lot by structures <u>60%</u>
SETBACKS: Front <u>20'</u> from property line (PL)	Permanent Foundation Required: YES <u>X</u> NO _____
Side <u>5'</u> from PL Rear <u>25'</u> from PL	Parking Requirement <u>2</u>
Maximum Height of Structure(s) <u>35'</u>	Special Conditions <u>Letter from Lic</u>
Voting District <u>B</u> Driveway Location Approval <u>ML</u> <u>engineer required</u> <small>(Engineer's Initials)</small>	

Modifications to this Planning Clearance must be approved, in writing, by the Community Development Department. The structure authorized by this application cannot be occupied until a final inspection has been completed and a Certificate of Occupancy has been issued, if applicable, by the Building Department (Section 305, Uniform Building Code).

I hereby acknowledge that I have read this application and the information is correct; I agree to comply with any and all codes, ordinances, laws, regulations or restrictions which apply to the project. I understand that failure to comply shall result in legal action, which may include but not necessarily be limited to non-use of the building(s).

Applicant Signature [Signature] Date 4/8/05
 Department Approval NAC Fair Hall Date 6/3/05

Additional water and/or sewer tap fee(s) are required:	YES <input checked="" type="checkbox"/>	NO <input type="checkbox"/>	W/O No. <u>18133</u>
--	---	-----------------------------	----------------------

Utility Accounting <u>[Signature]</u>	Date <u>6/3/05</u>
---------------------------------------	--------------------

VALID FOR SIX MONTHS FROM DATE OF ISSUANCE (Section 2.2.C.1 Grand Junction Zoning & Development Code)
 (White: Planning) (Yellow: Customer) (Pink: Building Department) (Goldenrod: Utility Accounting)

6/3/05
C. Faye Hall

ACCEPTED
 ANY CHANGE OF SETBACKS MUST BE APPROVED BY THE CITY PLANNING DEPT. IT IS THE APPLICANT'S RESPONSIBILITY TO PROPERLY LOCATE AND IDENTIFY EASEMENTS AND PROPERTY LINES.



NOTE:
 DIMENSION LINES ARE PULLED FROM EDGE OF BRICK LEDGE. IF NO BRICK LEDGE EXISTS, DIMENSIONS WILL BE FROM EDGE OF FOUNDATION.

NOTE:
 BUILDER TO VERIFY ALL SETBACK AND EASEMENT ENCROACHMENTS PRIOR TO CONSTRUCTION

SITE PLAN INFORMATION	
SUBDIVISION NAME	COLONIAL HEIGHTS- FILING 3
LOT NUMBER	36
BLOCK NUMBER	1
STREET ADDRESS	692 MIRANDA STREET
COUNTY	MESA
HOUSE SQ. FT.	1883 SF
LOT SIZE	7447 SF
SETBACKS USED	FRONT 20'
	SIDES 5'
	REAR 25'

MIRANDA STREET

drive ok
5/18/05

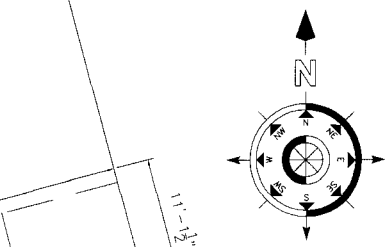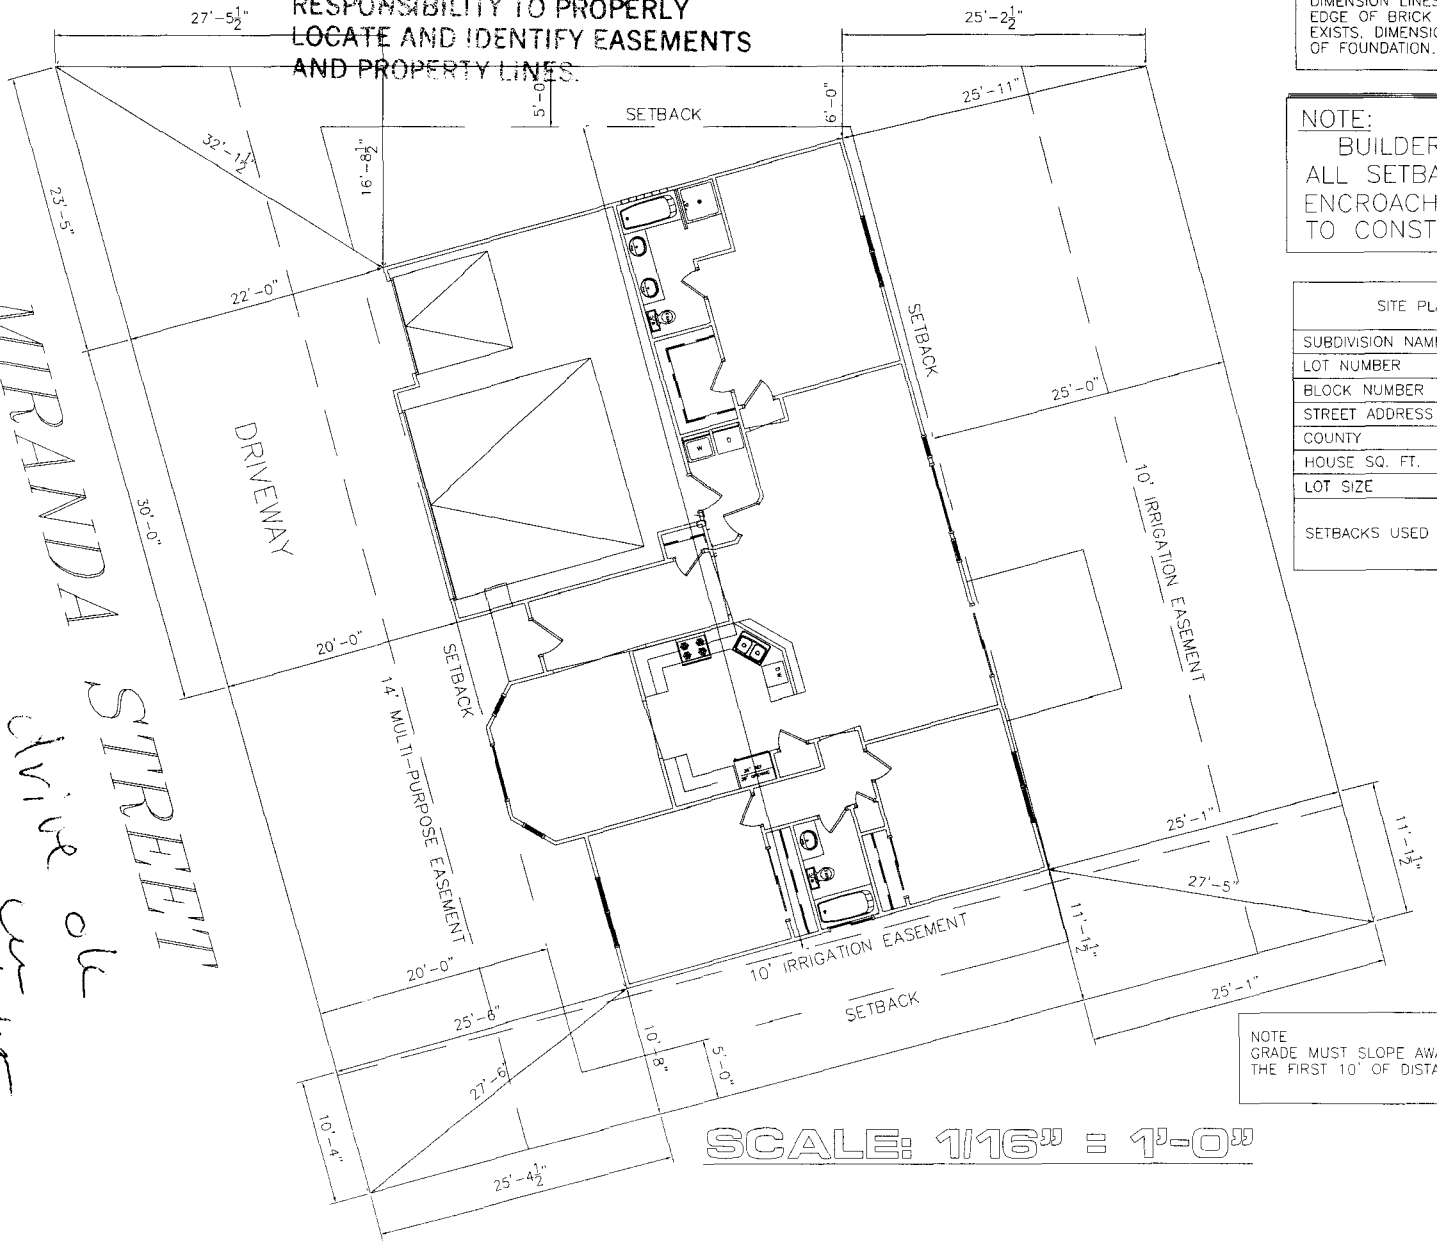

NOTE:
 GRADE MUST SLOPE AWAY FROM HOUSE 6" OF FALL IN THE FIRST 10' OF DISTANCE PER LOCAL BUILDING CODE.

SCALE: 1/16" = 1'-0"