

FEE \$	10.00
TCP \$	1000.00
SIF \$	292.00

PLANNING CLEARANCE
 (Single Family Residential and Accessory Structures)
Community Development Department

BLDG PERMIT NO. _____

Building Address 2869 Presley Ave
 Parcel No. 2943-071-27-005
 Subdivision The Legends
 Filing 6 Block 1 Lot 5

No. of Existing Bldgs 0 No. Proposed 1
 Sq. Ft. of Existing Bldgs 42 Sq. Ft. Proposed 1611
 Sq. Ft. of Lot / Parcel 9585.50 SQ. FT
 Sq. Ft. Coverage of Lot by Structures & Impervious Surface
 (Total Existing & Proposed) 2711 SQ. FT
 Height of Proposed Structure 17'

OWNER INFORMATION:

Name Legend Partners
 Address P.O. Box 1765
 City / State / Zip GRAND JUNCTION, CO 81502

DESCRIPTION OF WORK & INTENDED USE:
 New Single Family Home (*check type below)
 Interior Remodel Addition
 Other (please specify): _____

APPLICANT INFORMATION:

Name Legend Partners
 Address P.O. Box 1765
 City / State / Zip GRAND JUNCTION, CO 81502
 Telephone 970-244-9986 #17

*TYPE OF HOME PROPOSED:
 Site Built Manufactured Home (UBC)
 Manufactured Home (HUD)
 Other (please specify): _____

NOTES: DEC 01 2005

REQUIRED: One plot plan, on 8 1/2" x 11" paper, showing all existing & proposed structure location(s), parking, setbacks to all property lines, ingress/egress to the property, driveway location & width & all easements & rights-of-way which abut the parcel.

THIS SECTION TO BE COMPLETED BY COMMUNITY DEVELOPMENT DEPARTMENT STAFF	
ZONE <u>PD</u>	Maximum coverage of lot by structures _____
SETBACKS: Front <u>15' House 20' Garage</u> from property line (PL)	Permanent Foundation Required: YES <u>X</u> NO _____
Side <u>5'</u> from PL Rear <u>10'</u> from PL	Parking Requirement <u>2</u>
Maximum Height of Structure(s) <u>32'</u>	Special Conditions <u>Lot Specific Geotechnical analysis & eng foundation required</u>
Voting District <u>D</u> Driveway Location Approval <u>me</u> (Engineer's Initials)	

Modifications to this Planning Clearance must be approved, in writing, by the Community Development Department. The structure authorized by this application cannot be occupied until a final inspection has been completed and a Certificate of Occupancy has been issued, if applicable, by the Building Department (Section 305, Uniform Building Code).


I hereby acknowledge that I have read this application and the information is correct; I agree to comply with any and all codes, ordinances, laws, regulations or restrictions which apply to the project. I understand that failure to comply shall result in legal action, which may include but not necessarily be limited to non-use of the building(s).

Applicant Signature [Signature] Date 11-28-05
 Department Approval NA Daylen Henderson Date 12-1-05


Additional water and/or sewer tap fee(s) are required: YES <input checked="" type="checkbox"/> NO <input type="checkbox"/>	W/O No. <u>19605</u>
Utility Accounting <u>C. Bensley</u>	Date <u>12/1/05</u>

VALID FOR SIX MONTHS FROM DATE OF ISSUANCE (Section 2.2.C.1 Grand Junction Zoning & Development Code)
 (White: Planning) (Yellow: Customer) (Pink: Building Department) (Goldenrod: Utility Accounting)

PRESLEY Ave

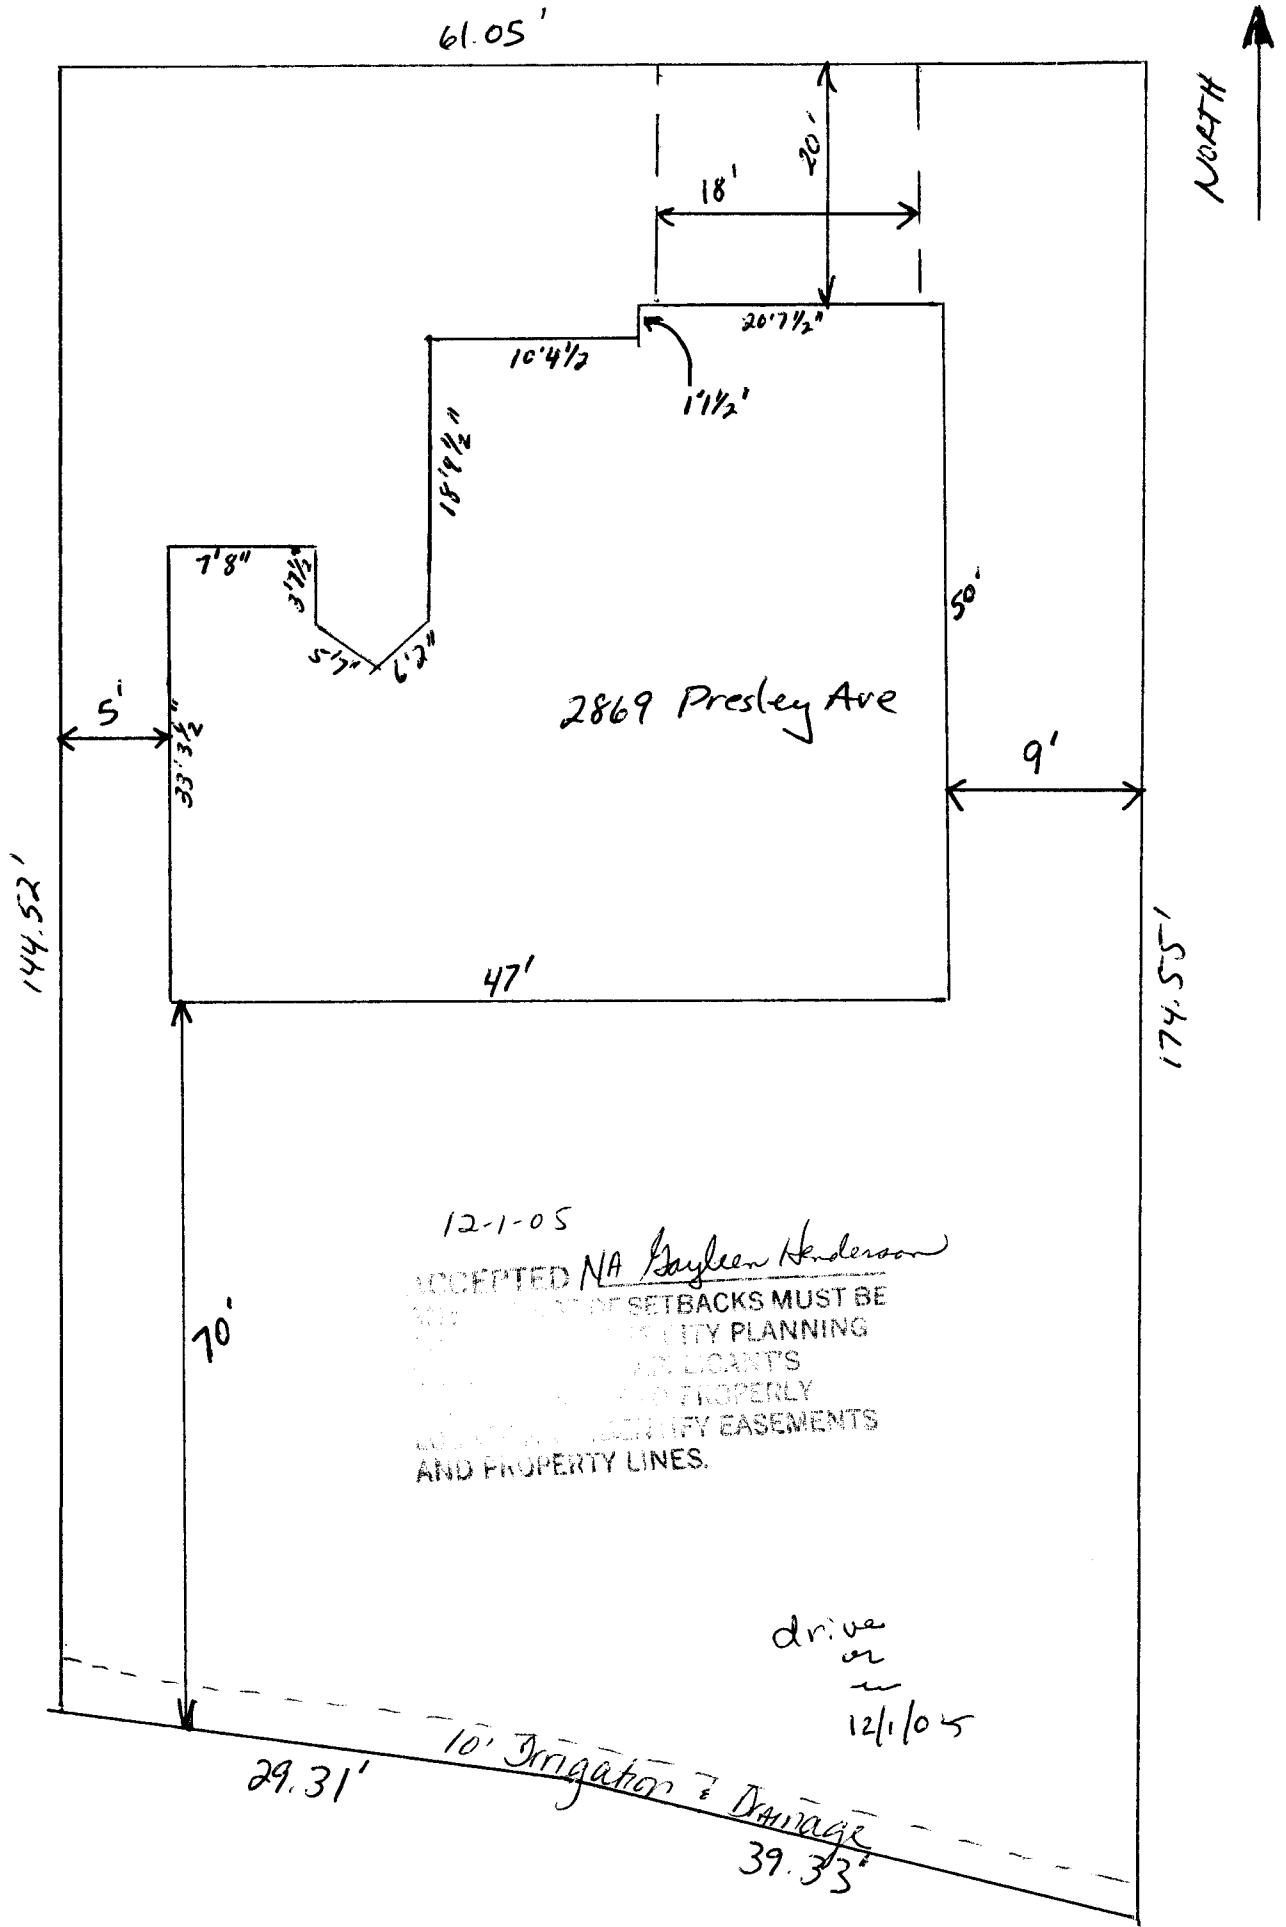

61.05'

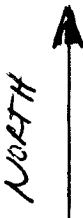

2869 Presley Ave

12-1-05

ACCEPTED NA *Gayleen Henderson*
ALL SETBACKS MUST BE
IN ACCORDANCE WITH CITY PLANNING
DEPARTMENT'S REGULATIONS AND PROPERLY
IDENTIFY EASEMENTS
AND PROPERTY LINES.

drive
or
12/1/05

29.31'

10' Irrigation & Drainage

39.33'