

FEE \$	10.00
TCP \$	1000.00
SIF \$	292.00

PLANNING CLEARANCE
 (Single Family Residential and Accessory Structures)
Community Development Department

BLDG PERMIT NO. _____

Building Address 2877 Presley Ave
 Parcel No. 2943-071-27-014
 Subdivision The Legends
 Filing 6 Block 1 Lot 14

No. of Existing Bldgs 0 No. Proposed 1
 Sq. Ft. of Existing Bldgs 0 Sq. Ft. Proposed 1572
 Sq. Ft. of Lot / Parcel 5991.8 SQ. FT.
 Sq. Ft. Coverage of Lot by Structures & Impervious Surface
 (Total Existing & Proposed) 2582
 Height of Proposed Structure 17'

OWNER INFORMATION:

Name Legendo Portnes
 Address P.O. Box 1765
 City / State / Zip GRAND JUNCTION, CO 81502

DESCRIPTION OF WORK & INTENDED USE:
 New Single Family Home (*check type below)
 Interior Remodel Addition
 Other (please specify): _____

APPLICANT INFORMATION:

Name Legendo Portnes
 Address P.O. Box 1765
 City / State / Zip GRAND JUNCTION, CO 81502
 Telephone 970-244-9986 #17

*TYPE OF HOME PROPOSED:
 Site Built Manufactured Home (UBC)
 Manufactured Home (HUD)
 Other (please specify): _____

NOTES: _____

REQUIRED: One plot plan, on 8 1/2" x 11" paper, showing all existing & proposed structure location(s), parking, setbacks to all property lines, ingress/egress to the property, driveway location & width & all easements & rights-of-way which abut the parcel.

THIS SECTION TO BE COMPLETED BY COMMUNITY DEVELOPMENT DEPARTMENT STAFF	
ZONE <u>PO</u>	Maximum coverage of lot by structures _____
SETBACKS: Front <u>15' House</u> <u>20' Carport</u> from property line (PL)	Permanent Foundation Required: YES <u>X</u> NO _____
Side <u>5'</u> from PL Rear <u>10'</u> from PL	Parking Requirement <u>2</u>
Maximum Height of Structure(s) <u>32'</u>	Special Conditions <u>Lot specific geotech analysis & eng foundation required</u>
Voting District <u>D</u> Driveway Location Approval _____ (Engineer's Initials)	


Modifications to this Planning Clearance must be approved, in writing, by the Community Development Department. The structure authorized by this application cannot be occupied until a final inspection has been completed and a Certificate of Occupancy has been issued, if applicable, by the Building Department (Section 305, Uniform Building Code).

I hereby acknowledge that I have read this application and the information is correct; I agree to comply with any and all codes, ordinances, laws, regulations or restrictions which apply to the project. I understand that failure to comply shall result in legal action, which may include but not necessarily be limited to non-use of the building(s).

Applicant Signature [Signature] Date 8-30-05
 Department Approval [Signature] Date 9-8-05

Additional water (and/or sewer) tap fee(s) are required: <input checked="" type="checkbox"/> YES <input type="checkbox"/> NO	W/O No. <u>18386</u>
Utility Accounting <u>[Signature]</u>	Date <u>9/8/05</u>

Presley Ave

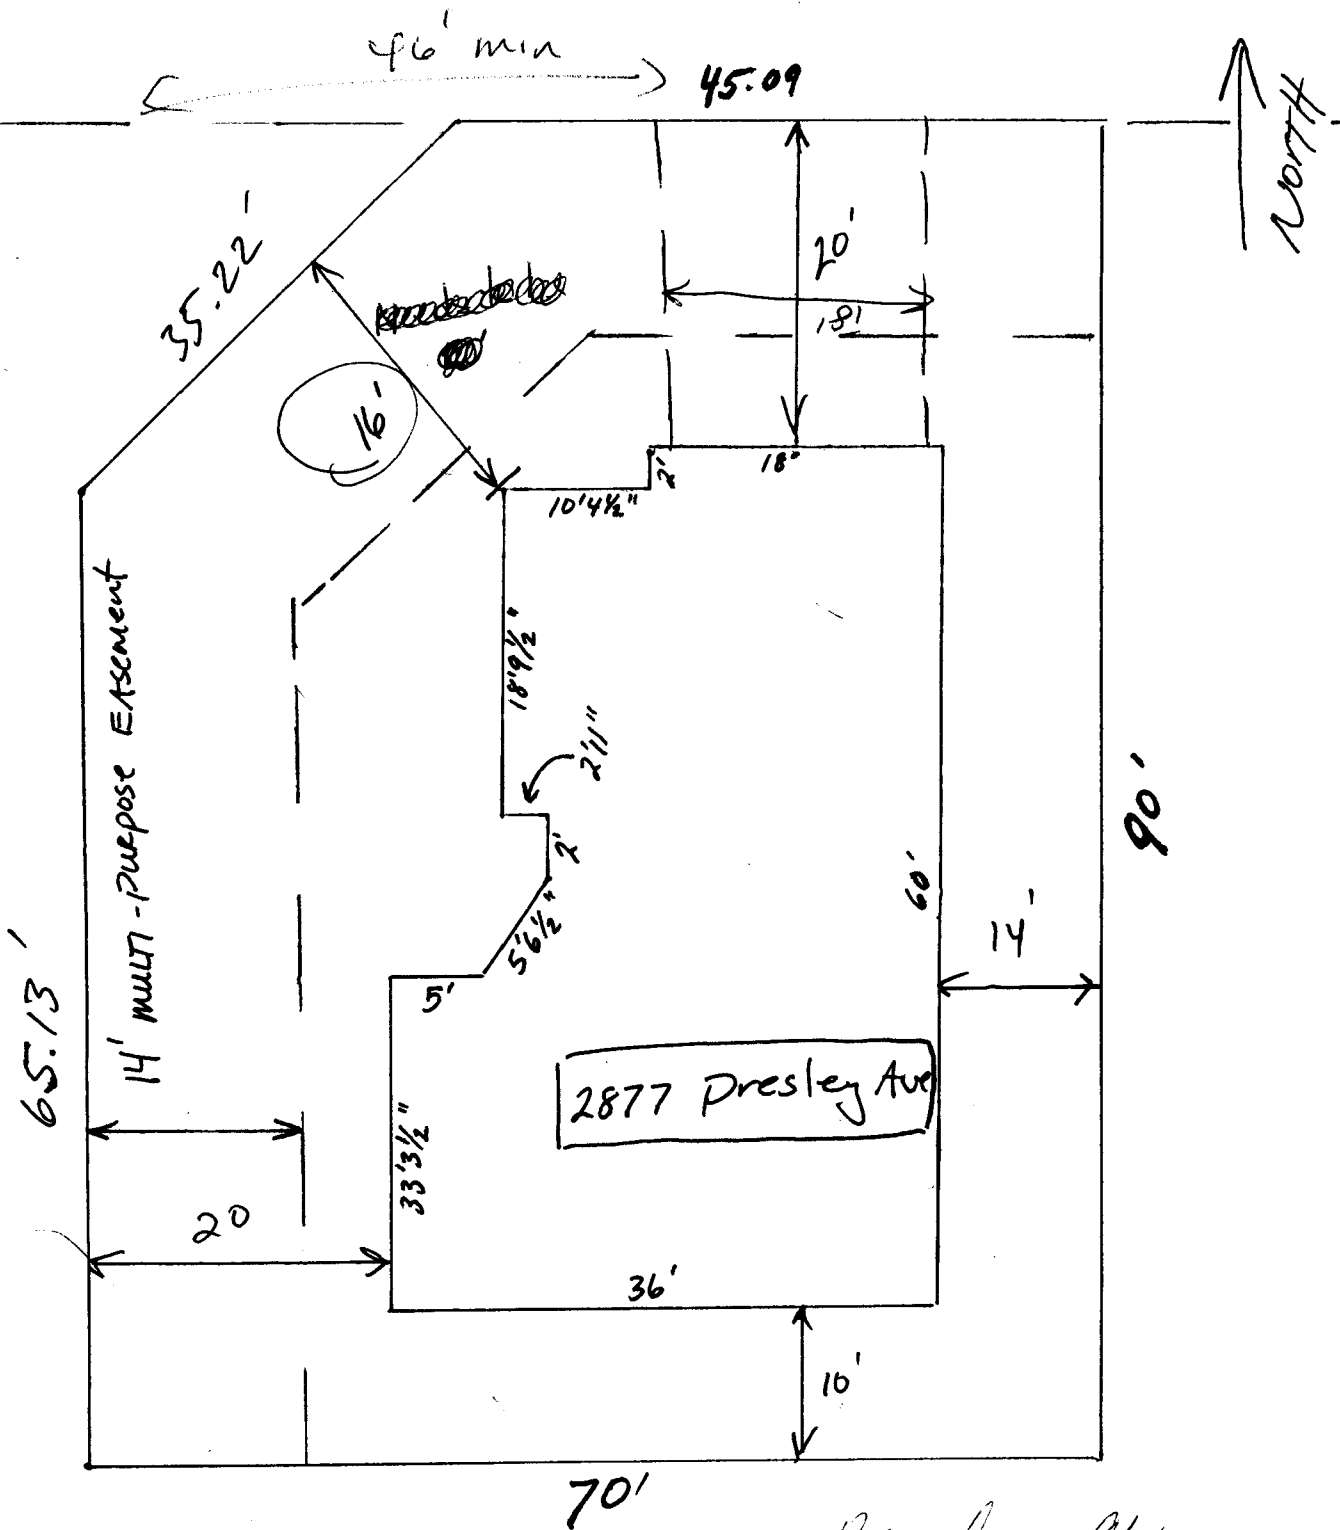

ACCEPTED *[Signature]* 9/8/05
ANY CHANGE OF SETBACKS MUST BE APPROVED BY THE CITY PLANNING DEPT. IT IS THE APPLICANT'S RESPONSIBILITY TO PROPERLY LOCATE AND IDENTIFY EASEMENTS AND PROPERTY LINES.