

FEE \$ 10.00.  
 TCP \$ 408.00  
 SIF \$ 292.00

**PLANNING CLEARANCE**  
 (Single Family Residential and Accessory Structures)  
Community Development Department

BLDG PERMIT NO. \_\_\_\_\_

Building Address 3018 Royal Ct  
 Parcel No. 2943-043-74-002  
 Subdivision Monarch Glen  
 Filing 2 Block 2 Lot 2

No. of Existing Bldgs 0 No. Proposed 1  
 Sq. Ft. of Existing Bldgs 0 Sq. Ft. Proposed 1832  
 Sq. Ft. of Lot / Parcel \_\_\_\_\_  
 Sq. Ft. Coverage of Lot by Structures & Impervious Surface  
 (Total Existing & Proposed) \_\_\_\_\_  
 Height of Proposed Structure \_\_\_\_\_

**OWNER INFORMATION:**

Name Shultz Custom Homes  
 Address 2024 Paint Pony Ct  
 City / State / Zip Grand Jet CO 81503

**DESCRIPTION OF WORK & INTENDED USE:**

New Single Family Home (\*check type below)  
 Interior Remodel  Addition  
 Other (please specify): \_\_\_\_\_

**APPLICANT INFORMATION:**

Name Shultz Custom Homes  
 Address 2024 Paint Pony Ct  
 City / State / Zip Grand Jet CO 81503  
 Telephone 260 8080

**\*TYPE OF HOME PROPOSED:**

Site Built  Manufactured Home (UBC)  
 Manufactured Home (HUD)  
 Other (please specify): \_\_\_\_\_

NOTES: \_\_\_\_\_

**REQUIRED: One plot plan, on 8 1/2" x 11" paper, showing all existing & proposed structure location(s), parking, setbacks to all property lines, ingress/egress to the property, driveway location & width & all easements & rights-of-way which abut the parcel.**

THIS SECTION TO BE COMPLETED BY COMMUNITY DEVELOPMENT DEPARTMENT STAFF	
ZONE <u>RSF-4</u>	Maximum coverage of lot by structures <u>50%</u>
SETBACKS: Front <u>20'</u> from property line (PL)	Permanent Foundation Required: YES <u>X</u> NO _____
Side <u>7'</u> from PL Rear <u>25'</u> from PL	Parking Requirement <u>2</u>
Maximum Height of Structure(s) <u>35'</u>	Special Conditions _____
Voting District <u>D</u> Driveway Location Approval <u>TRAD</u> (Engineer's Initials)	

Modifications to this Planning Clearance must be approved, in writing, by the Community Development Department. The structure authorized by this application cannot be occupied until a final inspection has been completed and a Certificate of Occupancy has been issued, if applicable, by the Building Department (Section 305, Uniform Building Code).

I hereby acknowledge that I have read this application and the information is correct; I agree to comply with any and all codes, ordinances, laws, regulations or restrictions which apply to the project. I understand that failure to comply shall result in legal action, which may include but not necessarily be limited to non-use of the building(s).


Applicant Signature [Signature] Date \_\_\_\_\_  
 Department Approval [Signature] Date 10/20/05

Additional water and/or sewer tap fee(s) are required: YES <u>X</u> NO _____	W/O No. <u>18503</u>
Utility Accounting <u>[Signature]</u>	Date <u>10/20/05</u>

VALID FOR SIX MONTHS FROM DATE OF ISSUANCE (Section 2.2.C.1 Grand Junction Zoning & Development Code)  
 (White: Planning) (Yellow: Customer) (Pink: Building Department) (Goldenrod: Utility Accounting)

3018 Royal Ct.  
Lot 2 Block 2 Filing 2 Monarch Glen

83.90'

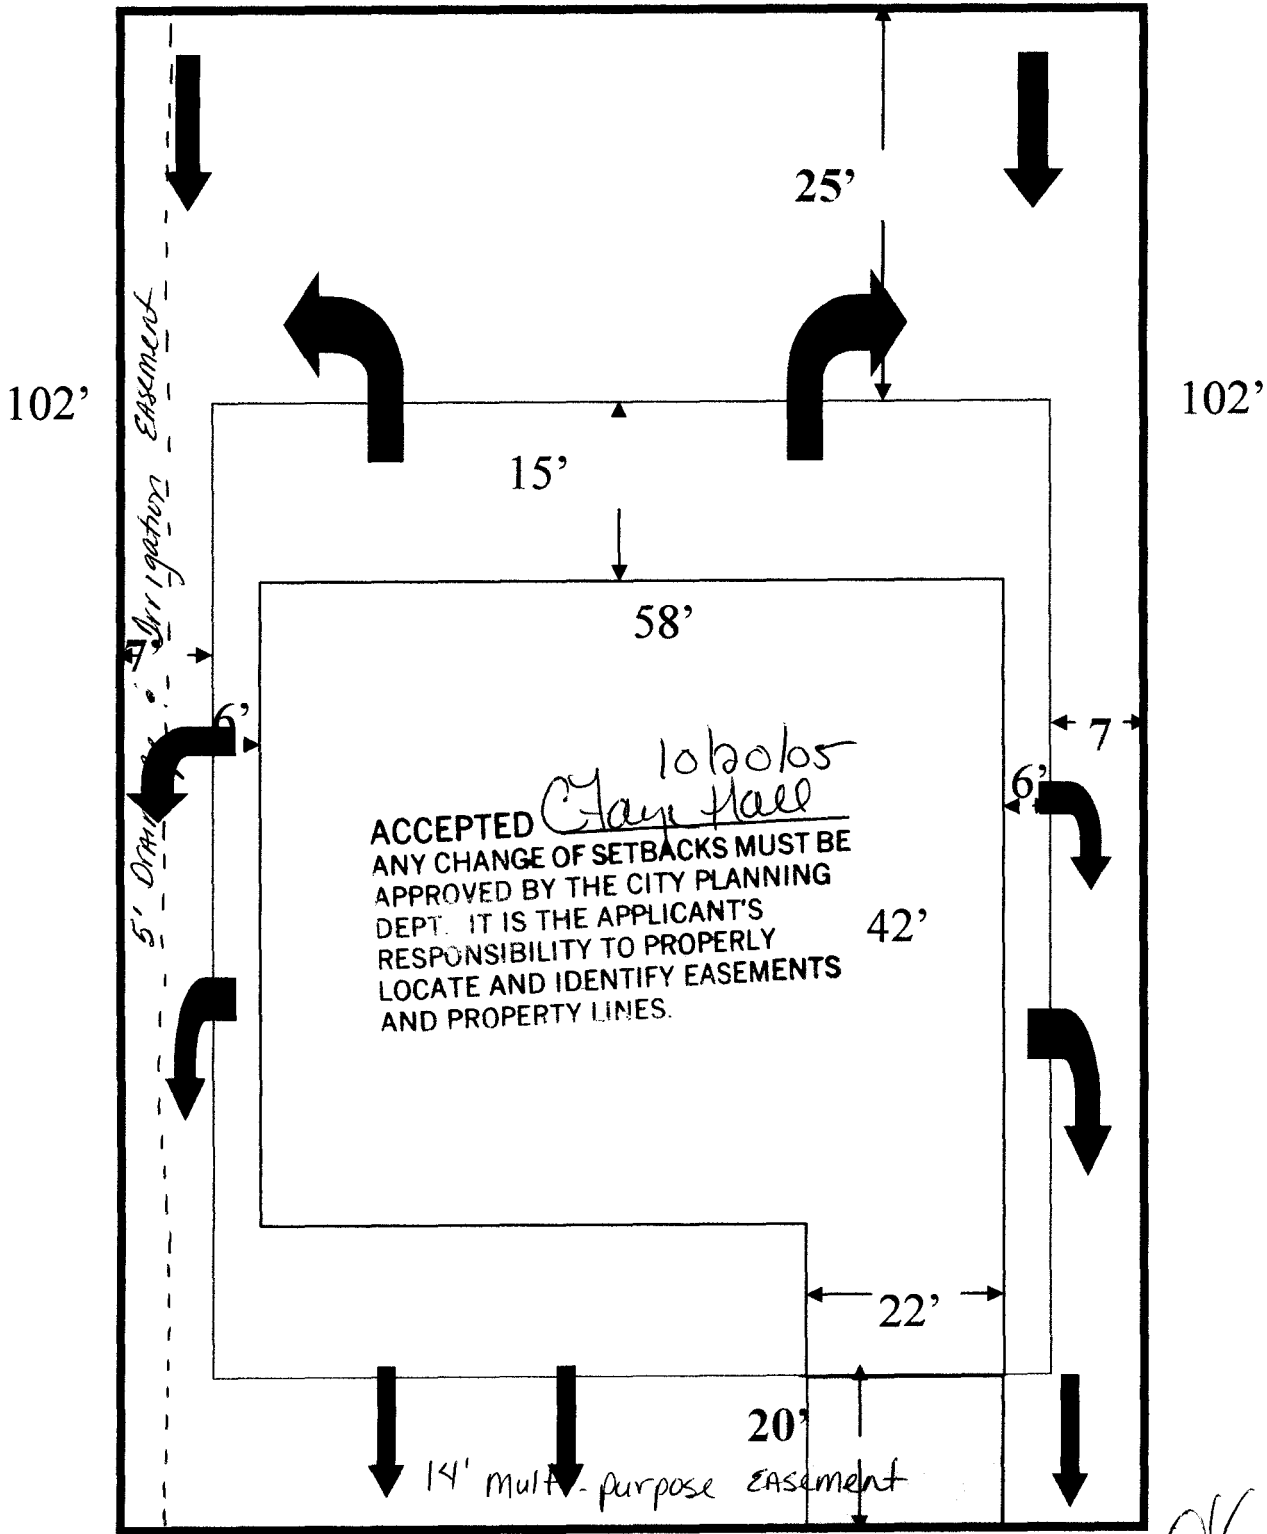

Royal Court

83.90'

Drainage  
Set Backs



*Drive OK  
Tuck Davis  
10-17-05*