

FEE \$	10.00
TCP \$	1500.00
SIF \$	292.00

**PLANNING CLEARANCE**  
 (Single Family Residential and Accessory Structures)  
**Community Development Department**

BLDG PERMIT NO. \_\_\_\_\_

Building Address 281 Snyder Creek Dr No. of Existing Bldgs 0 No. Proposed 1  
 Parent Parcel No. 2943-301-00-166 Sq. Ft. of Existing Bldgs 0 Sq. Ft. Proposed 2097  
 Subdivision Unaweeep Heights Sq. Ft. of Lot / Parcel 8691  
 Filing 4 Block 3 Lot 5 Sq. Ft. Coverage of Lot by Structures & Impervious Surface (Total Existing & Proposed) 3434  
 Height of Proposed Structure \_\_\_\_\_

**OWNER INFORMATION:**

Name Pinnacle Homes, Inc.  
 Address 3111 F Rd  
 City / State / Zip Grand Jct Co 81504

**DESCRIPTION OF WORK & INTENDED USE:**  
 New Single Family Home (\*check type below)  
 Interior Remodel  Addition  
 Other (please specify): \_\_\_\_\_

**APPLICANT INFORMATION:**

Name Pinnacle Homes, Inc.  
 Address 3111 F Rd  
 City / State / Zip Grand Jct Co 81504  
 Telephone (970) 241-6646

**\*TYPE OF HOME PROPOSED:**  
 Site Built  Manufactured Home (UBC)  
 Manufactured Home (HUD)  
 Other (please specify): \_\_\_\_\_

NOTES: \_\_\_\_\_

**REQUIRED: One plot plan, on 8 1/2" x 11" paper, showing all existing & proposed structure location(s), parking, setbacks to all property lines, ingress/egress to the property, driveway location & width & all easements & rights-of-way which abut the parcel.**

THIS SECTION TO BE COMPLETED BY COMMUNITY DEVELOPMENT DEPARTMENT STAFF			
ZONE <u>RSF-4</u>	Maximum coverage of lot by structures <u>50%</u>		
SETBACKS: Front <u>20'</u> from property line (PL)	Permanent Foundation Required: YES <input checked="" type="checkbox"/> NO <input type="checkbox"/>		
Side <u>7'</u> from PL Rear <u>25'</u> from PL	Parking Requirement <u>2</u>		
Maximum Height of Structure(s) <u>35'</u>	Special Conditions _____		
Voting District <u>E</u>	Driveway Location Approval <u>RAD</u> (Engineer's Initials)		

Modifications to this Planning Clearance must be approved, in writing, by the Community Development Department. The structure authorized by this application cannot be occupied until a final inspection has been completed and a Certificate of Occupancy has been issued, if applicable, by the Building Department (Section 305, Uniform Building Code).



I hereby acknowledge that I have read this application and the information is correct; I agree to comply with any and all codes, ordinances, laws, regulations or restrictions which apply to the project. I understand that failure to comply shall result in legal action, which may include but not necessarily be limited to non-use of the building(s).

Applicant Signature Kate Skellern Spr Bill Grace Date 11-10-05  
 Department Approval NA Uishi Magan Date 11-23-05

Additional water and/or sewer tap fee(s) are required: YES <input checked="" type="checkbox"/> NO <input type="checkbox"/> W/O No. <u>PD @ OMSD</u>	Date <u>11/23/05</u>
Utility Accounting <u>(Signature)</u>	

VALID FOR SIX MONTHS FROM DATE OF ISSUANCE (Section 2.2.C.1 Grand Junction Zoning & Development Code)  
 (White: Planning) (Yellow: Customer) (Pink: Building Department) (Goldenrod: Utility Accounting)

*David D...  
11-23-05*

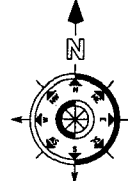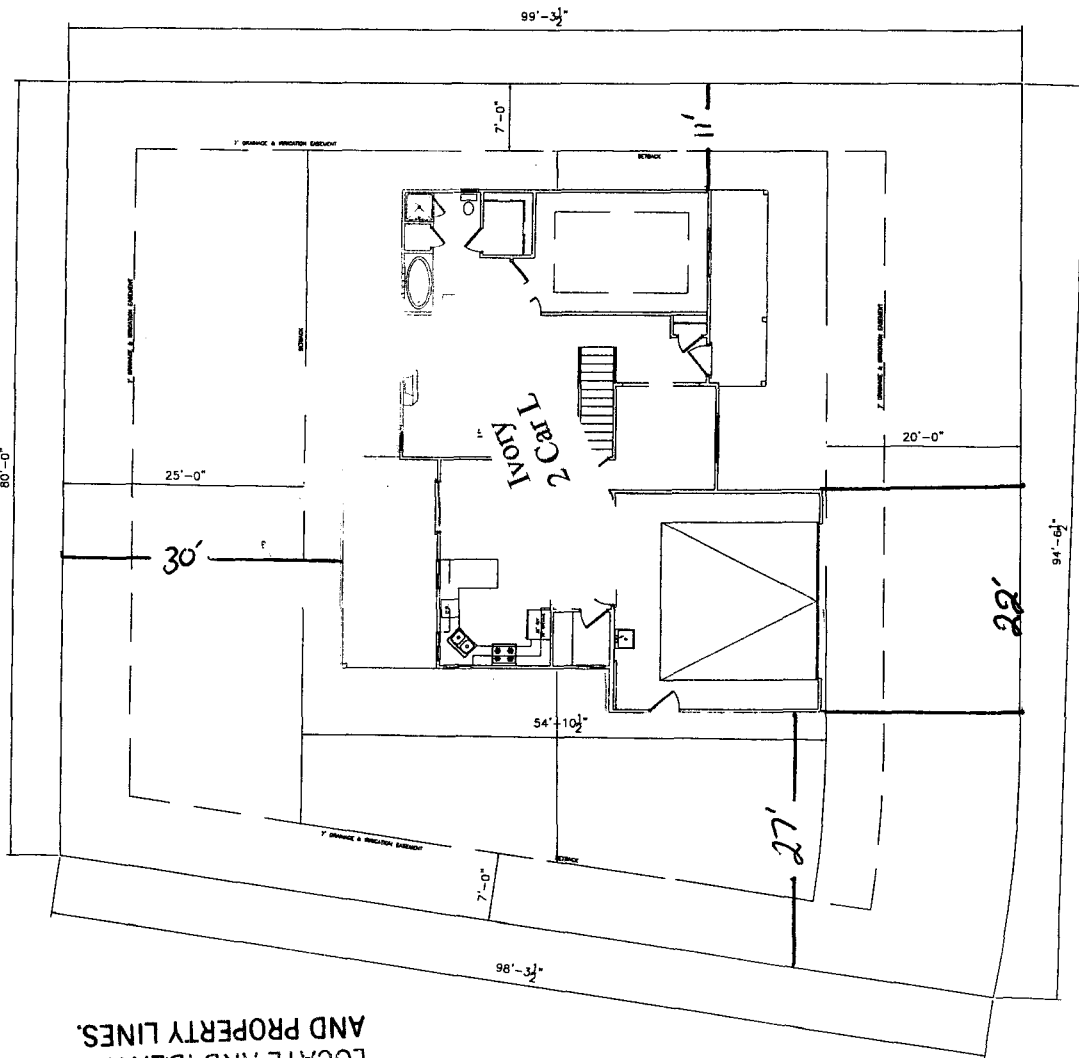

**NOTES:**  
 1. IT IS THE RESPONSIBILITY OF THE BUILDER OR OWNER TO VERIFY ALL DETAILS AND DIMENSIONS PRIOR TO CONSTRUCTION.  
 2. USE OF THIS PLAN CONSTITUTES BUILDER AND OR HOME OWNERS ACCEPTANCE OF THESE TERMS.  
 3. ALL DIMENSIONS ARE TO EDGE OF FOUNDATION UNLESS OTHERWISE NOTED.  
 4. BUILDER AND OR OWNER TO VERIFY ALL SETBACKS AND EASEMENTS.  
 5. THIS PLAN HAS NOT BEEN ENGINEERED BY ARCHITECT. SEE SEPARATE DRAWINGS BY OTHERS FOR ENGINEERING DATA.

**NOTE:**  
 GRADE MUST SLOPE AWAY FROM HOUSE 6" OF FALL IN THE FIRST 10' OF DISTANCE PER LOCAL BUILDING CODE.

**NOTE:**  
 DIMENSION LINES ARE PULLED FROM EDGE OF BRICK LEDGE. IF NO BRICK LEDGE EXISTS, DIMENSIONS WILL BE FROM EDGE OF FOUNDATION.

**NOTE:**  
 BUILDER TO VERIFY ALL SETBACK AND EASEMENT ENCROACHMENTS PRIOR TO CONSTRUCTION

SITE PLAN INFORMATION	
SUBDIVISION NAME	UNAWEEP HEIGHTS
FILING NUMBER	4
LOT NUMBER	5
BLOCK NUMBER	3
STREET ADDRESS	?
COUNTY	MESA
GARAGE SQ. FT.	?
COVERED ENTRY SQ. FT.	?
COVERED PATIO SQ. FT.	?
LIVING SQ. FT.	?
LOT SIZE	8691 SF
T.O.F.	?
SETBACKS USED	FRONT 20'
	SIDES 7'
	REAR 25'

**SCALE: 1"=20'-0"**

ACCEPTED  
 ANY CHECK OF SETBACKS MUST BE APPROVED BY THE CITY PLANNING DEPARTMENT TO PROPERTY LOCATE AND IDENTIFY EASEMENTS AND PROPERTY LINES.

*281 Snyder Ct*