

FEE \$ 18.00
 TCP \$ 1500.00
 SIF \$ 292.00

PLANNING CLEARANCE
 (Single Family Residential and Accessory Structures)
Community Development Department

BLDG PERMIT NO. _____

Building Address 290 Snyder Creek Ct
 Parent Parcel No. 2943-301-00-166
 Subdivision Unawep Heights
 Filing 4 Block 4 Lot 1

No. of Existing Bldgs 0 No. Proposed 1
 Sq. Ft. of Existing Bldgs 0 Sq. Ft. Proposed 2515
 Sq. Ft. of Lot / Parcel 9695
 Sq. Ft. Coverage of Lot by Structures & Impervious Surface (Total Existing & Proposed) 2900
 Height of Proposed Structure _____

OWNER INFORMATION:

Name Pinnacle Homes Inc
 Address 3111 F Rd
 City / State / Zip Grand Jct Co 81604

DESCRIPTION OF WORK & INTENDED USE:
 New Single Family Home (*check type below)
 Interior Remodel Addition
 Other (please specify): _____

APPLICANT INFORMATION:

Name Pinnacle Homes, Inc
 Address 3111 F Rd
 City / State / Zip Grand Jct Co 81604
 Telephone (970) 241-6646

*TYPE OF HOME PROPOSED:
 Site Built Manufactured Home (UBC)
 Manufactured Home (HUD)
 Other (please specify): _____

NOTES: _____

REQUIRED: One plot plan, on 8 1/2" x 11" paper, showing all existing & proposed structure location(s), parking, setbacks to all property lines, ingress/egress to the property, driveway location & width & all easements & rights-of-way which abut the parcel.

THIS SECTION TO BE COMPLETED BY COMMUNITY DEVELOPMENT DEPARTMENT STAFF	
ZONE <u>RSF-4</u>	Maximum coverage of lot by structures <u>50%</u>
SETBACKS: Front <u>20'</u> from property line (PL)	Permanent Foundation Required: YES <input checked="" type="checkbox"/> NO _____
Side <u>7'</u> from PL Rear <u>25'</u> from PL	Parking Requirement <u>2</u>
Maximum Height of Structure(s) <u>35'</u>	Special Conditions _____
Voting District <u>E</u> Driveway Location Approval <u>TRAD</u> (Engineer's Initials)	_____

Modifications to this Planning Clearance must be approved, in writing, by the Community Development Department. The structure authorized by this application cannot be occupied until a final inspection has been completed and a Certificate of Occupancy has been issued, if applicable, by the Building Department (Section 305, Uniform Building Code).

I hereby acknowledge that I have read this application and the information is correct; I agree to comply with any and all codes, ordinances, laws, regulations or restrictions which apply to the project. I understand that failure to comply shall result in legal action, which may include but not necessarily be limited to non-use of the building(s).

Applicant Signature Not Skelton for Bill Grace Date 11-10-05

Department Approval NA / [Signature] Date 11-22-05



Additional water and/or sewer tap fee(s) are required: YES <input checked="" type="checkbox"/> NO _____	W/O No. <u>Per OMSD</u>
Utility Accounting <u>D Overholt</u>	Date <u>11/22/05</u>

VALID FOR SIX MONTHS FROM DATE OF ISSUANCE (Section 2.2.C.1 Grand Junction Zoning & Development Code)
 (White: Planning) (Yellow: Customer) (Pink: Building Department) (Goldenrod: Utility Accounting)

ARRASTA LANE

ACCEPTED NA *Ughu* *11-22-11*
 ANY CHANGE OF SETBACKS MUST BE APPROVED BY THE CITY PLANNING DEPARTMENT. THE APPLICANT'S RESPONSIBILITY TO PROPERLY LOCATE AND IDENTIFY EASEMENTS AND PROPERTY LINES. SNYDER CREEK DRIVE

Final OK
FATD
11-22-11

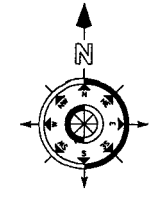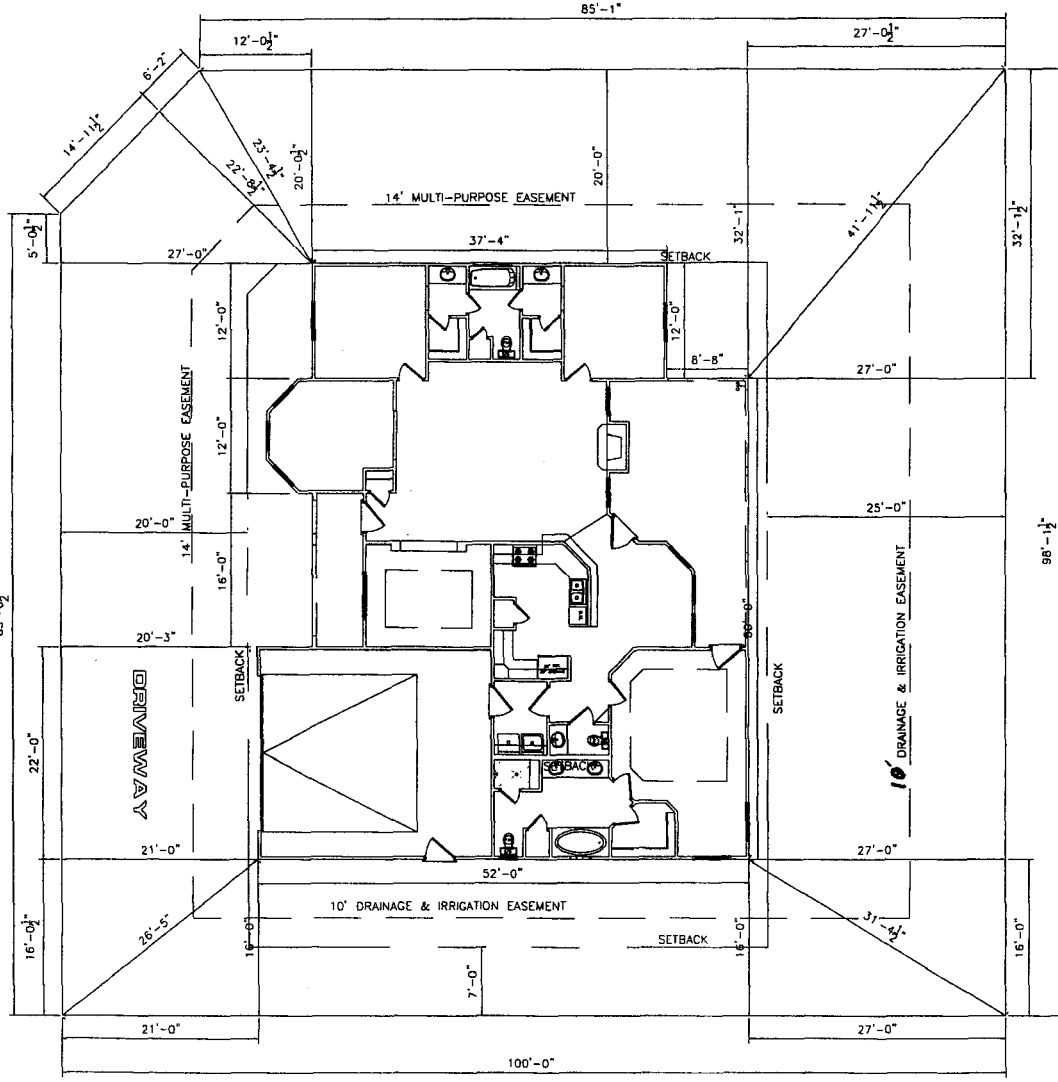

NOTE:
 1. IT IS THE RESPONSIBILITY OF THE BUILDER OR OWNER TO VERIFY ALL DETAILS AND DIMENSIONS PRIOR TO CONSTRUCTION.
 2. USE OF THIS PLAN CONSTITUTES BUILDER AND OR HOME OWNERS ACCEPTANCE OF THESE TERMS.
 3. ALL DIMENSIONS ARE TO EDGE OF FOUNDATION UNLESS OTHER WISE NOTED.
 4. BUILDER AND OR OWNER TO VERIFY ALL SETBACKS AND EASEMENTS.
 5. THIS PLAN HAS NOT BEEN ENGINEERED BY AUTOCAD. SEE SEPARATE DRAWINGS BY OTHERS FOR ENGINEERING DATA.

NOTE:
 GRADE MUST SLOPE AWAY FROM HOUSE 6" OF FALL IN THE FIRST 10' OF DISTANCE PER LOCAL BUILDING CODE.

NOTE:
 DIMENSION LINES ARE PULLED FROM EDGE OF BRICK LEDGE. IF NO BRICK LEDGE EXISTS, DIMENSIONS WILL BE FROM EDGE OF FOUNDATION.

NOTE:
 BUILDER TO VERIFY ALL SETBACK AND EASEMENT ENCROACHMENTS PRIOR TO CONSTRUCTION

SITE PLAN INFORMATION	
SUBDIVISION NAME	UNAWEEP HEIGHTS
FILING NUMBER	4
LOT NUMBER	1
BLOCK NUMBER	4
STREET ADDRESS	? SNYDER CREEK CT.
COUNTY	MESA
GARAGE SQ. FT.	543 SF
COVERED ENTRY SQ. FT.	85 SF
COVERED PATIO SQ. FT.	300 SF
LIVING SQ. FT.	1972 SF
LOT SIZE	9895 SF
T.O.F.	MIN.-4687-MAX.-4669
SETBACKS USED	FRONT 20' SIDES 7' REAR 25'

SCALE: 1"=20'-0"