

FEE \$ 10.00
 TCP \$ 1500.00
 SIF \$ 292.00

PLANNING CLEARANCE
 (Single Family Residential and Accessory Structures)
Community Development Department

BLDG PERMIT NO. _____



Building Address 2931 SYLVIA LANE
 Parcel No. 2943-053-77-019
 Subdivision FORREST ESTATES
 Filing 1 Block 1 Lot 19

No. of Existing Bldgs 0 Proposed 1
 Sq. Ft. of Existing Bldgs 0 Proposed 1726
 Sq. Ft. of Lot / Parcel 6930
 Sq. Ft. Coverage of Lot by Structures & Impervious Surface (Total Existing & Proposed) 3715

OWNER INFORMATION:

Name SKELTON CONSTRUCTION INC
 Address P.O. Box 4247
 City / State / Zip G.D. CO. 81502

DESCRIPTION OF WORK & INTENDED USE:

New Single Family Home (*check type below)
 Interior Remodel Addition
 Other (please specify): _____

APPLICANT INFORMATION:

Name SKELTON CONST. INC
 Address PO Box 4247
 City / State / Zip G.D. CO 81502
 Telephone 245-9008

***TYPE OF HOME PROPOSED:**

Site Built Manufactured Home (UBC)
 Manufactured Home (HUD)
 Other (please specify): _____

NOTES: _____

REQUIRED: One plot plan, on 8 1/2" x 11" paper, showing all existing & proposed structure location(s), parking, setbacks to all property lines, ingress/egress to the property, driveway location & width & all easements & rights-of-way which abut the parcel.

THIS SECTION TO BE COMPLETED BY COMMUNITY DEVELOPMENT DEPARTMENT STAFF	
ZONE <u>RMF-5</u>	Maximum coverage of lot by structures <u>60%</u>
SETBACKS: Front <u>20'</u> from property line (PL)	Permanent Foundation Required: YES <u>X</u> NO _____
Side <u>5'</u> from PL Rear <u>25'</u> from PL	Parking Requirement <u>2</u>
Maximum Height of Structure(s) <u>35'</u>	Special Conditions _____
Voting District <u>D</u>	Driveway Location Approval <u>ML</u> (Engineer's Initials)

Modifications to this Planning Clearance must be approved, in writing, by the Community Development Department. The structure authorized by this application cannot be occupied until a final inspection has been completed and a Certificate of Occupancy has been issued, if applicable, by the Building Department (Section 305, Uniform Building Code).


I hereby acknowledge that I have read this application and the information is correct; I agree to comply with any and all codes, ordinances, laws, regulations or restrictions which apply to the project. I understand that failure to comply shall result in legal action, which may include but not necessarily be limited to non-use of the building(s).

Applicant Signature Jim Sheeran Date 6-08-05

Department Approval Ray Hall Date 7/1/05

Additional water and/or sewer tap fee(s) are required: <input checked="" type="checkbox"/> YES <input type="checkbox"/> NO	W/O No. <u>18212</u>
Utility Accounting <u>CM Cole</u>	Date <u>7/1/05</u>

7/1/05
 ACCEPTED *C. J. Hall*
 ANY CHANGE OF SETBACKS MUST BE APPROVED BY THE CITY PLANNING DEPT. IT IS THE APPLICANT'S RESPONSIBILITY TO PROPERLY LOCATE AND IDENTIFY EASEMENTS AND PROPERTY LINES.

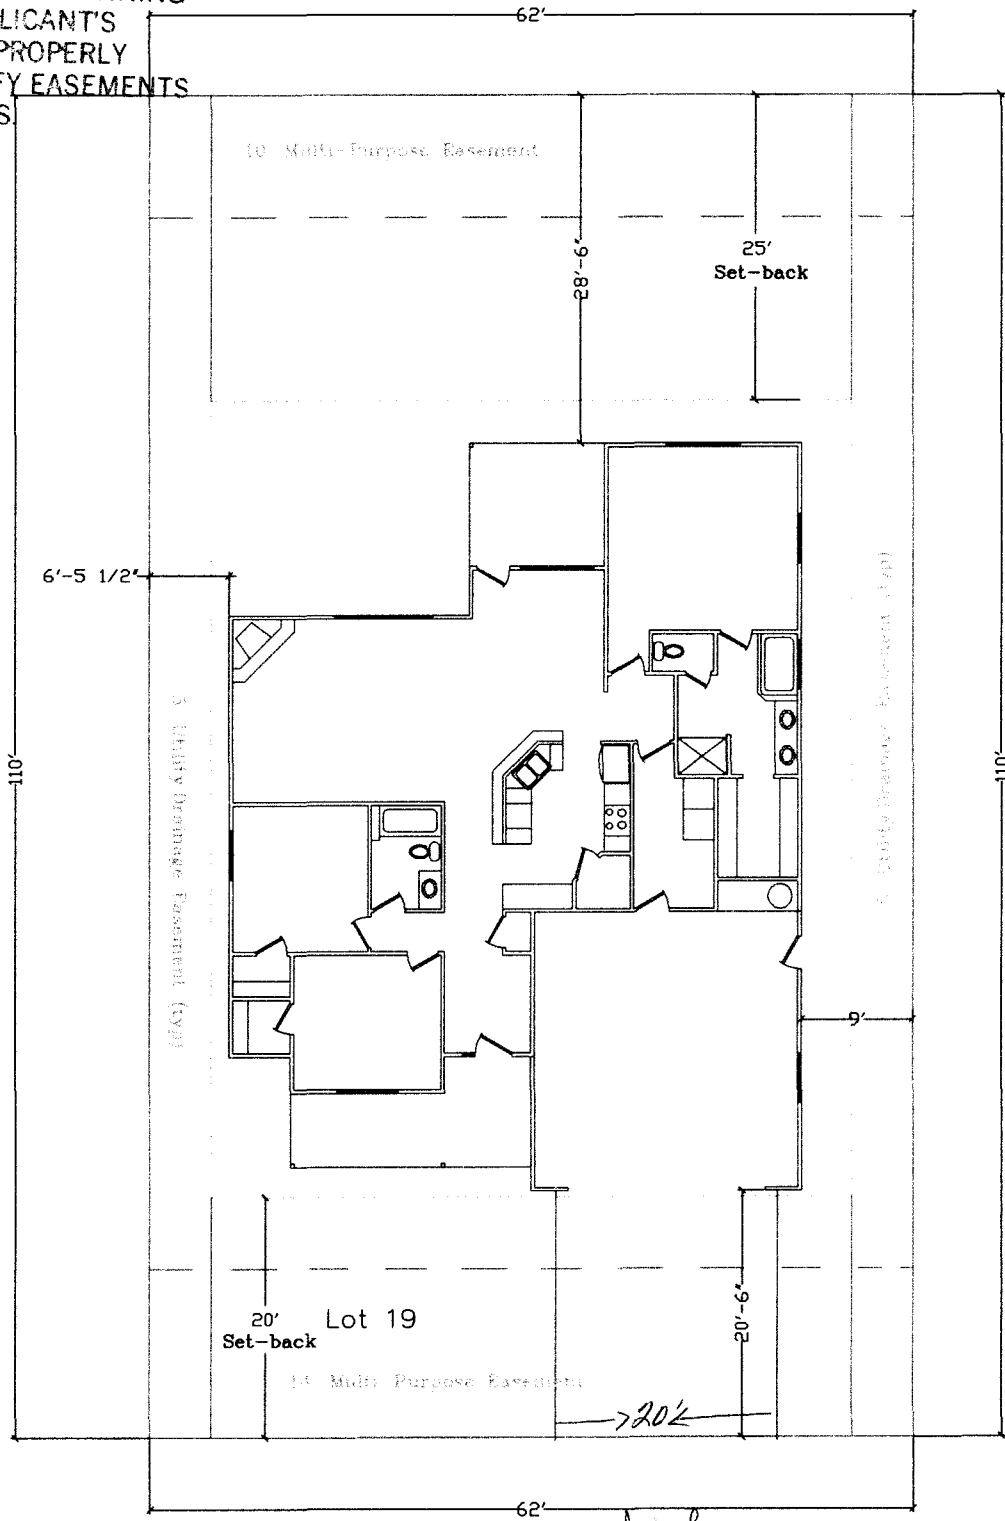

drive on way 6/13/05

2931 Sylvia Lane

