

FEE \$	10.00
TCP \$	1500.00
SIF \$	0

PLANNING CLEARANCE
 (Single Family Residential and Accessory Structures)
Community Development Department

BLDG PERMIT NO. _____

Building Address 2943 Trinity Peaks Way
 Parcel No. 2943-053-79-009
 Subdivision Summit View Estate
 Filing 1 Block 2 Lot 9

No. of Existing Bldgs 0 No. Proposed 1
 Sq. Ft. of Existing Bldgs 0 Sq. Ft. Proposed 1840
 Sq. Ft. of Lot / Parcel 16656
 Sq. Ft. Coverage of Lot by Structures & Impervious Surface (Total Existing & Proposed) 2240
 Height of Proposed Structure _____

OWNER INFORMATION:

Name Zeck Homes
 Address 1950 Hwy 6 #50
 City / State / Zip Fruita, CO 81521

DESCRIPTION OF WORK & INTENDED USE:
 New Single Family Home (*check type below)
 Interior Remodel Addition
 Other (please specify): _____

APPLICANT INFORMATION:

Name Zeck Homes
 Address 1950 Hwy 6 #50
 City / State / Zip Fruita, CO 81521
 Telephone 858-0178

*TYPE OF HOME PROPOSED:
 Site Built Manufactured Home (UBC)
 Manufactured Home (HUD)
 Other (please specify): _____

NOTES: _____

REQUIRED: One plot plan, on 8 1/2" x 11" paper, showing all existing & proposed structure location(s), parking, setbacks to all property lines, ingress/egress to the property, driveway location & width & all easements & rights-of-way which abut the parcel.

THIS SECTION TO BE COMPLETED BY COMMUNITY DEVELOPMENT DEPARTMENT STAFF			
ZONE <u>RMF-5</u>	Maximum coverage of lot by structures <u>7090</u>		
SETBACKS: Front <u>20'</u> from property line (PL)	Permanent Foundation Required: YES <u>X</u> NO _____		
Side <u>5'</u> from PL Rear <u>10'</u> from PL	Parking Requirement <u>2</u>		
Maximum Height of Structure(s) <u>35'</u>	Special Conditions <u>Bay windows may extend 3' into setback.</u>		
Voting District <u>D</u>	Driveway Location Approval <u>RAH</u> (Engineer's Initials)		


Modifications to this Planning Clearance must be approved, in writing, by the Community Development Department. The structure authorized by this application cannot be occupied until a final inspection has been completed and a Certificate of Occupancy has been issued, if applicable, by the Building Department (Section 305, Uniform Building Code).

I hereby acknowledge that I have read this application and the information is correct; I agree to comply with any and all codes, ordinances, laws, regulations or restrictions which apply to the project. I understand that failure to comply shall result in legal action, which may include but not necessarily be limited to non-use of the building(s).


Applicant Signature [Signature] Date 4/5/05
 Department Approval [Signature] Date 5/3/05

Additional water and/or sewer tap fees are required:	<input checked="" type="checkbox"/> YES	<input type="checkbox"/> NO	W/O No. <u>POB (6/15/0)</u>
Utility Accounting <u>[Signature]</u>	Date <u>5/3/05</u>		

VALID FOR SIX MONTHS FROM DATE OF ISSUANCE (Section 2.2.C.1 Grand Junction Zoning & Development Code)
 (White: Planning) (Yellow: Customer) (Pink: Building Department) (Goldenrod: Utility Accounting)

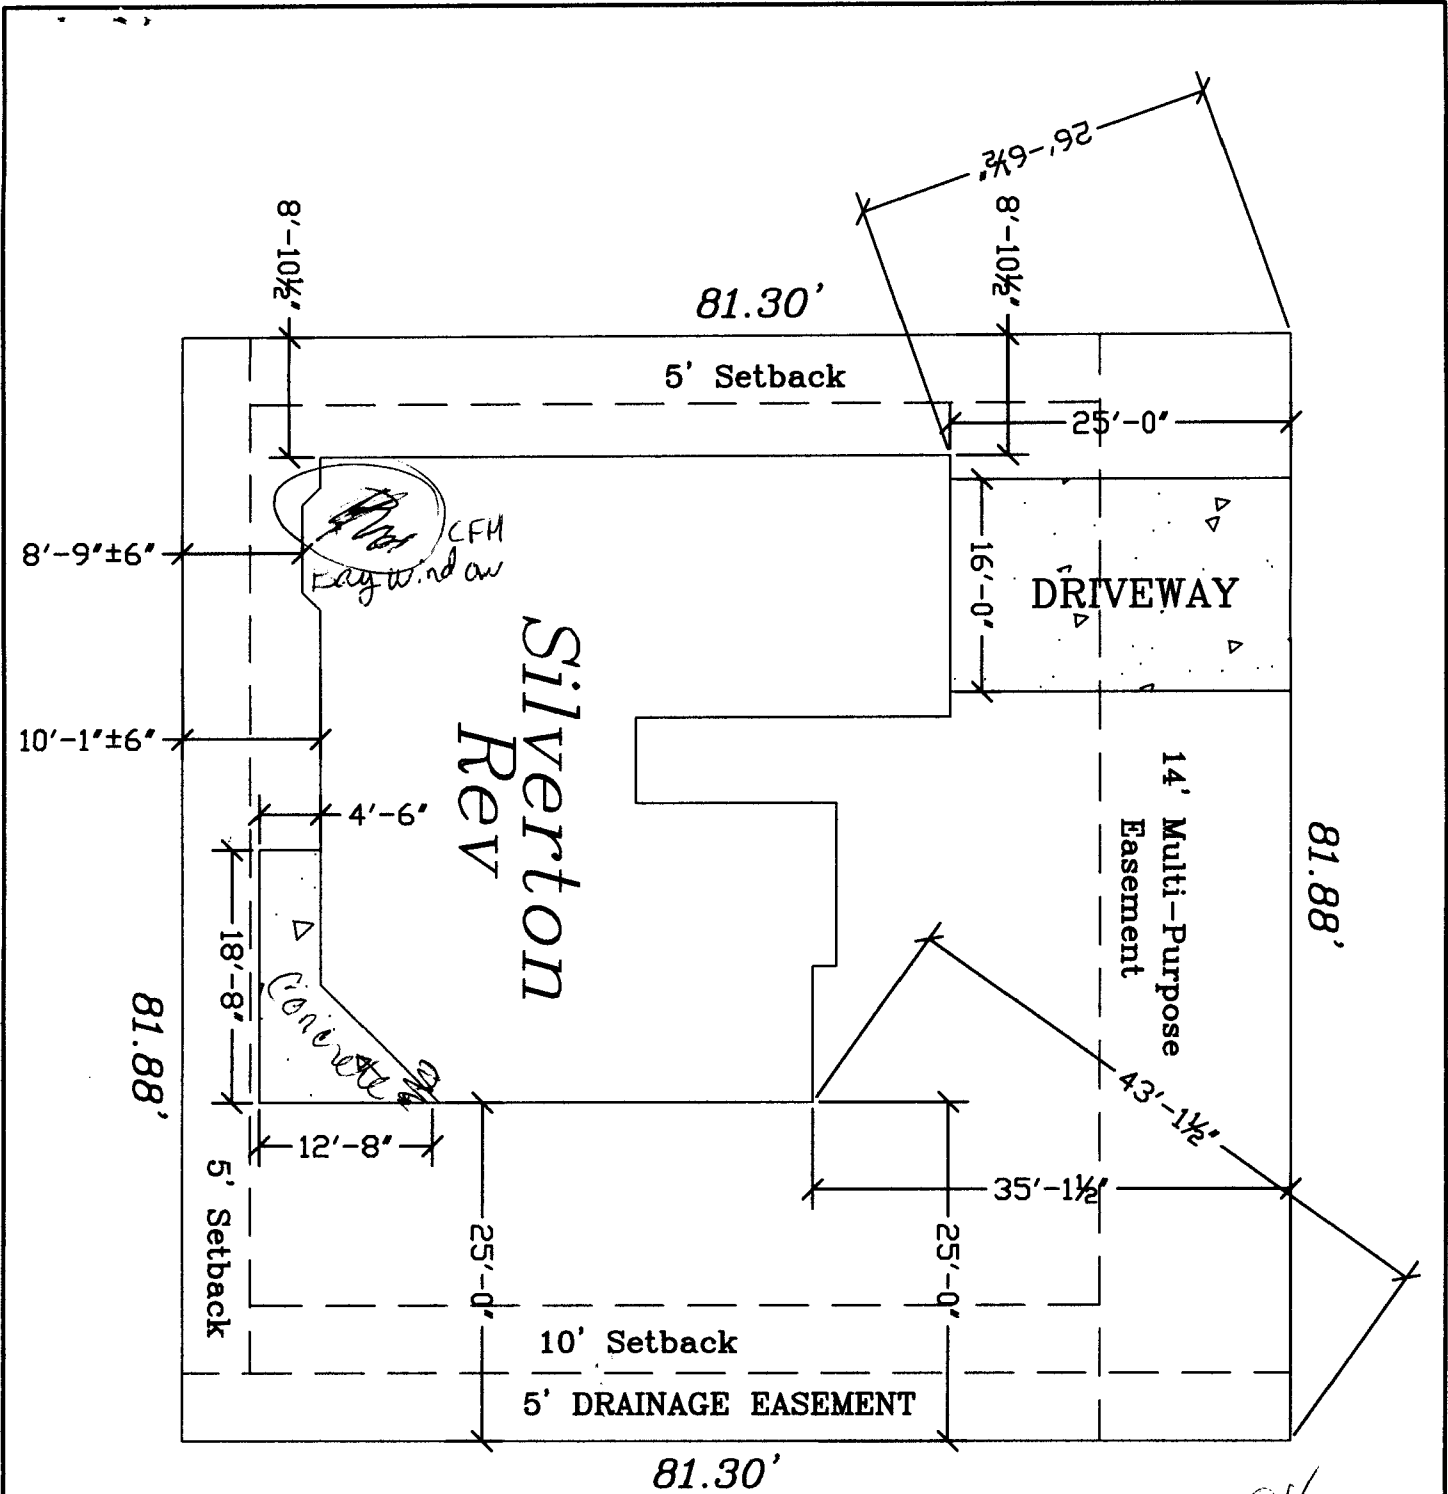

ACCEPTED *C. Faye Hall*
 ANY CHANGE OF SETBACKS MUST BE APPROVED BY THE CITY PLANNING DEPT. IT IS THE APPLICANT'S RESPONSIBILITY TO PROPERLY LOCATE AND IDENTIFY EASEMENTS AND PROPERTY LINES.

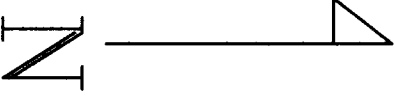

*Done OK
 Rick Davis
 4-5-05*