

FEE \$	10.00
TCP \$	1500.00
SIF \$	None

**PLANNING CLEARANCE**  
 (Single Family Residential and Accessory Structures)  
**Community Development Department**

BLDG PERMIT NO. \_\_\_\_\_

Building Address 2946 Trinity Peaks Way No. of Existing Bldgs 0 No. Proposed 1  
 Parcel No. 2943-053-78-010 Sq. Ft. of Existing Bldgs NA Sq. Ft. Proposed 1834  
 Subdivision ~~Lot 10 Block 1 SV Estates~~ Sq. Ft. of Lot / Parcel 6282  
 Filing 1 Block 1 Lot 10 Sq. Ft. Coverage of Lot by Structures & Impervious Surface (Total Existing & Proposed) 2534

**OWNER INFORMATION:**

Name Zeck Homes  
 Address 1950 Hwy 6350  
 City / State / Zip Fruita, CO 81521

**DESCRIPTION OF WORK & INTENDED USE:**

New Single Family Home (\*check type below)  
 Interior Remodel  Addition  
 Other (please specify): \_\_\_\_\_

**APPLICANT INFORMATION:**

Name Zeck Homes  
 Address \_\_\_\_\_  
 City / State / Zip \_\_\_\_\_  
 Telephone 858-0178

**\*TYPE OF HOME PROPOSED:**

Site Built  Manufactured Home (UBC)  
 Manufactured Home (HUD)  
 Other (please specify): \_\_\_\_\_

NOTES: \_\_\_\_\_

**REQUIRED: One plot plan, on 8 1/2" x 11" paper, showing all existing & proposed structure location(s), parking, setbacks to all property lines, ingress/egress to the property, driveway location & width & all easements & rights-of-way which abut the parcel.**

<b>THIS SECTION TO BE COMPLETED BY COMMUNITY DEVELOPMENT DEPARTMENT STAFF</b>	
ZONE <u>RMF-8</u>	Maximum coverage of lot by structures <u>70%</u>
SETBACKS: Front <u>20'</u> from property line (PL)	Permanent Foundation Required: YES <input checked="" type="checkbox"/> NO <input type="checkbox"/>
Side <u>5'</u> from PL Rear <u>10'</u> from PL	Parking Requirement <u>2</u>
Maximum Height of Structure(s) <u>35'</u>	Special Conditions _____
Voting District <u>D</u> Driveway Location Approval <u>WR</u> (Engineer's Initials)	

Modifications to this Planning Clearance must be approved, in writing, by the Community Development Department. The structure authorized by this application cannot be occupied until a final inspection has been completed and a Certificate of Occupancy has been issued, if applicable, by the Building Department (Section 305, Uniform Building Code).



I hereby acknowledge that I have read this application and the information is correct; I agree to comply with any and all codes, ordinances, laws, regulations or restrictions which apply to the project. I understand that failure to comply shall result in legal action, which may include but not necessarily be limited to non-use of the building(s).

Applicant Signature Mallea Schief Date 6/1/05  
 Department Approval B. Paulson Date 6/8/05

Additional water and/or sewer tap fee(s) are required:	YES <input checked="" type="checkbox"/>	NO <input type="checkbox"/>	W/O No. <u>CGV</u>
Utility Accounting <u>2</u>	Date <u>6/8/05</u>		

VALID FOR SIX MONTHS FROM DATE OF ISSUANCE (Section 2.2.C.1 Grand Junction Zoning & Development Code)  
 (White: Planning) (Yellow: Customer) (Pink: Building Department) (Goldenrod: Utility Accounting)

Show all easements on the lot

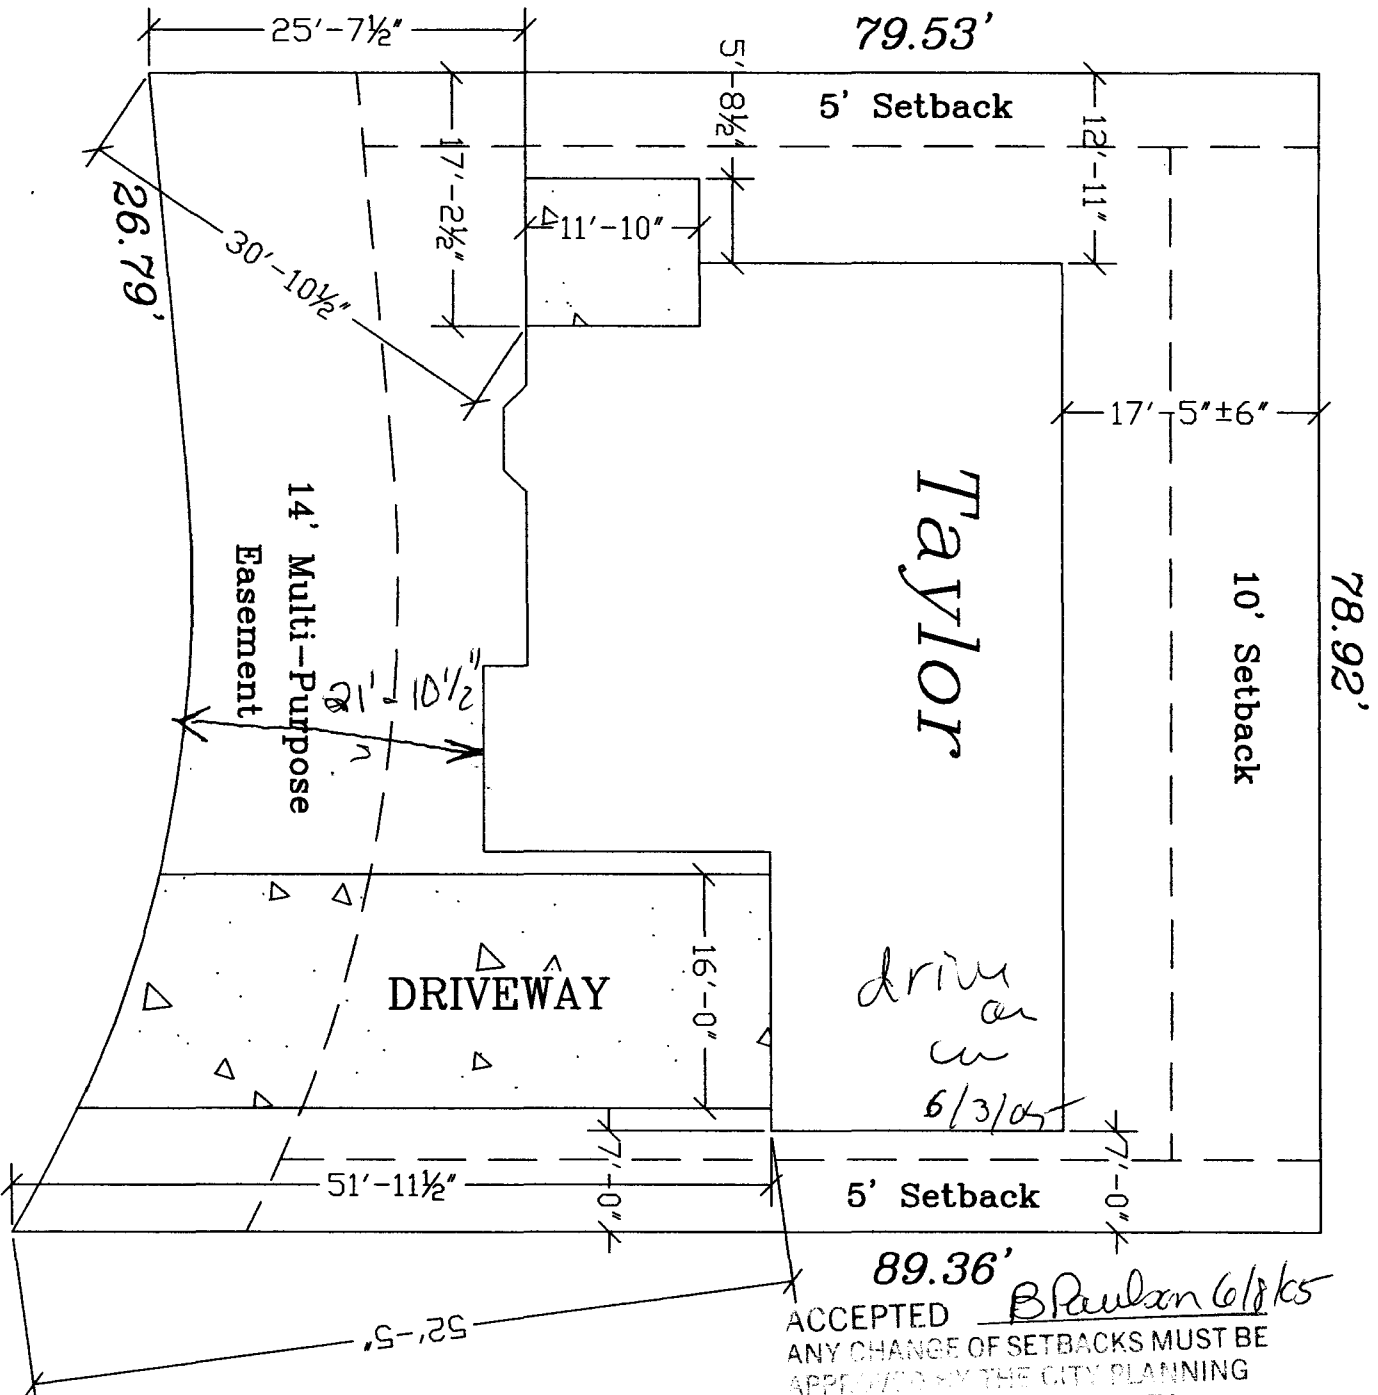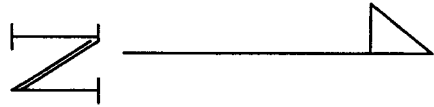

ACCEPTED B Paulson 6/8/05  
 ANY CHANGE OF SETBACKS MUST BE  
 APPROVED BY THE CITY PLANNING  
 DEPT. IT IS THE APPLICANTS  
 RESPONSIBILITY TO PROPERLY  
 LOCATE AND IDENTIFY EASEMENTS  
 AND PROPERTY LINES.