

FEE \$	10.00
TCP \$	0
SIF \$	0

PLANNING CLEARANCE

(Single Family Residential and Accessory Structures)
Community Development Department

BLDG PERMIT NO.

Building Address 731 1/2 24 3/4
 Parcel No. 2701-334-26-009
 Subdivision North Valley
 Filing _____ Block _____ Lot _____

No. of Existing Bldgs 1 No. Proposed 0
 Sq. Ft. of Existing Bldgs 2480 Sq. Ft. Proposed 845
 Sq. Ft. of Lot / Parcel 8,668
 Sq. Ft. Coverage of Lot by Structures & Impervious Surface (Total Existing & Proposed) _____
 Height of Proposed Structure _____

OWNER INFORMATION:

Name Bill Coats
 Address 731 1/2 24 3/4 Rd.
 City / State / Zip G.J. CO, 81505

DESCRIPTION OF WORK & INTENDED USE:

- New Single Family Home (*check type below)
- Interior Remodel Addition
- Other (please specify): 3 Addings

APPLICANT INFORMATION:

Name Bill Coats
 Address 731 1/2 24 3/4 Rd.
 City / State / Zip G.J. CO, 81505
 Telephone (970)-257-1641

***TYPE OF HOME PROPOSED:**

- Site Built Manufactured Home (UBC)
- Manufactured Home (HUD)
- Other (please specify): _____

NOTES: _____

REQUIRED: One plot plan, on 8 1/2" x 11" paper, showing all existing & proposed structure location(s), parking, setbacks to all property lines, ingress/egress to the property, driveway location & width & all easements & rights-of-way which abut the parcel.

THIS SECTION TO BE COMPLETED BY COMMUNITY DEVELOPMENT DEPARTMENT STAFF

ZONE Rmf-5 Maximum coverage of lot by structures 60%
 SETBACKS: Front 20/25 from property line (PL) Permanent Foundation Required: YES X NO _____
 Side 5/3 from PL Rear 25/5 from PL Parking Requirement 2
 Maximum Height of Structure(s) 35 Special Conditions West Carport must be detached to meet accessory set back
 Voting District _____ Driveway Location Approval _____
(Engineer's Initials)

Modifications to this Planning Clearance must be approved, in writing, by the Community Development Department. The structure authorized by this application cannot be occupied until a final inspection has been completed and a Certificate of Occupancy has been issued, if applicable, by the Building Department (Section 305, Uniform Building Code).

I hereby acknowledge that I have read this application and the information is correct; I agree to comply with any and all codes, ordinances, laws, regulations or restrictions which apply to the project. I understand that failure to comply shall result in legal action, which may include but not necessarily be limited to non-use of the building(s).

Applicant Signature William M. Coats Date 12 Jul 06
 Department Approval Judith A. Peir Date 7/12/2006

Additional water and/or sewer tap fee(s) are required:	YES	NO <input checked="" type="checkbox"/>	W/O No. <u>NO WR or SWE Charge</u>
Utility Accounting <u>[Signature]</u>	Date <u>7/12/06</u>		


VALID FOR SIX MONTHS FROM DATE OF ISSUANCE (Section 2.2.C.1 Grand Junction Zoning & Development Code)
 (White: Planning) (Yellow: Customer) (Pink: Building Department) (Goldenrod: Utility Accounting)

Scale 1"=20'


Found No. 5
Rebar & Cap
P.L.S. 10469

24 3/4 ROAD
N 00°07'32" W 75.00'

Found No. 5
Rebar & Cap
P.L.S. 10469

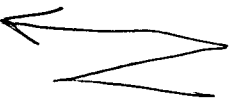

226.44
14.1'

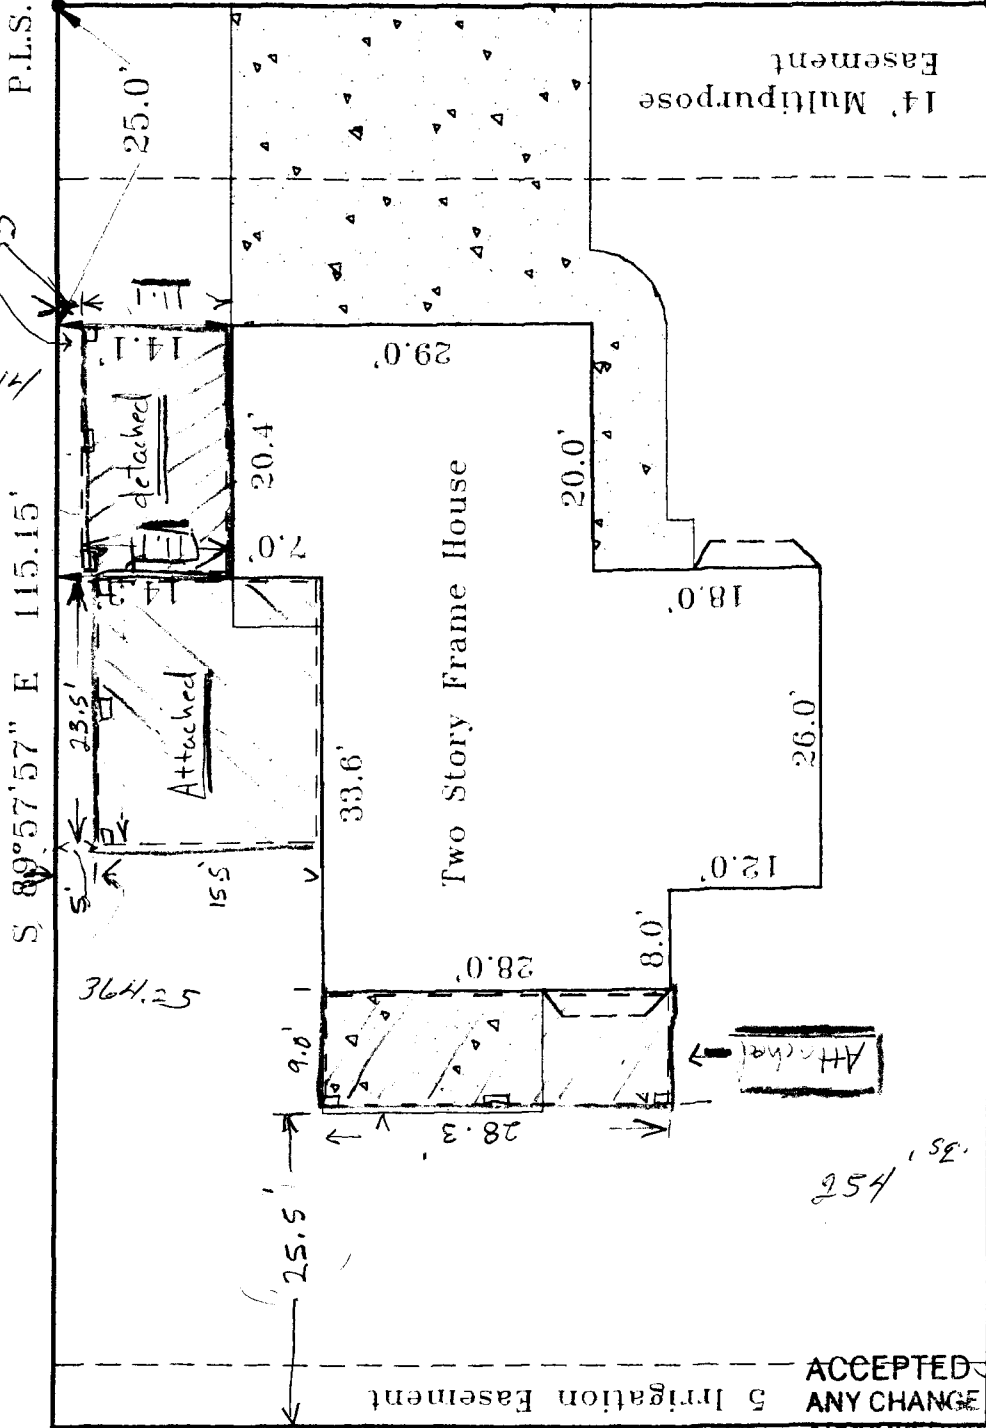

S 89°57'57" E 115.15'

N 89°57'57" W 115.20'

S 00°05'23" E 75.00'

ACCEPTED *Judith A. Pen*
 ANY CHANGE OF SETBACKS MUST BE
 APPROVED BY THE CITY PLANNING
 DEPT. IT IS THE APPLICANT'S
 RESPONSIBILITY TO PROPERLY
 LOCATE AND IDENTIFY EASEMENTS
 AND PROPERTY LINES.

254
35'

364.25

25.0'

25.5'

9.0'

28.3'

28.0'

33.6'

20.4'

29.0'

20.0'

18.0'

26.0'

12.0'

8.0'

14.1'

23.5'

15.5'

364.25

25.5'

9.0'

28.3'

28.0'

20.4'

29.0'

20.0'

18.0'

26.0'

12.0'

8.0'

14.1'

23.5'

15.5'

364.25

25.5'

9.0'

28.3'

28.0'

20.4'

29.0'

20.0'

18.0'

26.0'

12.0'

8.0'

14.1'

23.5'

15.5'

364.25

25.5'

9.0'

28.3'

28.0'

20.4'

29.0'

20.0'

18.0'

26.0'

12.0'

8.0'

14.1'

23.5'

15.5'

364.25

25.5'

9.0'

28.3'

28.0'

20.4'

29.0'

20.0'

18.0'

26.0'

12.0'

8.0'

14.1'

23.5'

15.5'

364.25

25.5'

9.0'

28.3'

28.0'

20.4'