

FEE \$ <u>.10.00</u>
TCP \$
SIF \$

**PLANNING CLEARANCE**  
 (Single Family Residential and Accessory Structures)  
**Community Development Department**

BLDG PERMIT NO. \_\_\_\_\_

Building Address 248 ANIMAS CT  
 Parcel No. 2993-303-74-004  
 Subdivision DURANGO ACRES  
 Filing 1 Block 1 Lot 4

No. of Existing Bldgs HOUSE No. Proposed 0  
 Sq. Ft. of Existing Bldgs 1580 Sq. Ft. Proposed 260  
 Sq. Ft. of Lot / Parcel \_\_\_\_\_  
 Sq. Ft. Coverage of Lot by Structures & Impervious Surface (Total Existing & Proposed) \_\_\_\_\_  
 Height of Proposed Structure \_\_\_\_\_

**OWNER INFORMATION:**

Name Ray Clancy Hopper  
 Address 248 ANIMAS CT  
 City / State / Zip GRD Jct CO 81503

**DESCRIPTION OF WORK & INTENDED USE:**

New Single Family Home (\*check type below)  
 Interior Remodel  
 Addition  
 Other (please specify): PATIO COVER (Detached)

**APPLICANT INFORMATION:**

Name Ray Hopper  
 Address 248 Animas Ct,  
 City / State / Zip GRD Jct CO 81503  
 Telephone 242-3733

**\*TYPE OF HOME PROPOSED:**

Site Built  Manufactured Home (UBC)  
 Manufactured Home (HUD)  
 Other (please specify): \_\_\_\_\_

NOTES: \_\_\_\_\_

**REQUIRED: One plot plan, on 8 1/2" x 11" paper, showing all existing & proposed structure location(s), parking, setbacks to all property lines, ingress/egress to the property, driveway location & width & all easements & rights-of-way which abut the parcel.**

THIS SECTION TO BE COMPLETED BY COMMUNITY DEVELOPMENT DEPARTMENT STAFF	
ZONE <u>RSF-4</u>	Maximum coverage of lot by structures <u>50%</u>
SETBACKS: Front <u>25'</u> from property line (PL)	Permanent Foundation Required: YES _____ NO <u>X</u>
Side <u>3'</u> from PL Rear <u>5'</u> from PL	Parking Requirement <u>2</u>
Maximum Height of Structure(s) <u>35'</u>	Special Conditions <u>patio cover can not be attached to house.</u>
Voting District _____	Driveway Location Approval _____ (Engineer's Initials)


Modifications to this Planning Clearance must be approved, in writing, by the Community Development Department. The structure authorized by this application cannot be occupied until a final inspection has been completed and a Certificate of Occupancy has been issued, if applicable, by the Building Department (Section 305, Uniform Building Code).

I hereby acknowledge that I have read this application and the information is correct; I agree to comply with any and all codes, ordinances, laws, regulations or restrictions which apply to the project. I understand that failure to comply shall result in legal action, which may include but not necessarily be limited to non-use of the building(s).

Applicant Signature Ray D Hopper Date Feb 10, 2006  
 Department Approval Mishi Magan Date 2-10-06

Additional water and/or sewer tap fee(s) are required:	YES	NO <u>X</u>	W/O No. _____
Utility Accounting <u>_____</u>	Date <u>2/10/06</u>		

VALID FOR SIX MONTHS FROM DATE OF ISSUANCE (Section 2.2.C.1 Grand Junction Zoning & Development Code)  
 (White: Planning) (Yellow: Customer) (Pink: Building Department) (Goldenrod: Utility Accounting)

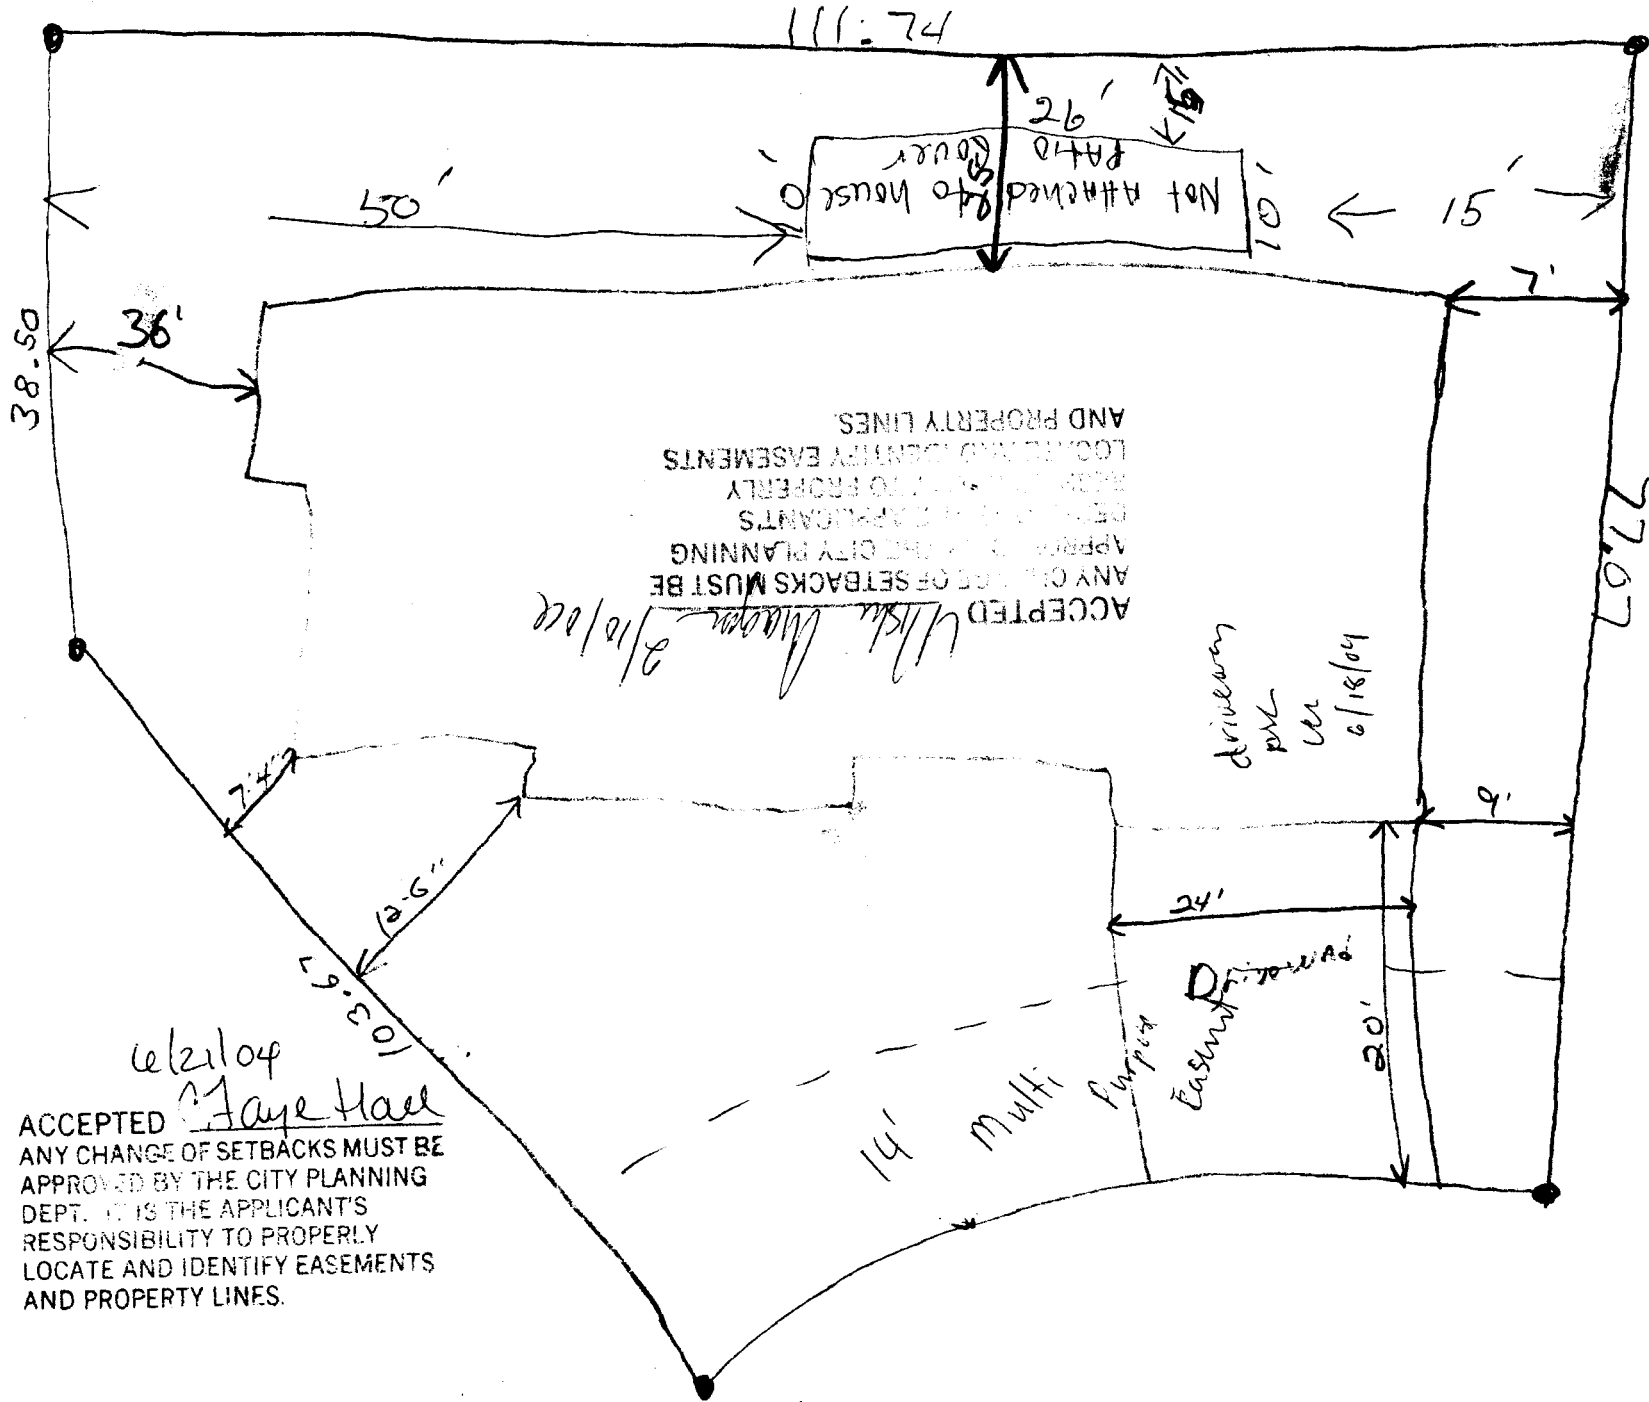

ACCEPTED  
 ANY CHANGE OF SETBACKS MUST BE APPROVED BY THE CITY PLANNING DEPT. IT IS THE APPLICANT'S RESPONSIBILITY TO PROPERLY LOCATE AND IDENTIFY EASEMENTS AND PROPERTY LINES.

10.30  
 12.6  
 14' Multi-Purpose Easement  
 driveway PRK USE 6/18/04  
 24'  
 20'  
 7'  
 15'  
 10'  
 26'  
 50'  
 36'  
 38.50  
 111.74  
 27.07

ACCEPTED  
 ANY CHANGE OF SETBACKS MUST BE APPROVED BY THE CITY PLANNING DEPT. IT IS THE APPLICANT'S RESPONSIBILITY TO PROPERLY LOCATE AND IDENTIFY EASEMENTS AND PROPERTY LINES.

Not Attached to House  
 Not Attached to Garage

driveway  
 PRK  
 USE  
 6/18/04

Multi-Purpose Easement