

FEE \$	10.00
TCP \$	0
SIF \$	0

PLANNING CLEARANCE

(Single Family Residential and Accessory Structures)
Community Development Department

BLDG PERMIT NO.

35173-9410

Building Address 706 Ash Dr. No. of Existing Bldgs 5 No. Proposed 8
 Parcel No. GJ05927 2701-353-19-007 Sq. Ft. of Existing Bldgs 2,200 Sq. Ft. Proposed 2,359
 Subdivision Sunset Sq. Ft. of Lot / Parcel 120' x 170'
 Filing _____ Block 8 Lot 4 Sq. Ft. Coverage of Lot by Structures & Impervious Surface (Total Existing & Proposed) _____
 Height of Proposed Structure _____

OWNER INFORMATION:

Name Ed Wilcox
 Address 706 Ash Dr.
 City / State / Zip GJ / Co / 81506

DESCRIPTION OF WORK & INTENDED USE:
 New Single Family Home (*check type below)
 Interior Remodel Addition
 Other (please specify): Deck + Patio

APPLICANT INFORMATION:

Name Ed Wilcox
 Address 706 Ash Dr.
 City / State / Zip GJ. / Co / 81506
 Telephone 263-4809

***TYPE OF HOME PROPOSED:**
 Site Built Manufactured Home (UBC)
 Manufactured Home (HUD)
 Other (please specify): _____

NOTES: _____

REQUIRED: One plot plan, on 8 1/2" x 11" paper, showing all existing & proposed structure location(s), parking, setbacks to all property lines, ingress/egress to the property, driveway location & width & all easements & rights-of-way which abut the parcel.

THIS SECTION TO BE COMPLETED BY COMMUNITY DEVELOPMENT DEPARTMENT STAFF	
ZONE <u>RSF-4</u>	Maximum coverage of lot by structures <u>50%</u>
SETBACKS: Front <u>20'/25'</u> from property line (PL)	Permanent Foundation Required: YES <input checked="" type="checkbox"/> NO <input type="checkbox"/>
Side <u>7'/3'</u> from PL Rear <u>25'/5'</u> from PL	Parking Requirement <u>2</u>
Maximum Height of Structure(s) <u>35'</u>	Special Conditions _____
Voting District _____	Driveway Location Approval _____ <small>(Engineer's Initials)</small>

Modifications to this Planning Clearance must be approved, in writing, by the Community Development Department. The structure authorized by this application cannot be occupied until a final inspection has been completed and a Certificate of Occupancy has been issued, if applicable, by the Building Department (Section 305, Uniform Building Code).

I hereby acknowledge that I have read this application and the information is correct; I agree to comply with any and all codes, ordinances, laws, regulations or restrictions which apply to the project. I understand that failure to comply shall result in legal action, which may include but not necessarily be limited to non-use of the building(s).

Applicant Signature Ed Wilcox Date 8-28-06

Department Approval Baylen Henderson Date 8-28-06

Additional water and/or sewer tap fee(s) are required:	YES	NO <input checked="" type="checkbox"/>	W/O No. <u>NO SWR NO WTR</u>	Date <u>8/28/06</u>
Utility Accounting <u>9</u>	Change			

VALID FOR SIX MONTHS FROM DATE OF ISSUANCE (Section 2.2.C.1 Grand Junction Zoning & Development Code)
 (White: Planning) (Yellow: Customer) (Pink: Building Department) (Goldenrod: Utility Accounting)

8-28-06


ACCEPTED *Dayleen Henderson*

ANY CHANGE OF SETBACKS MUST BE APPROVED BY THE CITY PLANNING DEPT. IT IS THE APPLICANT'S RESPONSIBILITY TO PROPERLY LOCATE AND IDENTIFY EASEMENTS AND PROPERTY LINES.

5-30-06

ACCEPTED *Dayleen Henderson*

ANY CHANGE OF SETBACKS MUST BE APPROVED BY THE CITY PLANNING DEPT. IT IS THE APPLICANT'S RESPONSIBILITY TO PROPERLY LOCATE AND IDENTIFY EASEMENTS AND PROPERTY LINES.

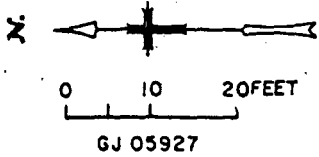

706 ASH DRIVE

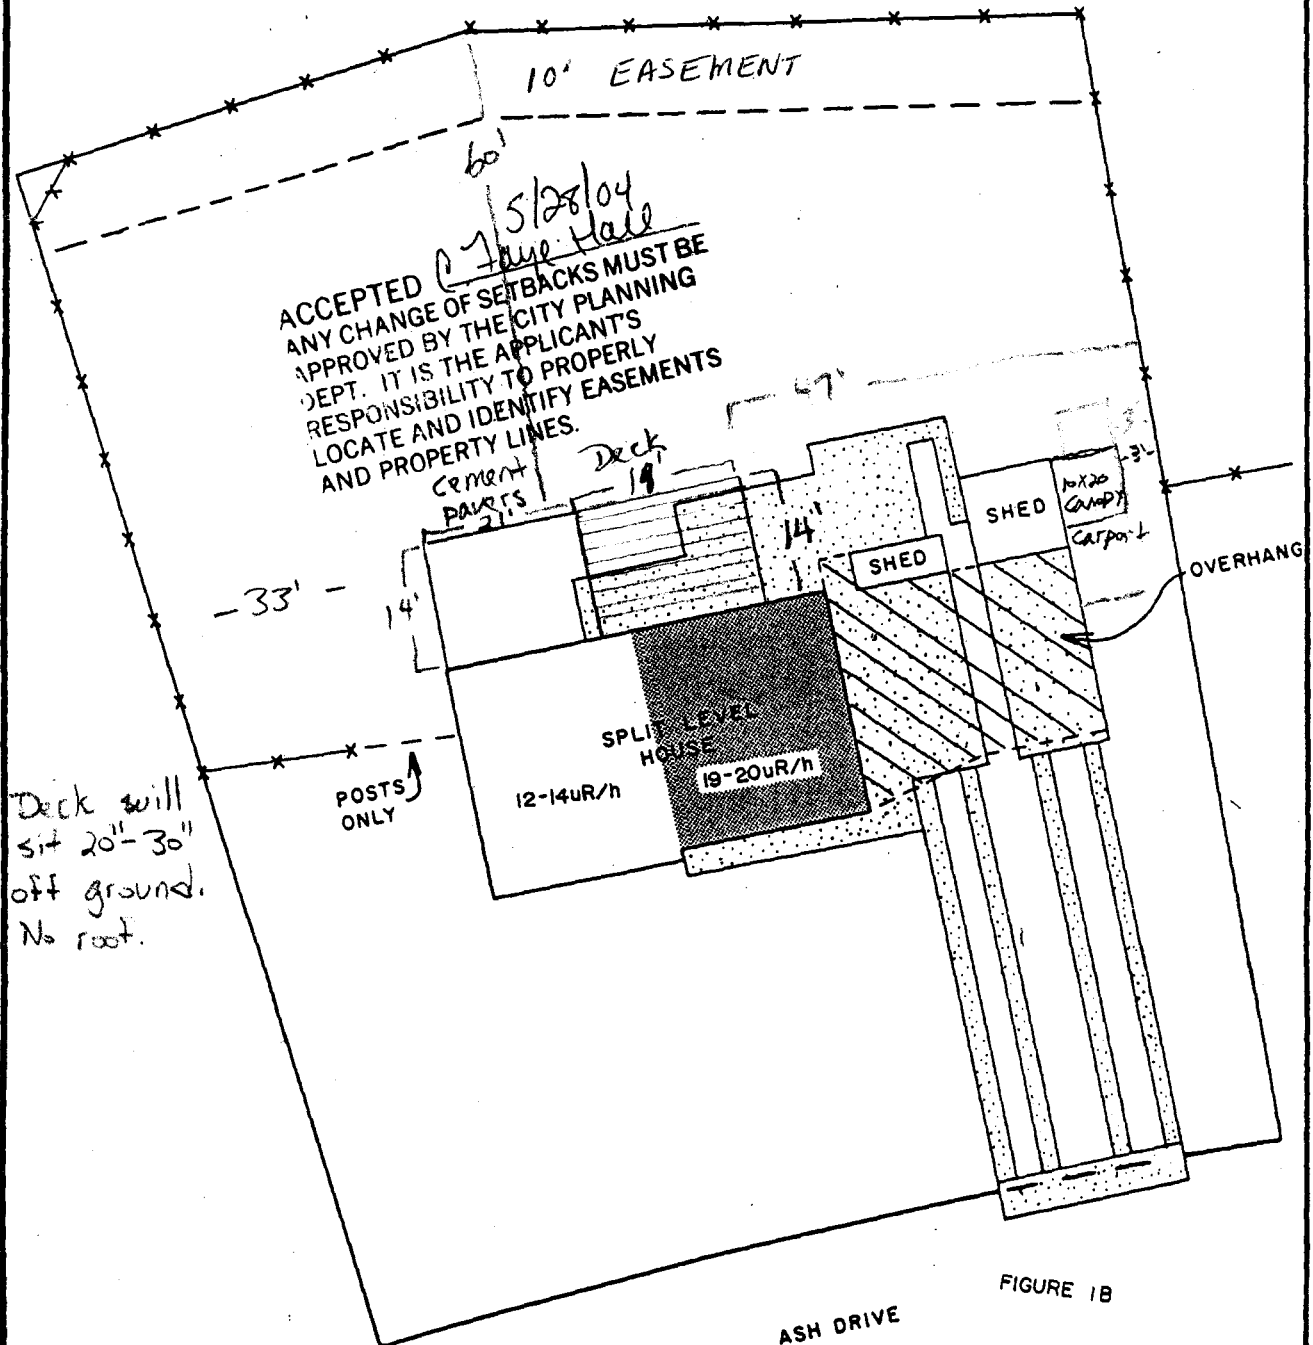


Fig. 1B. Location GJ05927 - 706 Ash Drive, Grand Junction, Colorado 81501.