

FEE \$	10.00
TCP \$	1539.00
SIF \$	400.00

PLANNING CLEARANCE
 (Single Family Residential and Accessory Structures)
Community Development Department

BLDG PERMIT NO. _____

Building Address 3022 Autumn Glenn
 Parcel No. 2943-163-89-005
 Subdivision Autumn Glenn
 Filing 1 Block 3 Lot 5

No. of Existing Bldgs 0 No. Proposed 1
 Sq. Ft. of Existing Bldgs 0 Sq. Ft. Proposed 1501
 Sq. Ft. of Lot / Parcel 5744
 Sq. Ft. Coverage of Lot by Structures & Impervious Surface (Total Existing & Proposed) _____
 Height of Proposed Structure 18'

OWNER INFORMATION:

Name Autumn Glenn
 Address 2785 D Rd
 City / State / Zip GD Co 81501

DESCRIPTION OF WORK & INTENDED USE:

- New Single Family Home (*check type below)
- Interior Remodel Addition
- Other (please specify): _____

APPLICANT INFORMATION:

Name Steve Voytko
 Address 2785 D Rd
 City / State / Zip GD Co 81501
 Telephone 734-2000

***TYPE OF HOME PROPOSED:**

- Site Built Manufactured Home (UBC)
- Manufactured Home (HUD)
- Other (please specify): _____

NOTES: New Home

REQUIRED: One plot plan, on 8 1/2" x 11" paper, showing all existing & proposed structure location(s), parking, setbacks to all property lines, ingress/egress to the property, driveway location & width & all easements & rights-of-way which abut the parcel.

THIS SECTION TO BE COMPLETED BY COMMUNITY DEVELOPMENT DEPARTMENT STAFF	
ZONE <u>RMF-8</u>	Maximum coverage of lot by structures <u>70%</u>
SETBACKS: Front <u>20'</u> from property line (PL)	Permanent Foundation Required: YES <input checked="" type="checkbox"/> NO _____
Side <u>5'</u> from PL Rear <u>10'</u> from PL	Parking Requirement <u>2</u>
Maximum Height of Structure(s) <u>35'</u>	Special Conditions <u>Engineered foundation required</u>
Voting District <u>E</u> Driveway Location Approval <u>TRAD</u> (Engineer's Initials)	<u>Basements NOT permitted, 1/2 basements only by geotech eng recommendation</u>

Modifications to this Planning Clearance must be approved, in writing, by the Community Development Department. The structure authorized by this application cannot be occupied until a final inspection has been completed and a Certificate of Occupancy has been issued, if applicable, by the Building Department (Section 305, Uniform Building Code).

I hereby acknowledge that I have read this application and the information is correct; I agree to comply with any and all codes, ordinances, laws, regulations or restrictions which apply to the project. I understand that failure to comply shall result in legal action, which may include but not necessarily be limited to non-use of the building(s).



Applicant Signature [Signature] Date 4-26-06
 Department Approval NA Daylene Henderson Date 5-11-06

Additional water and/or sewer tap fee(s) are required:	YES <input checked="" type="checkbox"/>	NO <input type="checkbox"/>	W/O No. <u>19083</u>
Utility Accounting	<u>Cate Gelsberg</u>		Date <u>5/11/06</u>

VALID FOR SIX MONTHS FROM DATE OF ISSUANCE (Section 2.2.C.1 Grand Junction Zoning & Development Code)
 (White: Planning) (Yellow: Customer) (Pink: Building Department) (Goldenrod: Utility Accounting)

SITE PLAN

DAVIDSON HOMES
 AUTUMN GLENN SUBDIVISION
 3022 AUTUMN GLENN
 GRAND JUNCTION, MESA COUNTY, COLORADO
 TAX ID 2943-163-89-005 LOT 5 BLOCK 3

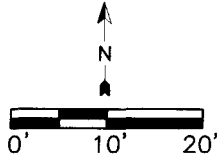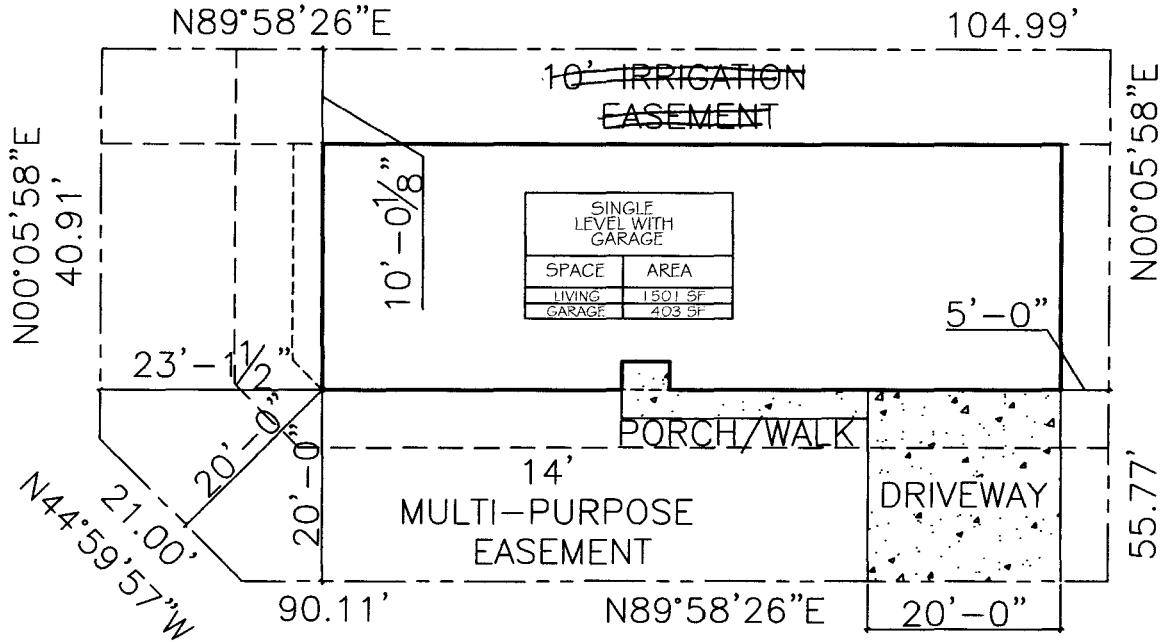

LOT 5
 BLOCK 3
 5744.7 SQ. FT.
 0.13 ACRES

ACCEPTED NA *Gayle Henderson*
 ALL SETBACKS MUST BE
 APPROVED BY THE CITY PLANNING
 DEPARTMENT. THE APPLICANT'S
 RESPONSIBILITY TO PROPERLY
 LOCATE AND IDENTIFY EASEMENTS
 AND PROPERTY LINES.

*Once OK
 RAD
 4-27-06*

RMF - 8		
Minimum Setbacks		
Front	Side	Rear
20	5	10

SITE PLAN

SCALE: 1" = 20'-0"

ATLAS ELECTRIC	4862
TOPS/GAS	2060723
TOPS/MASTER	187254
PRECISION CONSTRUCTION	2060561