FEE\$	10.00
TCP\$	Ø
SIF\$	Ø


## **PLANNING CLEARANCE**

BLDG PERMIT NO.	

(Single Family Residential and Accessory Structures)

## **Community Development Department**

Building Address 2053 BASCLINE BD.	No. of Existing Bldgs No. Proposed 120
Parcel No. 2947-151-52-001	Sq. Ft. of Existing Bldgs Opp Sq. Ft. Proposed
Subdivision INDEPENDANC RESIGN	Sq. Ft. of Lot / Parcel 13, 184
Filing 10 Block Lot 1	Sq. Ft. Coverage of Lot by Structures & Impervious Surface
OWNER INFORMATION:	(Total Existing & Proposed)  Height of Proposed Structure
Name Rex & DAULA KIRKIMAD	DESCRIPTION OF WORK & INTENDED USE:  New Single Family Home (*check type below)
Address 2053 BASCLING RD	Interior Remodel Addition  Other (please specify): STOPOR STA
City/State/Zip GRAND JUNCTION CO. SIL	503
APPLICANT INFORMATION:	*TYPE OF HOME PROPOSED:
Name RX + PAULA KIRK LAND	Site Built Manufactured Home (UBC) Manufactured Home (HUD) Other (please specify):
Address 2053 BASCLINERN	
City/State/Zip GRAND JUNGTION ON BIST	NOTES:
Telephone 970- 245-1468	
	isting & proposed structure location(s), parking, setbacks to all
property lines, ingress/egress to the property, driveway location	i & width & all easements & rights-or-way which abut the parcel.
THIS SECTION TO BE COMPLETED BY COMM	UNITY DEVELOPMENT DEPARTMENT STAFF
THIS SECTION TO BE COMPLETED BY COMM  ZONE	Maximum coverage of lot by structures 3500  Permanent Foundation Required: YESNO
THIS SECTION TO BE COMPLETED BY COMM	Maximum coverage of lot by structures 3500  Permanent Foundation Required: YESNO
THIS SECTION TO BE COMPLETED BY COMM  ZONE	Maximum coverage of lot by structures 3500  Permanent Foundation Required: YESNO
THIS SECTION TO BE COMPLETED BY COMM  ZONE  SETBACKS: Front  Side  Side	Maximum coverage of lot by structures 3500  Permanent Foundation Required: YESNO X  Parking Requirement2
THIS SECTION TO BE COMPLETED BY COMM  ZONE  SETBACKS: Front  Side  Side  Trom PL  Rear  Total Agriculture  Maximum Height of Structure(s)  Driveway  Location Approval  (Engineer's Initials)	Permanent Foundation Required: YESNO X
THIS SECTION TO BE COMPLETED BY COMM  ZONE  SETBACKS: Front  Side  Side	Permanent Foundation Required: YESNO
THIS SECTION TO BE COMPLETED BY COMM  ZONE  SETBACKS: Front  Side  Side	Permanent Foundation Required: YESNO
THIS SECTION TO BE COMPLETED BY COMM  ZONE  SETBACKS: Front  from property line (PL)  Side  from PL  Rear  Driveway  Location Approval  (Engineer's Initials)  Modifications to this Planning Clearance must be approved, is structure authorized by this application cannot be occupied un Occupancy has been issued, if applicable, by the Building Dept.  I hereby acknowledge that I have read this application and the isordinances, laws, regulations or restrictions which apply to the	Permanent Foundation Required: YESNO
THIS SECTION TO BE COMPLETED BY COMM  ZONE  SETBACKS: Front  from property line (PL)  Side  from PL  Rear  Driveway  Voting District  Driveway  Location Approval  (Engineer's Initials)  Modifications to this Planning Clearance must be approved, is structure authorized by this application cannot be occupied un Occupancy has been issued, if applicable, by the Building Depth I hereby acknowledge that I have read this application and the isordinances, laws, regulations or restrictions which apply to the action, which may include but not necessarily be limited to nor	Permanent Foundation Required: YESNO
THIS SECTION TO BE COMPLETED BY COMM  ZONE  SETBACKS: Front  from property line (PL)  Side  from PL  Rear  Driveway  Voting District  Driveway  Location Approval  (Engineer's Initials)  Modifications to this Planning Clearance must be approved, is structure authorized by this application cannot be occupied ur Occupancy has been issued, if applicable, by the Building Deput I hereby acknowledge that I have read this application and the isordinances, laws, regulations or restrictions which apply to the action, which may include but not necessarily be limited to nor Applicant Signature	Permanent Foundation Required: YESNO

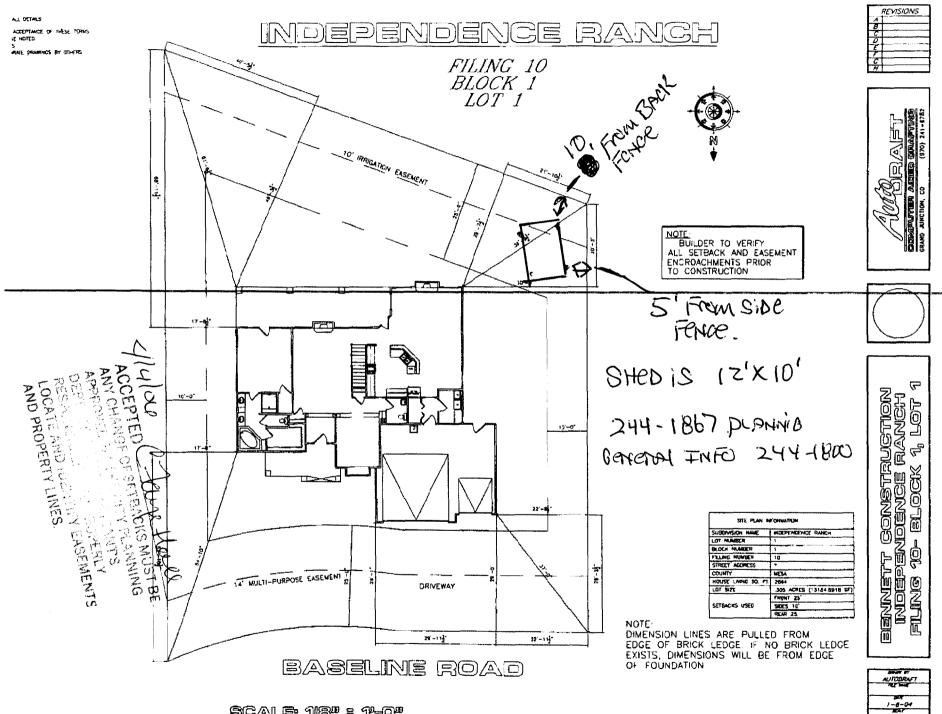

1/8" = 1'-0"

SHEET 5

SCALE: 1/18/0 : 1/2-O#

F:\DAVG FILES\BENNETT\IND. RANCH LOT 1-BLK 1-FILING 10\SITE.dwg. 08/30/2004 03:07:39 PM, \VAMD-2600\HP Lisesbet 1200 Series PCL